RECEIVED
SEP 8 1983
WATER RESOURCES DEPT.
SALEM, OREGON

Miller Spring

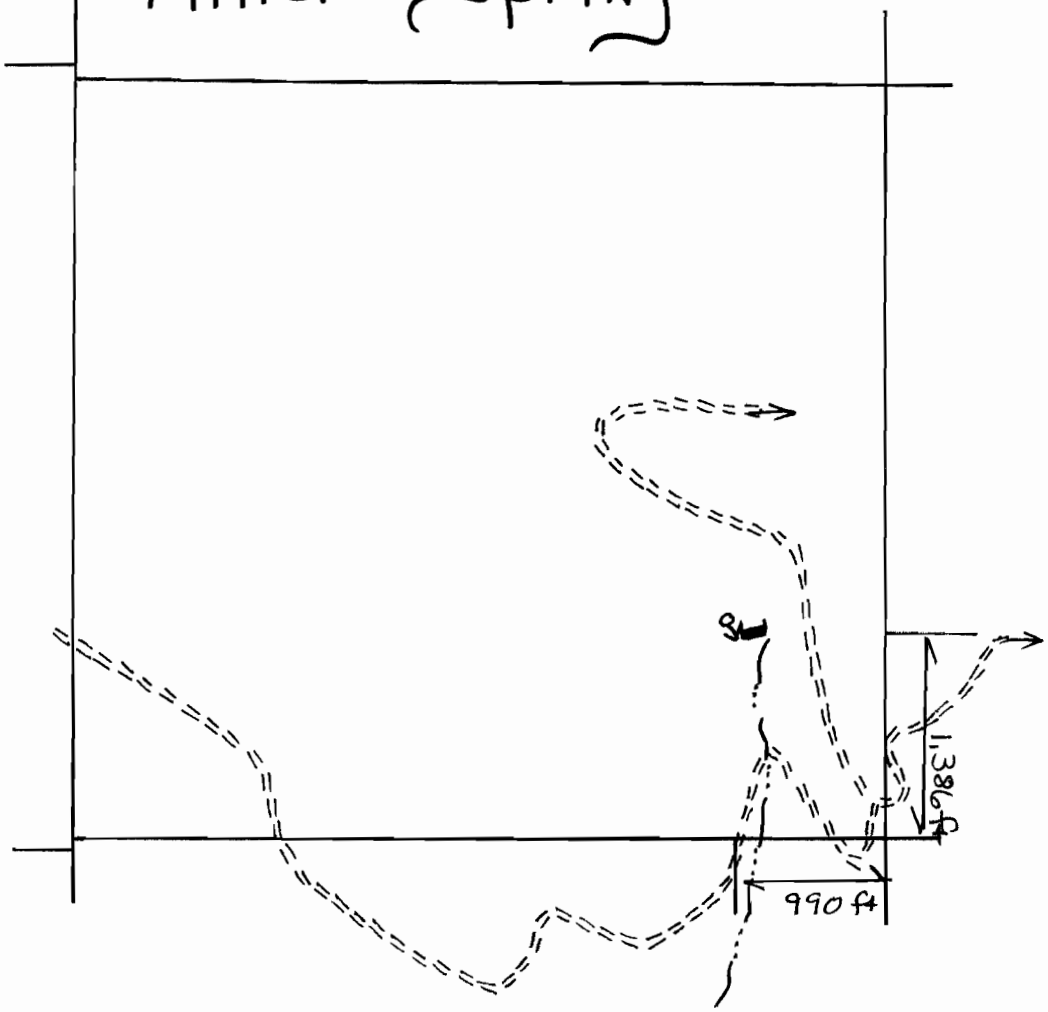

NE¼ SE¼ Sec 19, T. 5S., R. 42E.

Scale:

4 inches = 1 mile

N

Application No. 65950
Permit No. 53143