


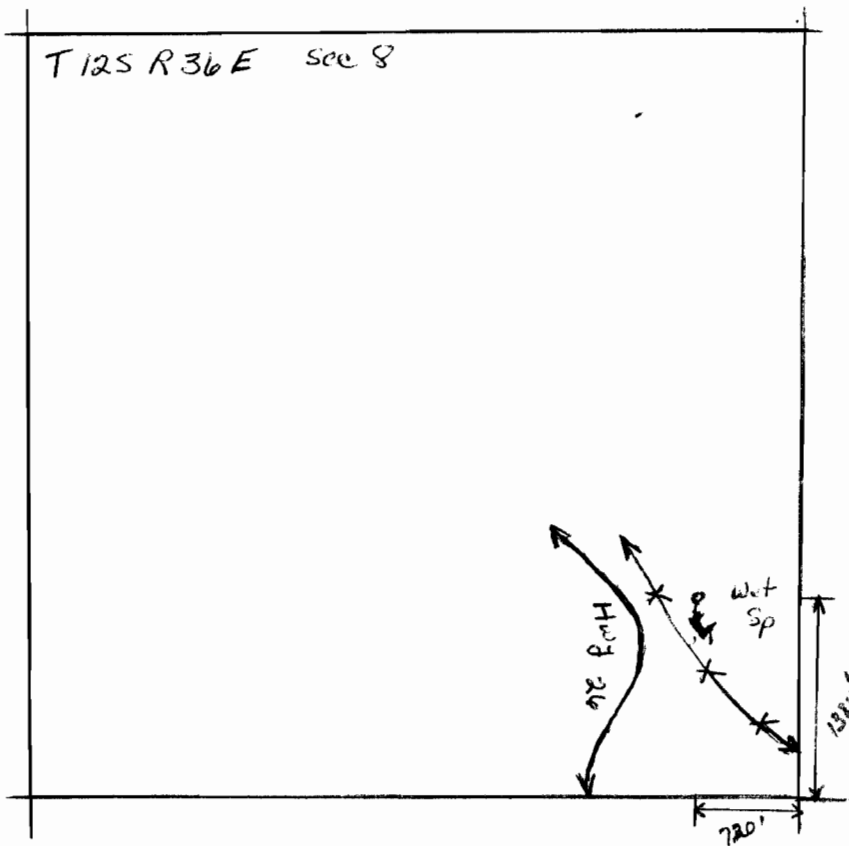

4" = 1 mile



RECEIVED

SEP 14 1983

WATER RESOURCES DEPT.
SALEM, OREGON

Application No. 65918
Permit No. 53152