


RECEIVED

SEP 26 1983

U. S. FOREST SERVICE DEPT.
SALEM, OREGON

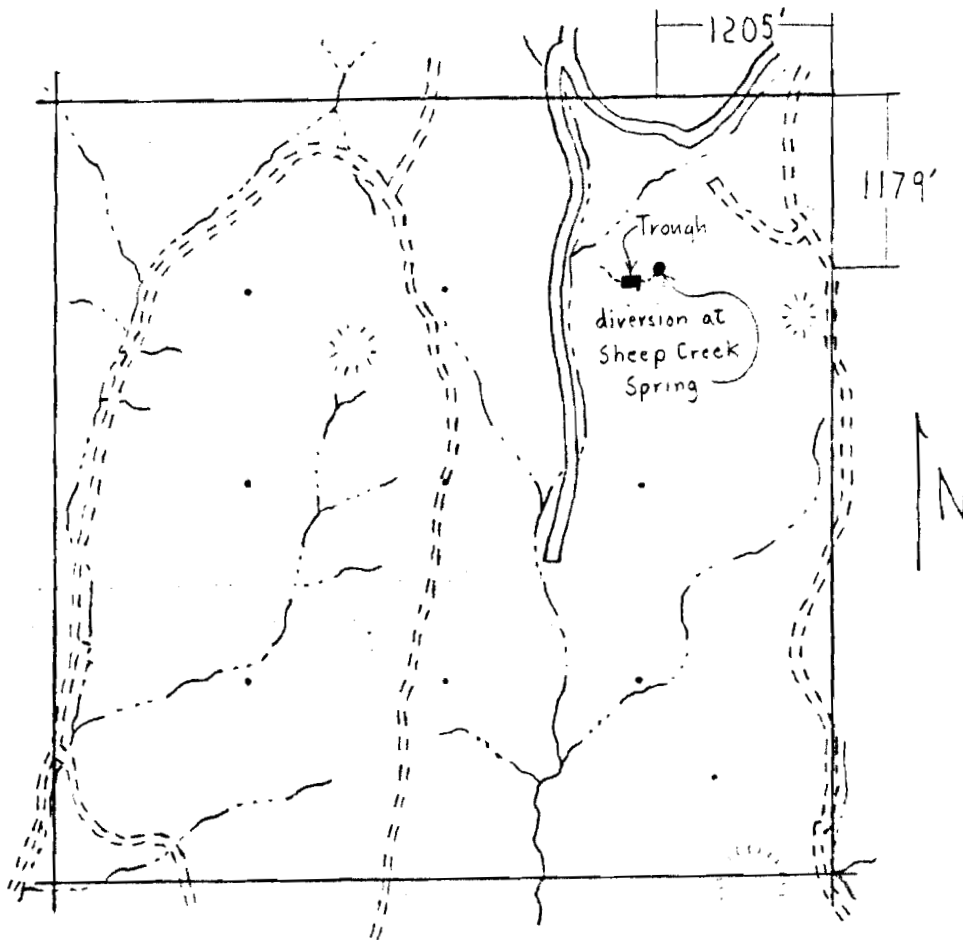

4 inches = 1 mile

T 7 S R 43 E Sec 28

Application No. 66746
Permit No. 53170

USFS # 7-7394