

UNITED STATES
DEPARTMENT OF THE INTERIOR
BUREAU OF LAND MANAGEMENT

WILD HORSE
Spring Res. 3
3568

SECTION


Oregon State Water Filings

03 R-2096

SE 1/4 of SW
1/4 of Sec. 2

TOWNSHIP 31S, RANGE 37E, W. M.

North

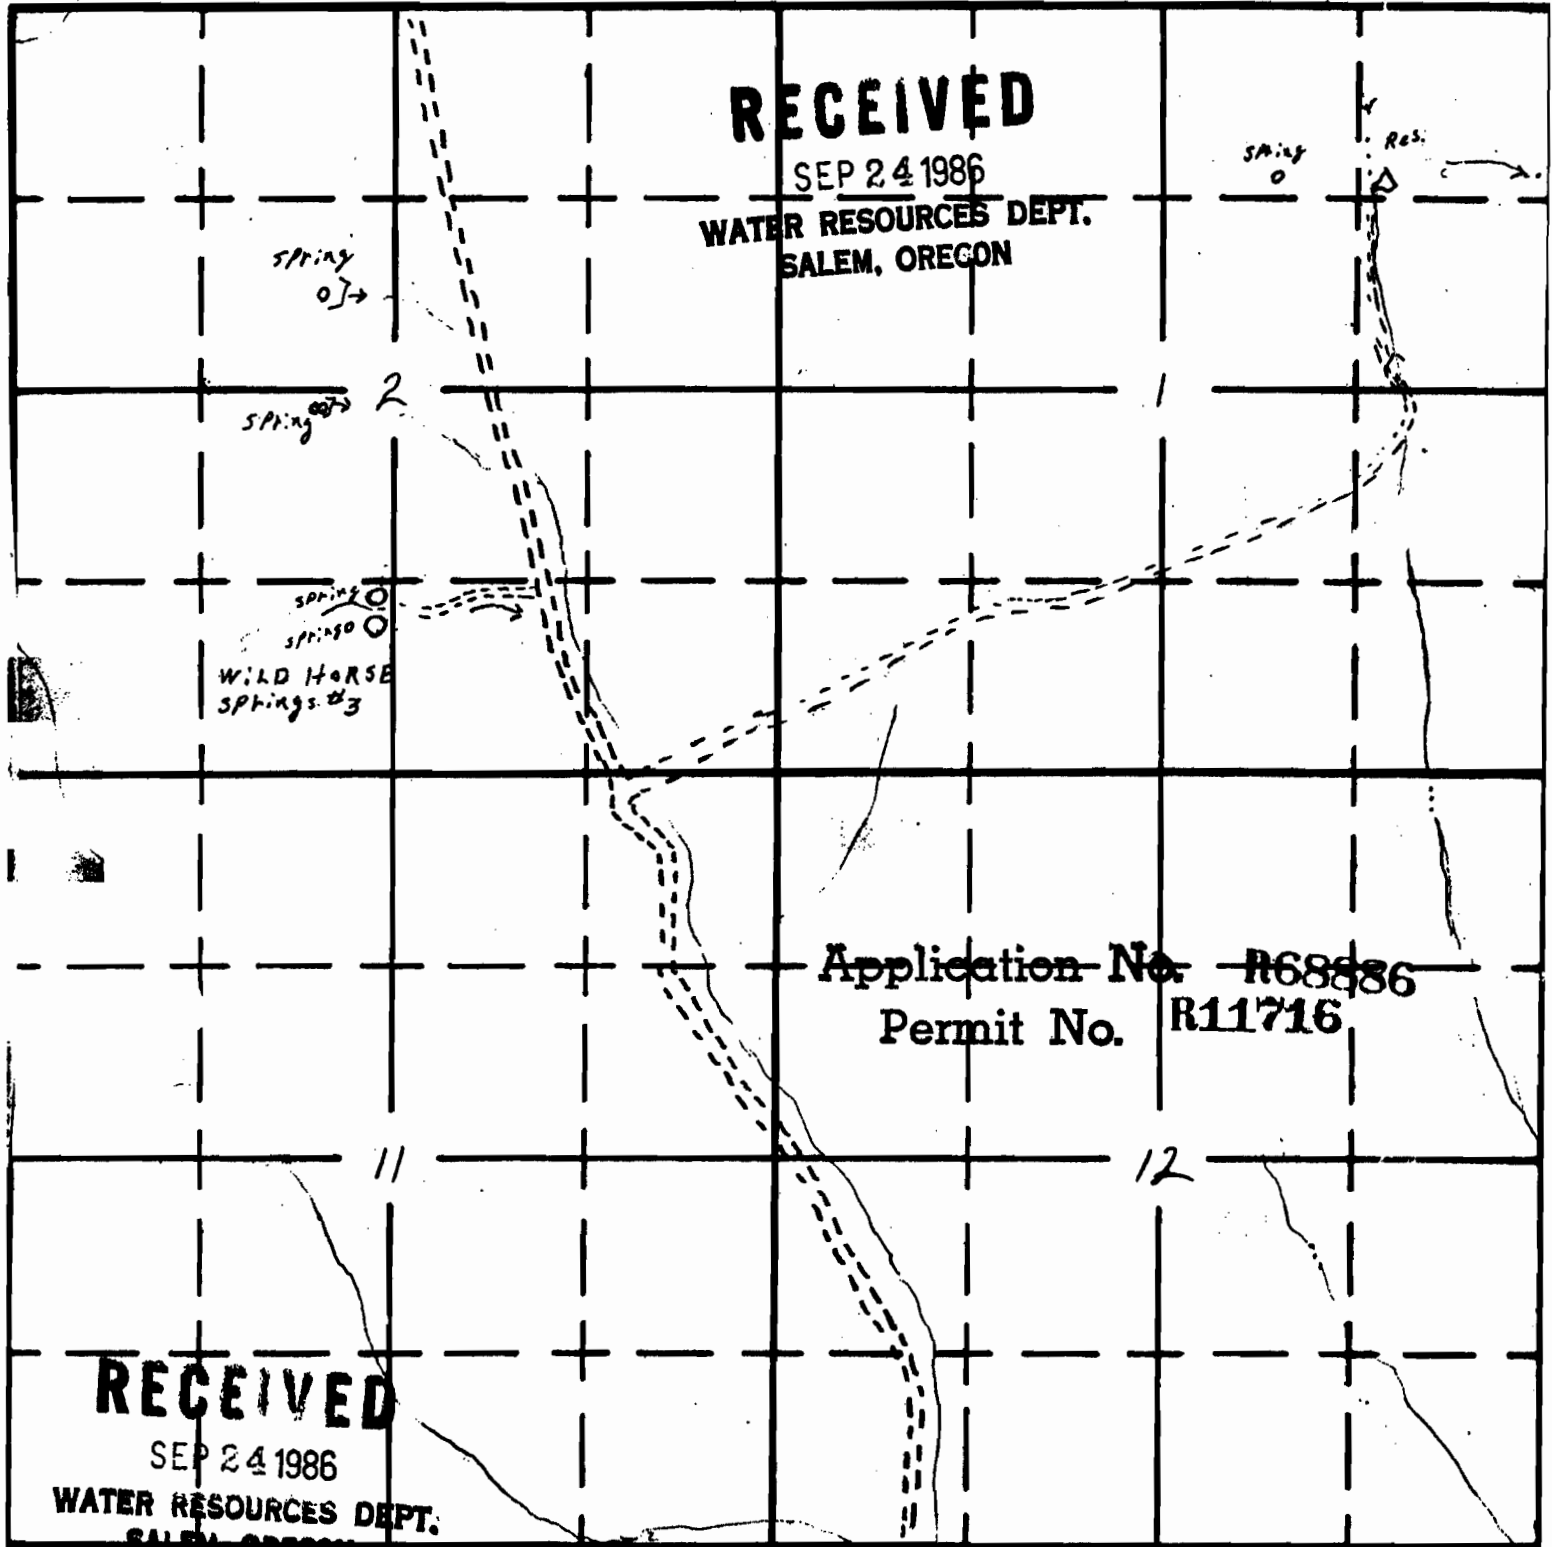

South

APPLICATION No.