

AL-187  
March 1961

UNITED STATES  
DEPARTMENT OF THE INTERIOR  
BUREAU OF LAND MANAGEMENT

RECEIVED  
3707

SECTION

SENE  
SEC 3


TOWNSHIP 38 S, RANGE 44 E, W. M.

RECEIVED

SEP 24 1986

WATER RESOURCES DEPT  
SALEM, OREGON


Application No. R68898  
Permit No. R11734

Actual location of  
Fearless pit reservoir  
← FEARLESS RES.

RECEIVED

MAR 6 2000

WATER RESOURCES DEPT.  
SALEM, OREGON

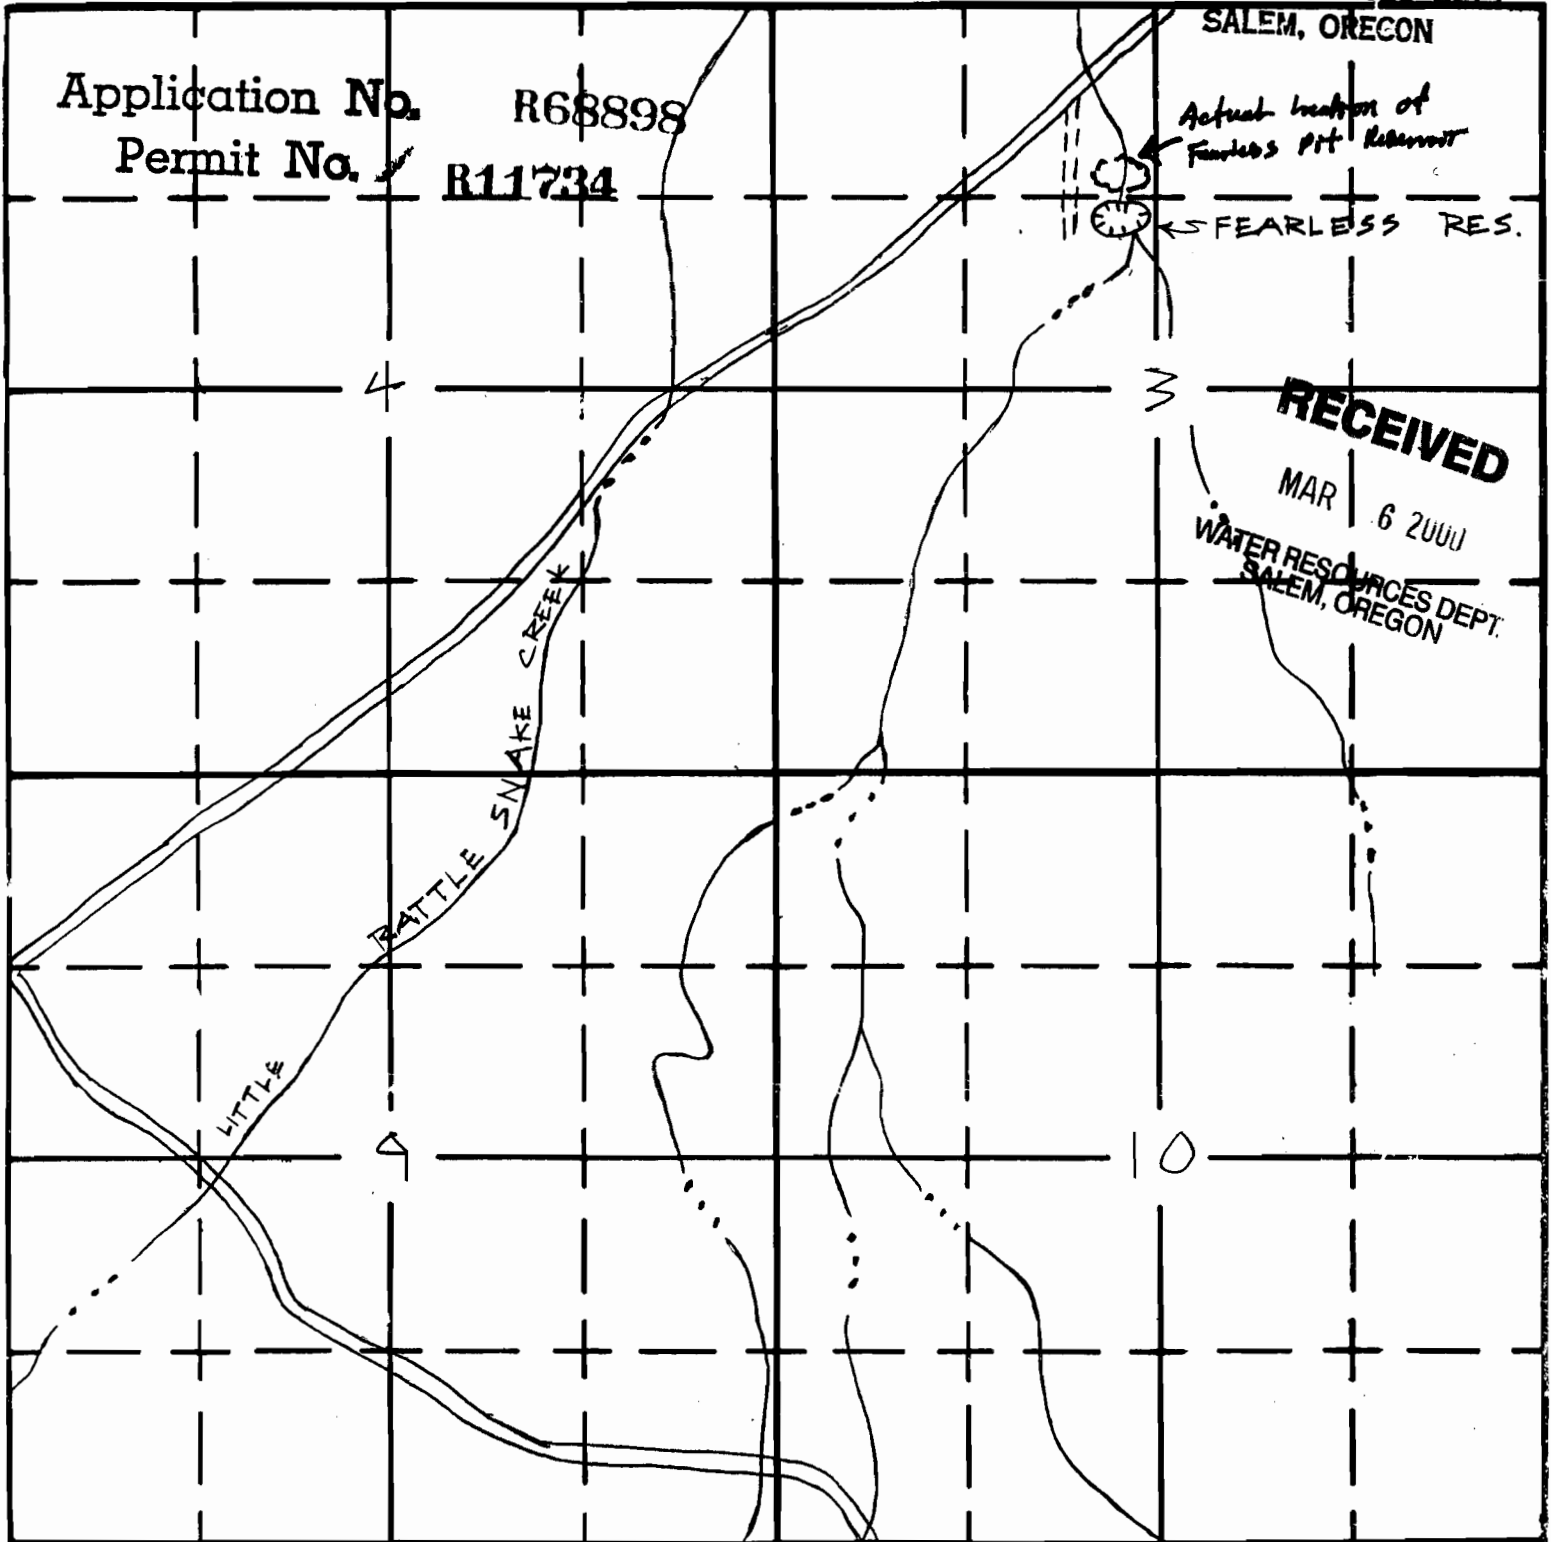

J.A.

South

APPLICATION No.  
PERMIT No.