

Form AI-187
March 1961

UNITED STATES
DEPARTMENT OF THE INTERIOR
BUREAU OF LAND MANAGEMENT


CUT-OUT
RESERVOIR
4833

SECTION

NE 1/4, NE 1/4
SEC 27

Oregon State Water Filings

TOWNSHIP 21 S, RANGE 38 E, W. M.

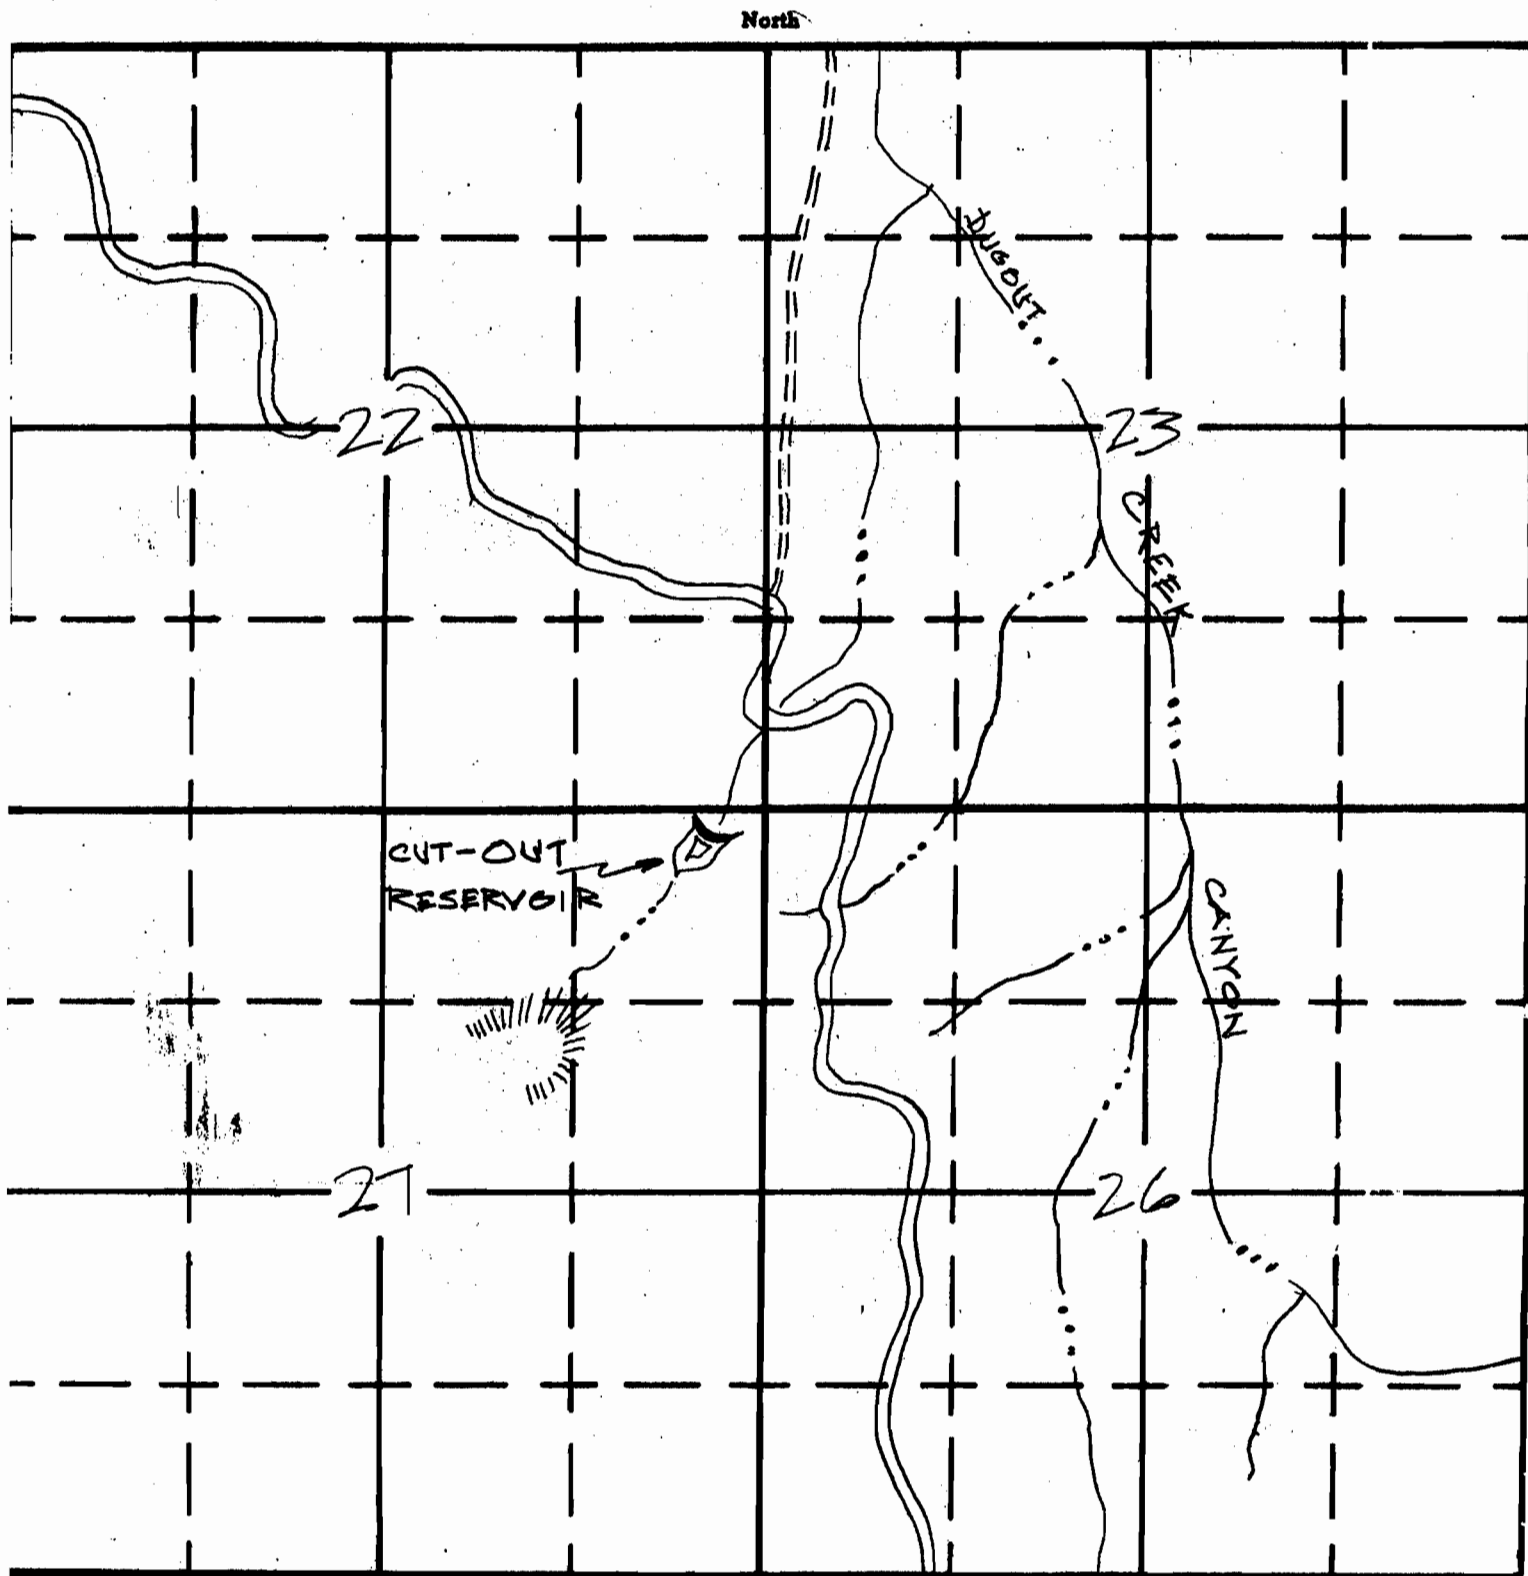

Application No. R-68876
Permit No. R11142

APPLICATION No. R68876