

UNITED STATES
DEPARTMENT OF THE INTERIOR
BUREAU OF LAND MANAGEMENT

Fence Line pit # 2
2152

SECTION

NE $\frac{1}{4}$ of NW $\frac{1}{4}$

Sec. 16


Oregon State Water Filings

TOWNSHIP 32S, RANGE 45E, W. M.

RECEIVED

SEP 24 1986

WATER RESOURCES DEPT
SALEM, OREGON

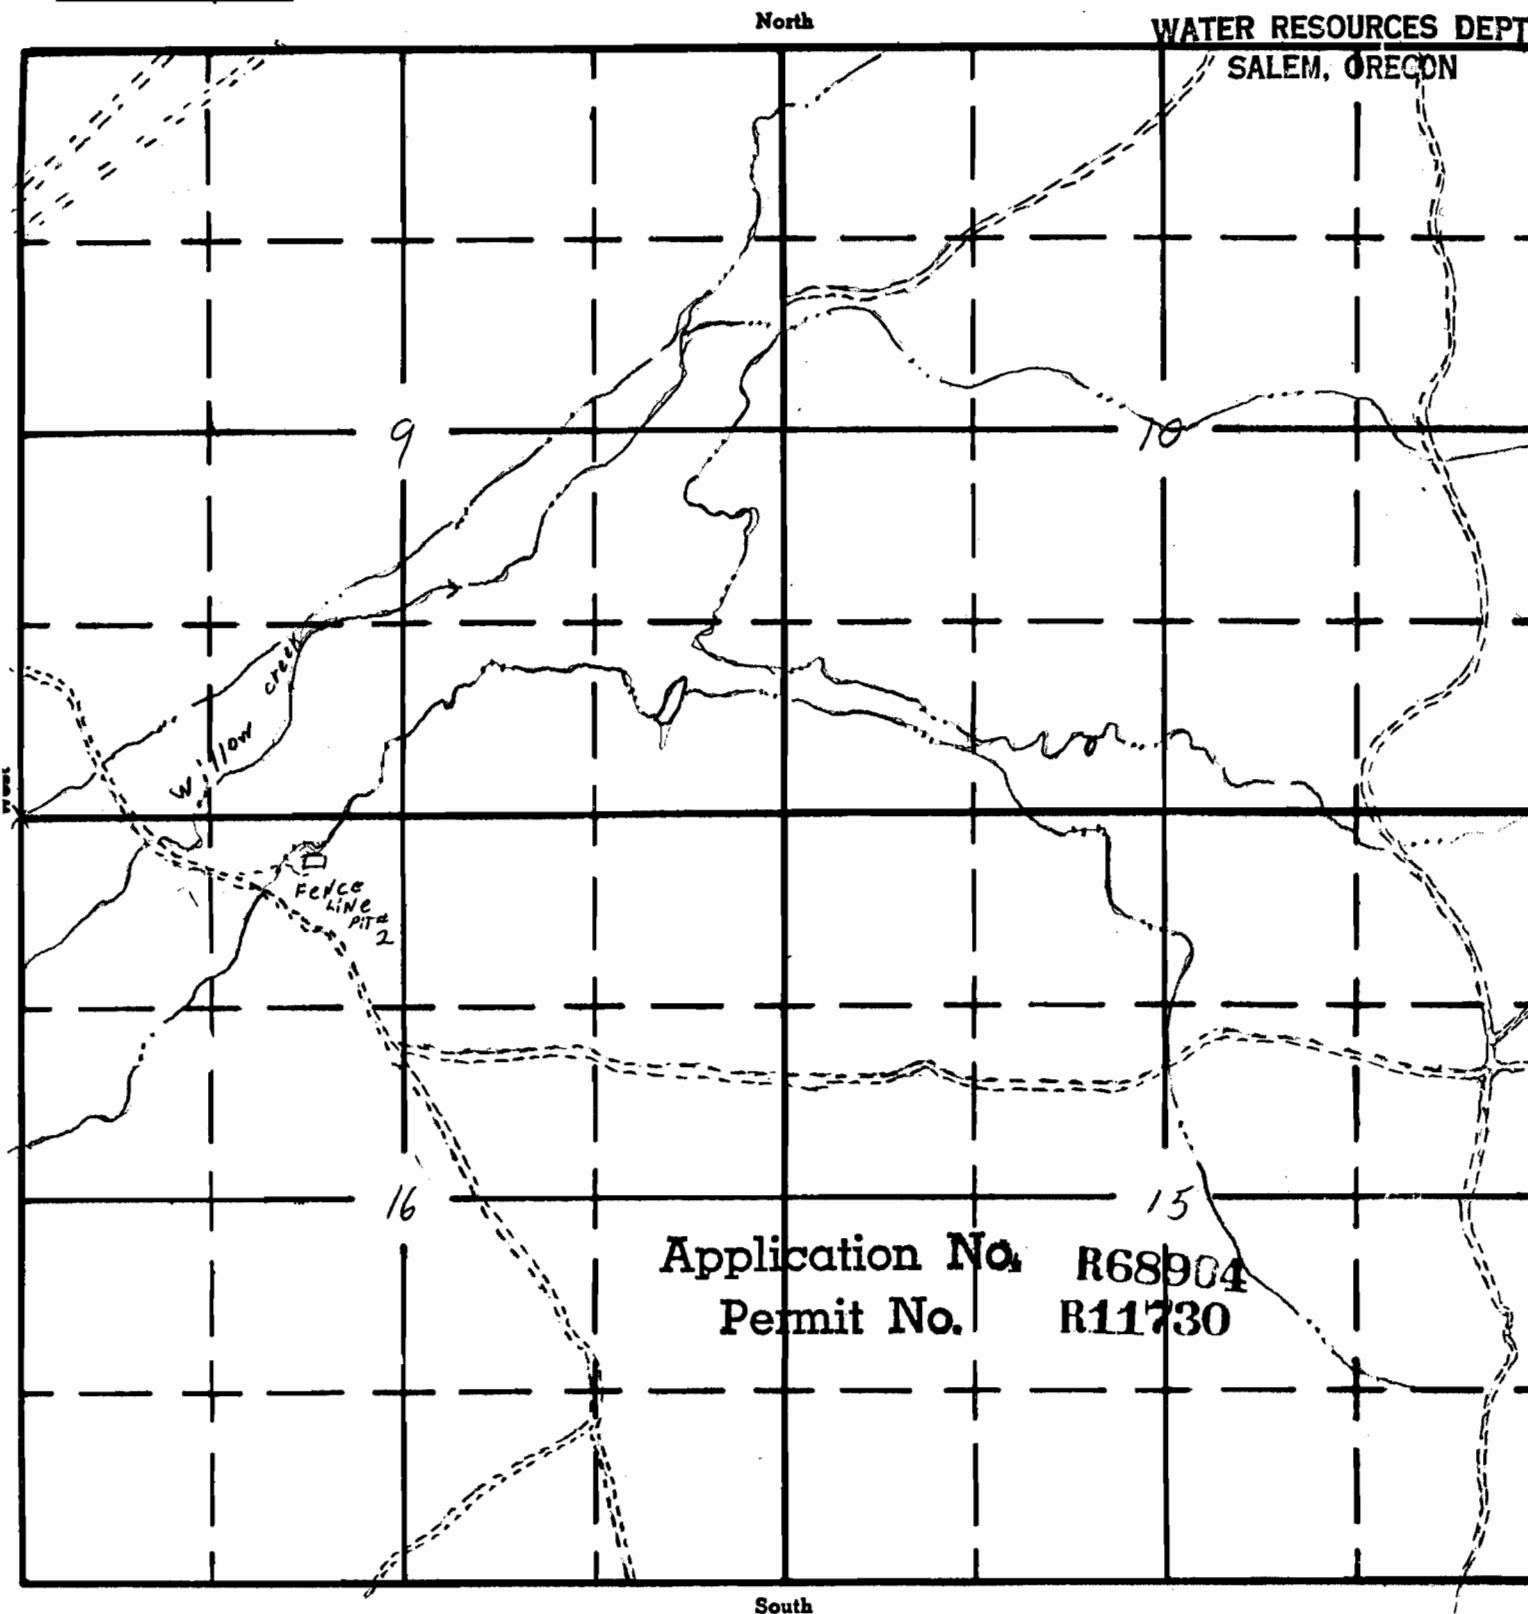

Application No. R68904
Permit No. R11730

APPLICATION No.