

AL-187
JUN 1 1961

UNITED STATES
DEPARTMENT OF THE INTERIOR
BUREAU OF LAND MANAGEMENT

Johnny
Creek Res.
0829

SECTION

SE 1/4 of NE 1/4
Sec. 1


Oregon State Water Filings RECEIVED

TOWNSHIP 31S, RANGE 37E, W.M.

MAR 3 2000

North

WATER RESOURCES DEPT
SALEM, OREGON

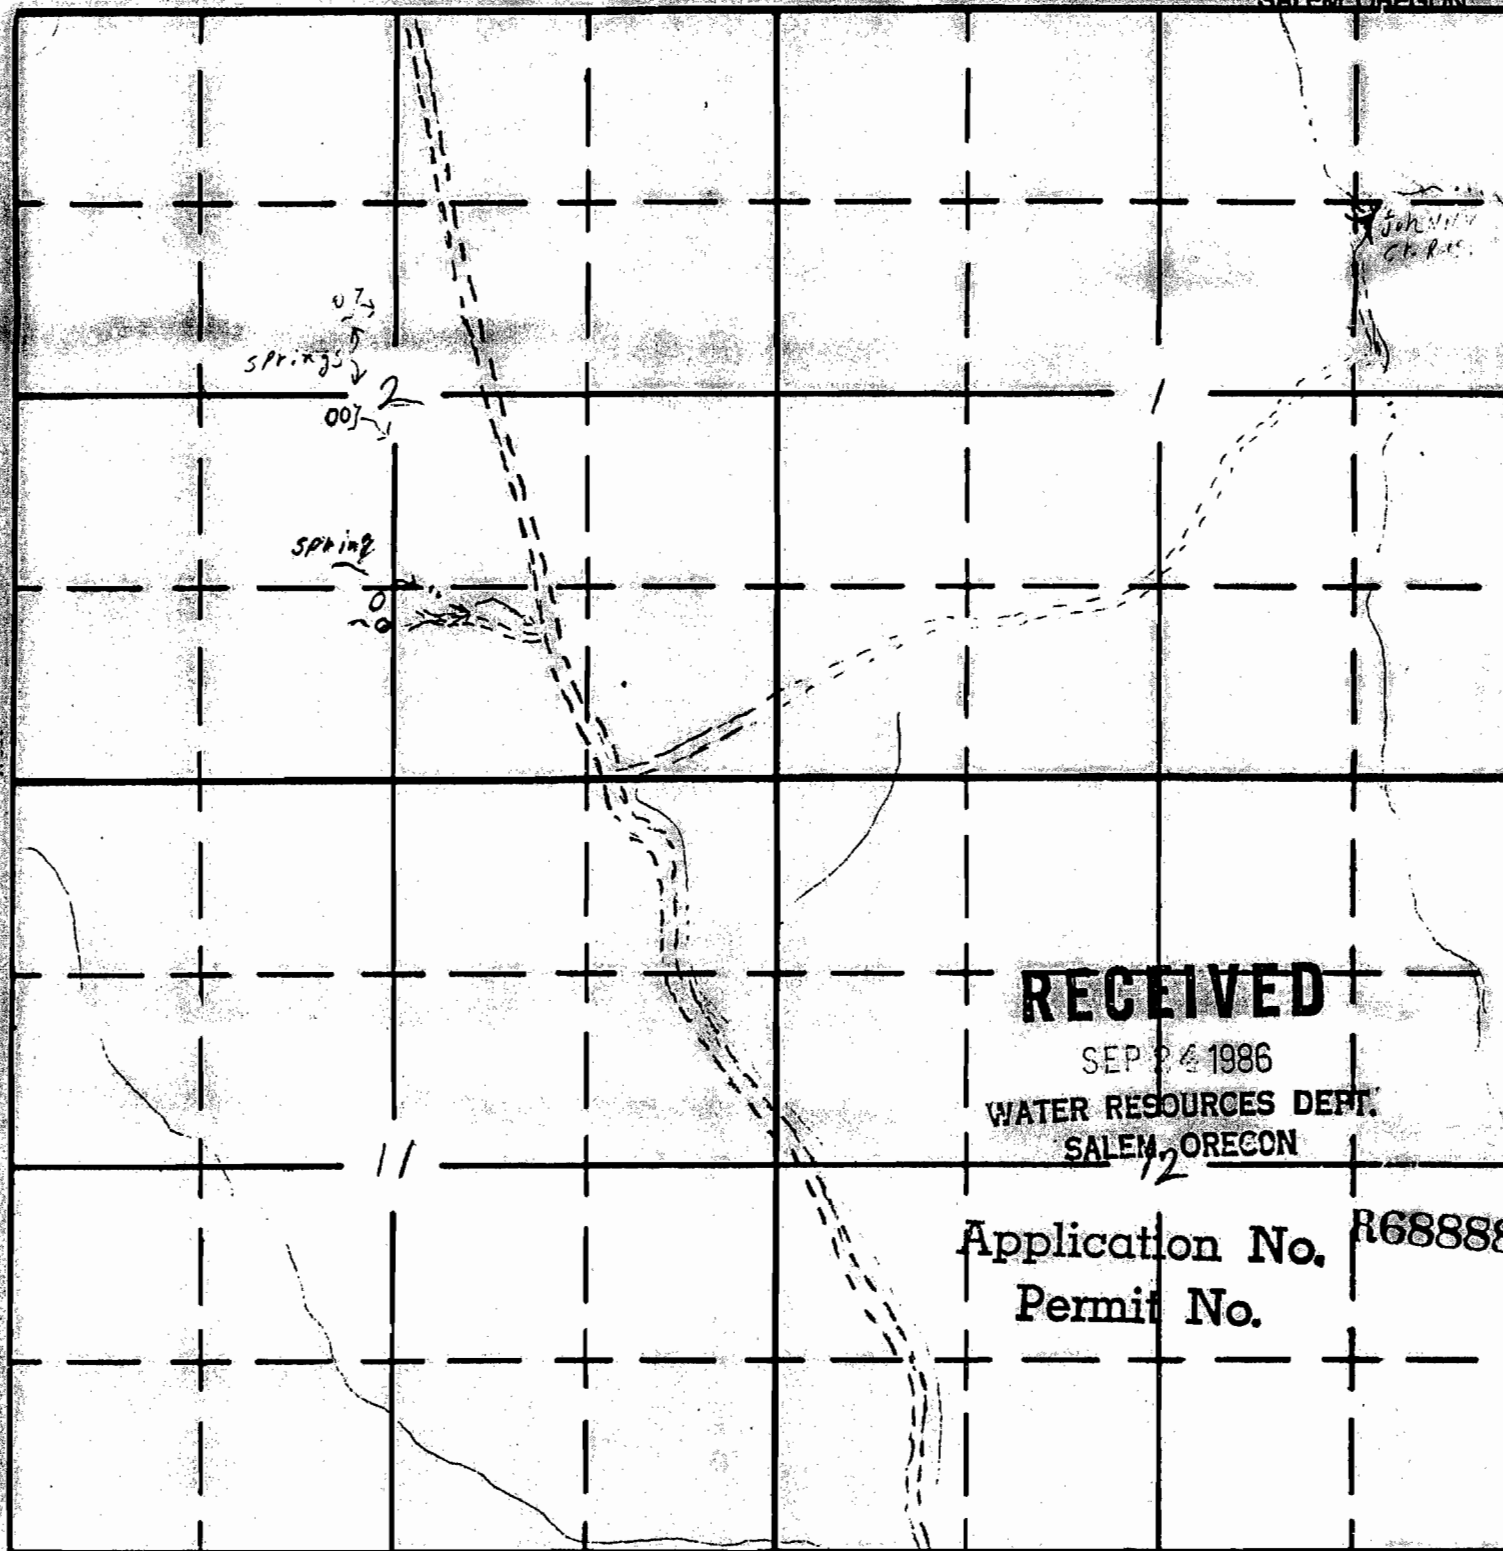

South

APPLICATION No. R-688