

UNITED STATES
DEPARTMENT OF THE INTERIOR
BUREAU OF LAND MANAGEMENT

Lake Pit
2149

SECTION

Oregon State Water Filing

RECEIVED

NW 1/4 of SE 1/4
of Sec. 32


TOWNSHIP 31S, RANGE 44E, W. M.

SEP 24 1986

WATER RESOURCES DEPT.
SALEM, OREGON

North

Application No. R68890
Permit No. R11738

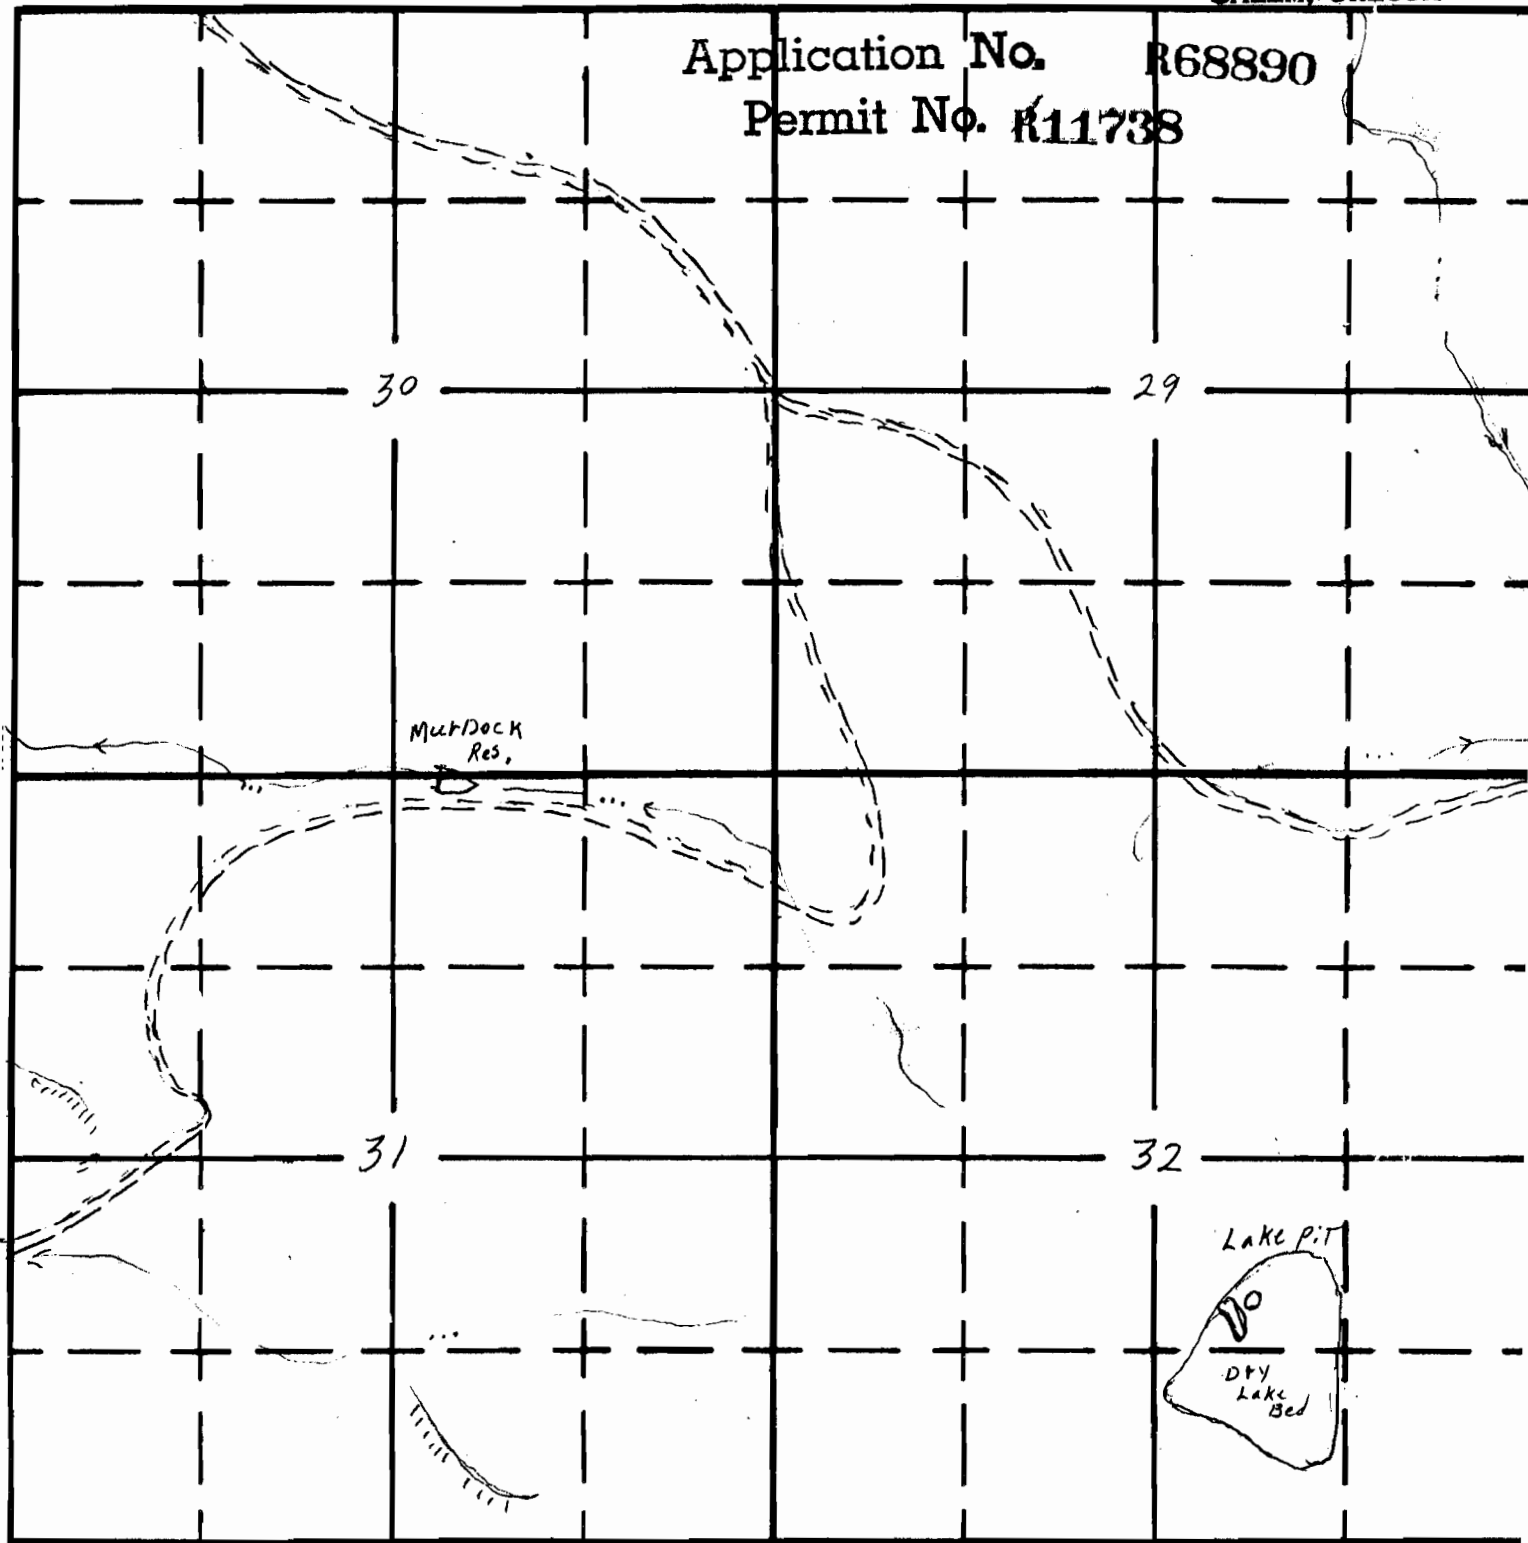

South

APPLICATION No.