

UNITED STATES
DEPARTMENT OF THE INTERIOR
BUREAU OF LAND MANAGEMENT


SECTION
SENE 20

Oregon State Water Filings

TOWNSHIP 19 S, RANGE 38 E, W. M.

MAHOGANY PIT

North

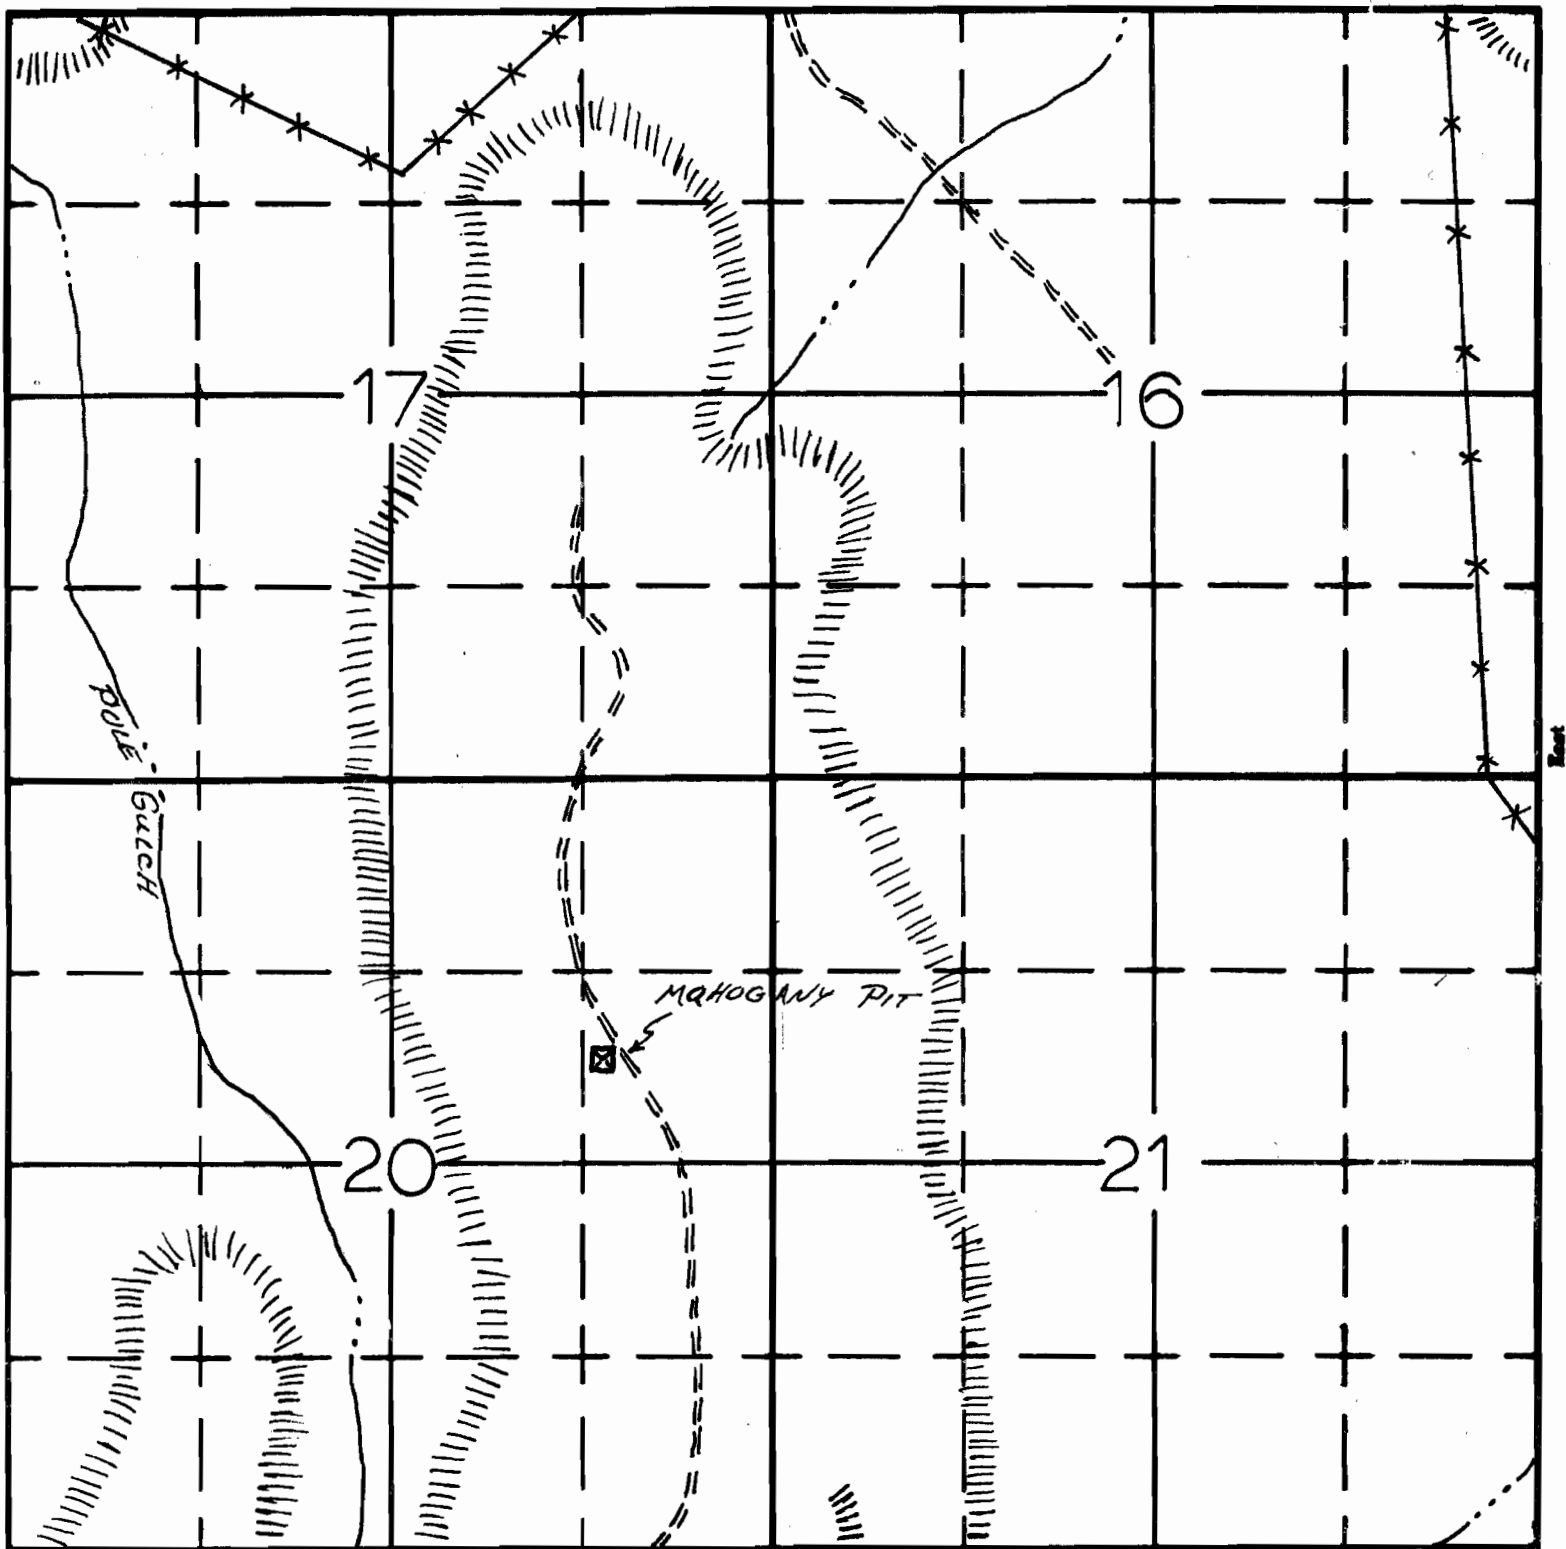

South

APPLICATION No. R-67839
PERMIT No. R10657