

UNITED STATES
DEPARTMENT OF THE INTERIOR
BUREAU OF LAND MANAGEMENT


SECTION 18

Oregon State Water Filings

S.W.S.W

TOWNSHIP 20^S, RANGE 39^E, W. M.

North CURREY CANYON #2

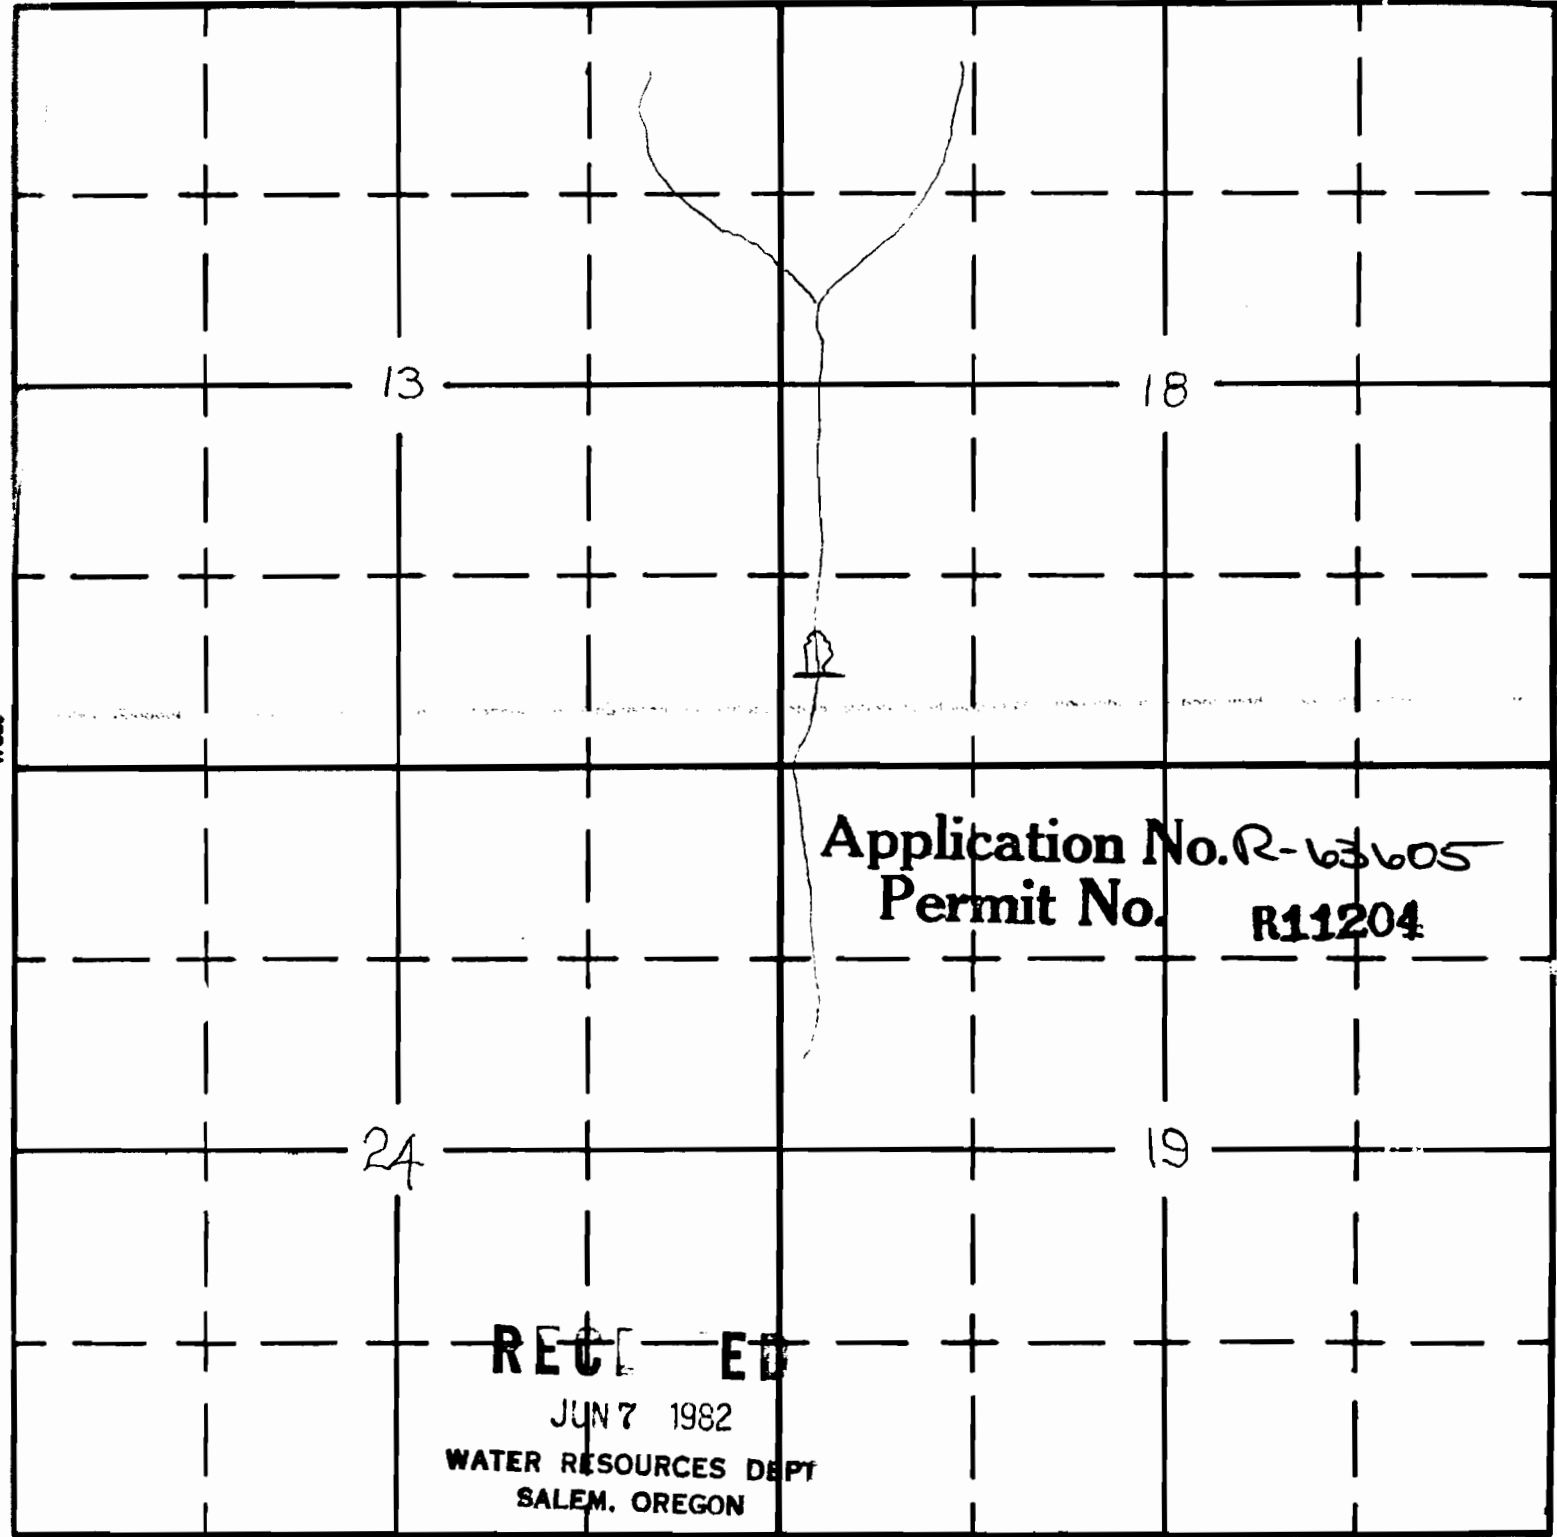

RECEIVED
JUN 7 1982
WATER RESOURCES DEPT
SALEM, OREGON

APPLICATION No.
PERMIT No.