


RECEIVED

AUG 6 - 1979

WATER RESOURCES DEPT
SALEM, OREGON

T. 21 S. R. 42 E. W.M.

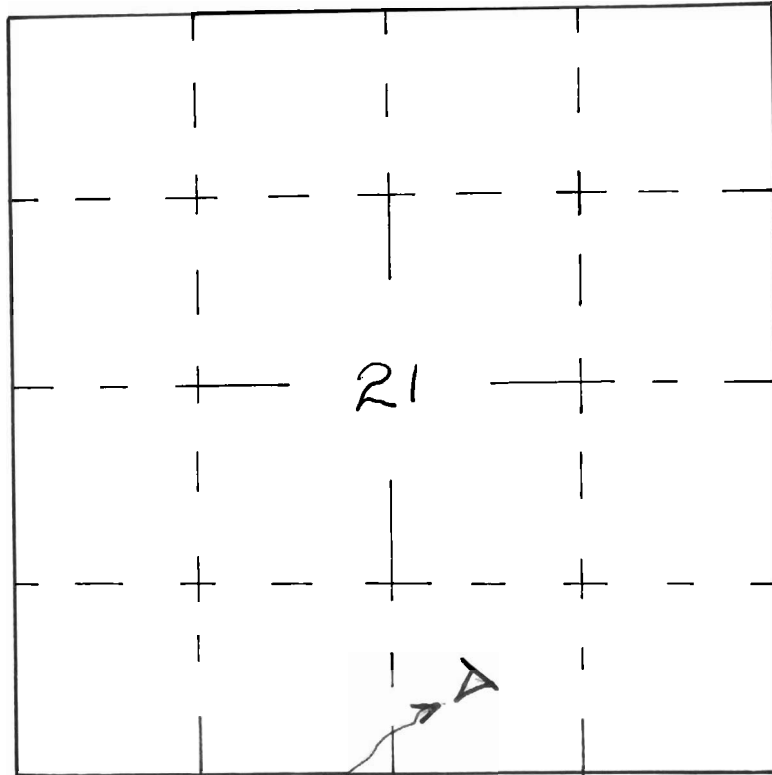

RECEIVED

APR 6 1983

WATER RESOURCES DEPT.
SALEM, OREGON

Application No. R59030
Permit No. R 8681

U. S. DEPARTMENT OF THE INTERIOR
BUREAU OF LAND MANAGEMENT

QUICK FILL

DESIGNED _____

RECOMM. _____

DRAWN _____

RECOMM. _____

CHIEF, DIV. OF ENG.

CHECKED _____

APPROVED _____

SCALE _____

DATE _____

SHEET _____ OF _____

DRAWING NO. _____