

Form AI-187
March 1961

UNITED STATES
DEPARTMENT OF THE INTERIOR
BUREAU OF LAND MANAGEMENT


K-2603
78180

SECTION

14 Oregon State Water Filings

TOWNSHIP 40S, RANGE 14 1/2 E, W. M.

North

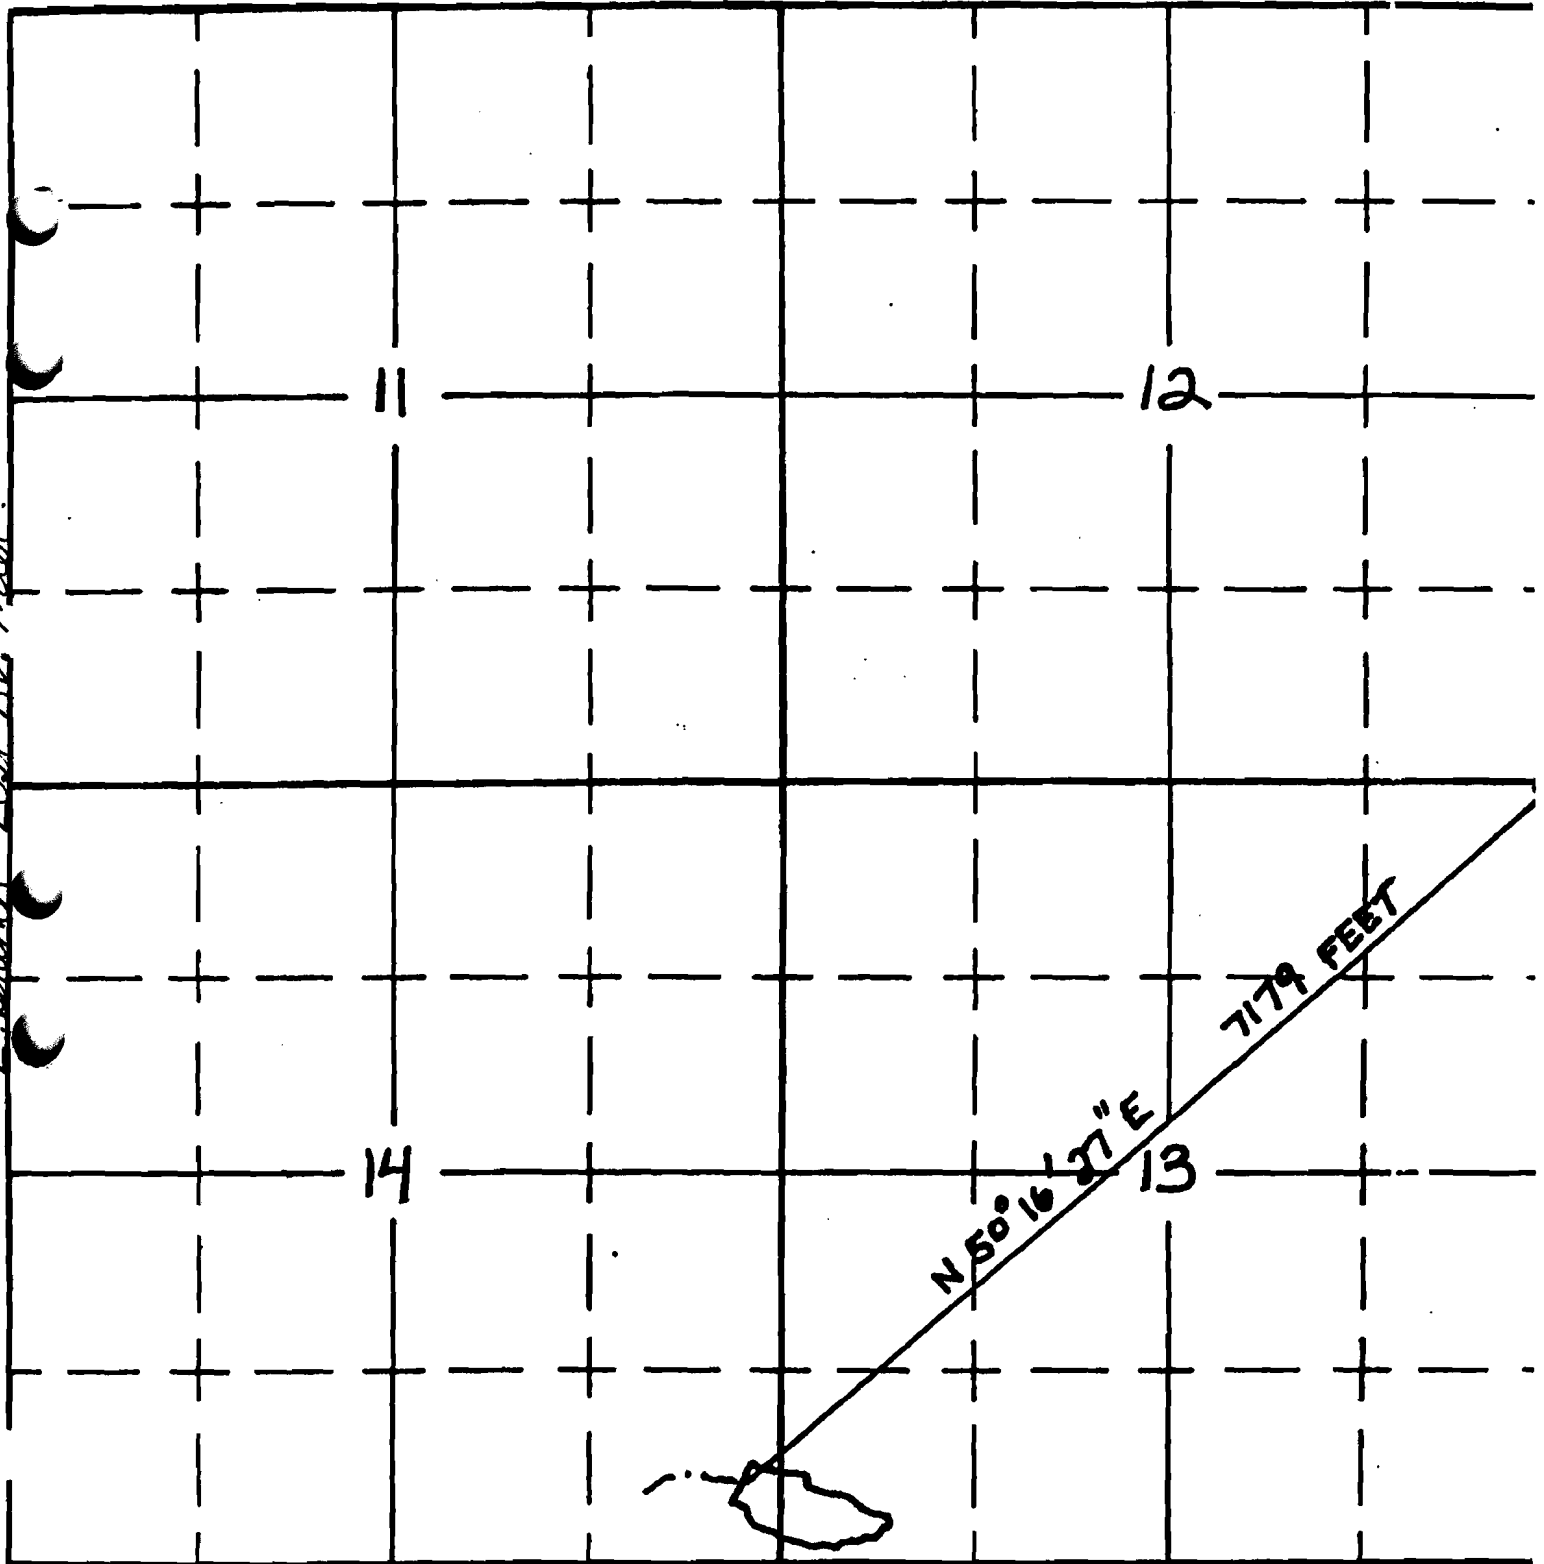

South

1" = 1320 FEET

R 33728
APPLICATION No. R337.