


Sulphur springs
Trough T65 R28E
section 6

RECEIVED

DEC 7 1983
WATER RESOURCES DEPT.
SALEM, OREGON

Application No. 64664
Permit No. 49152

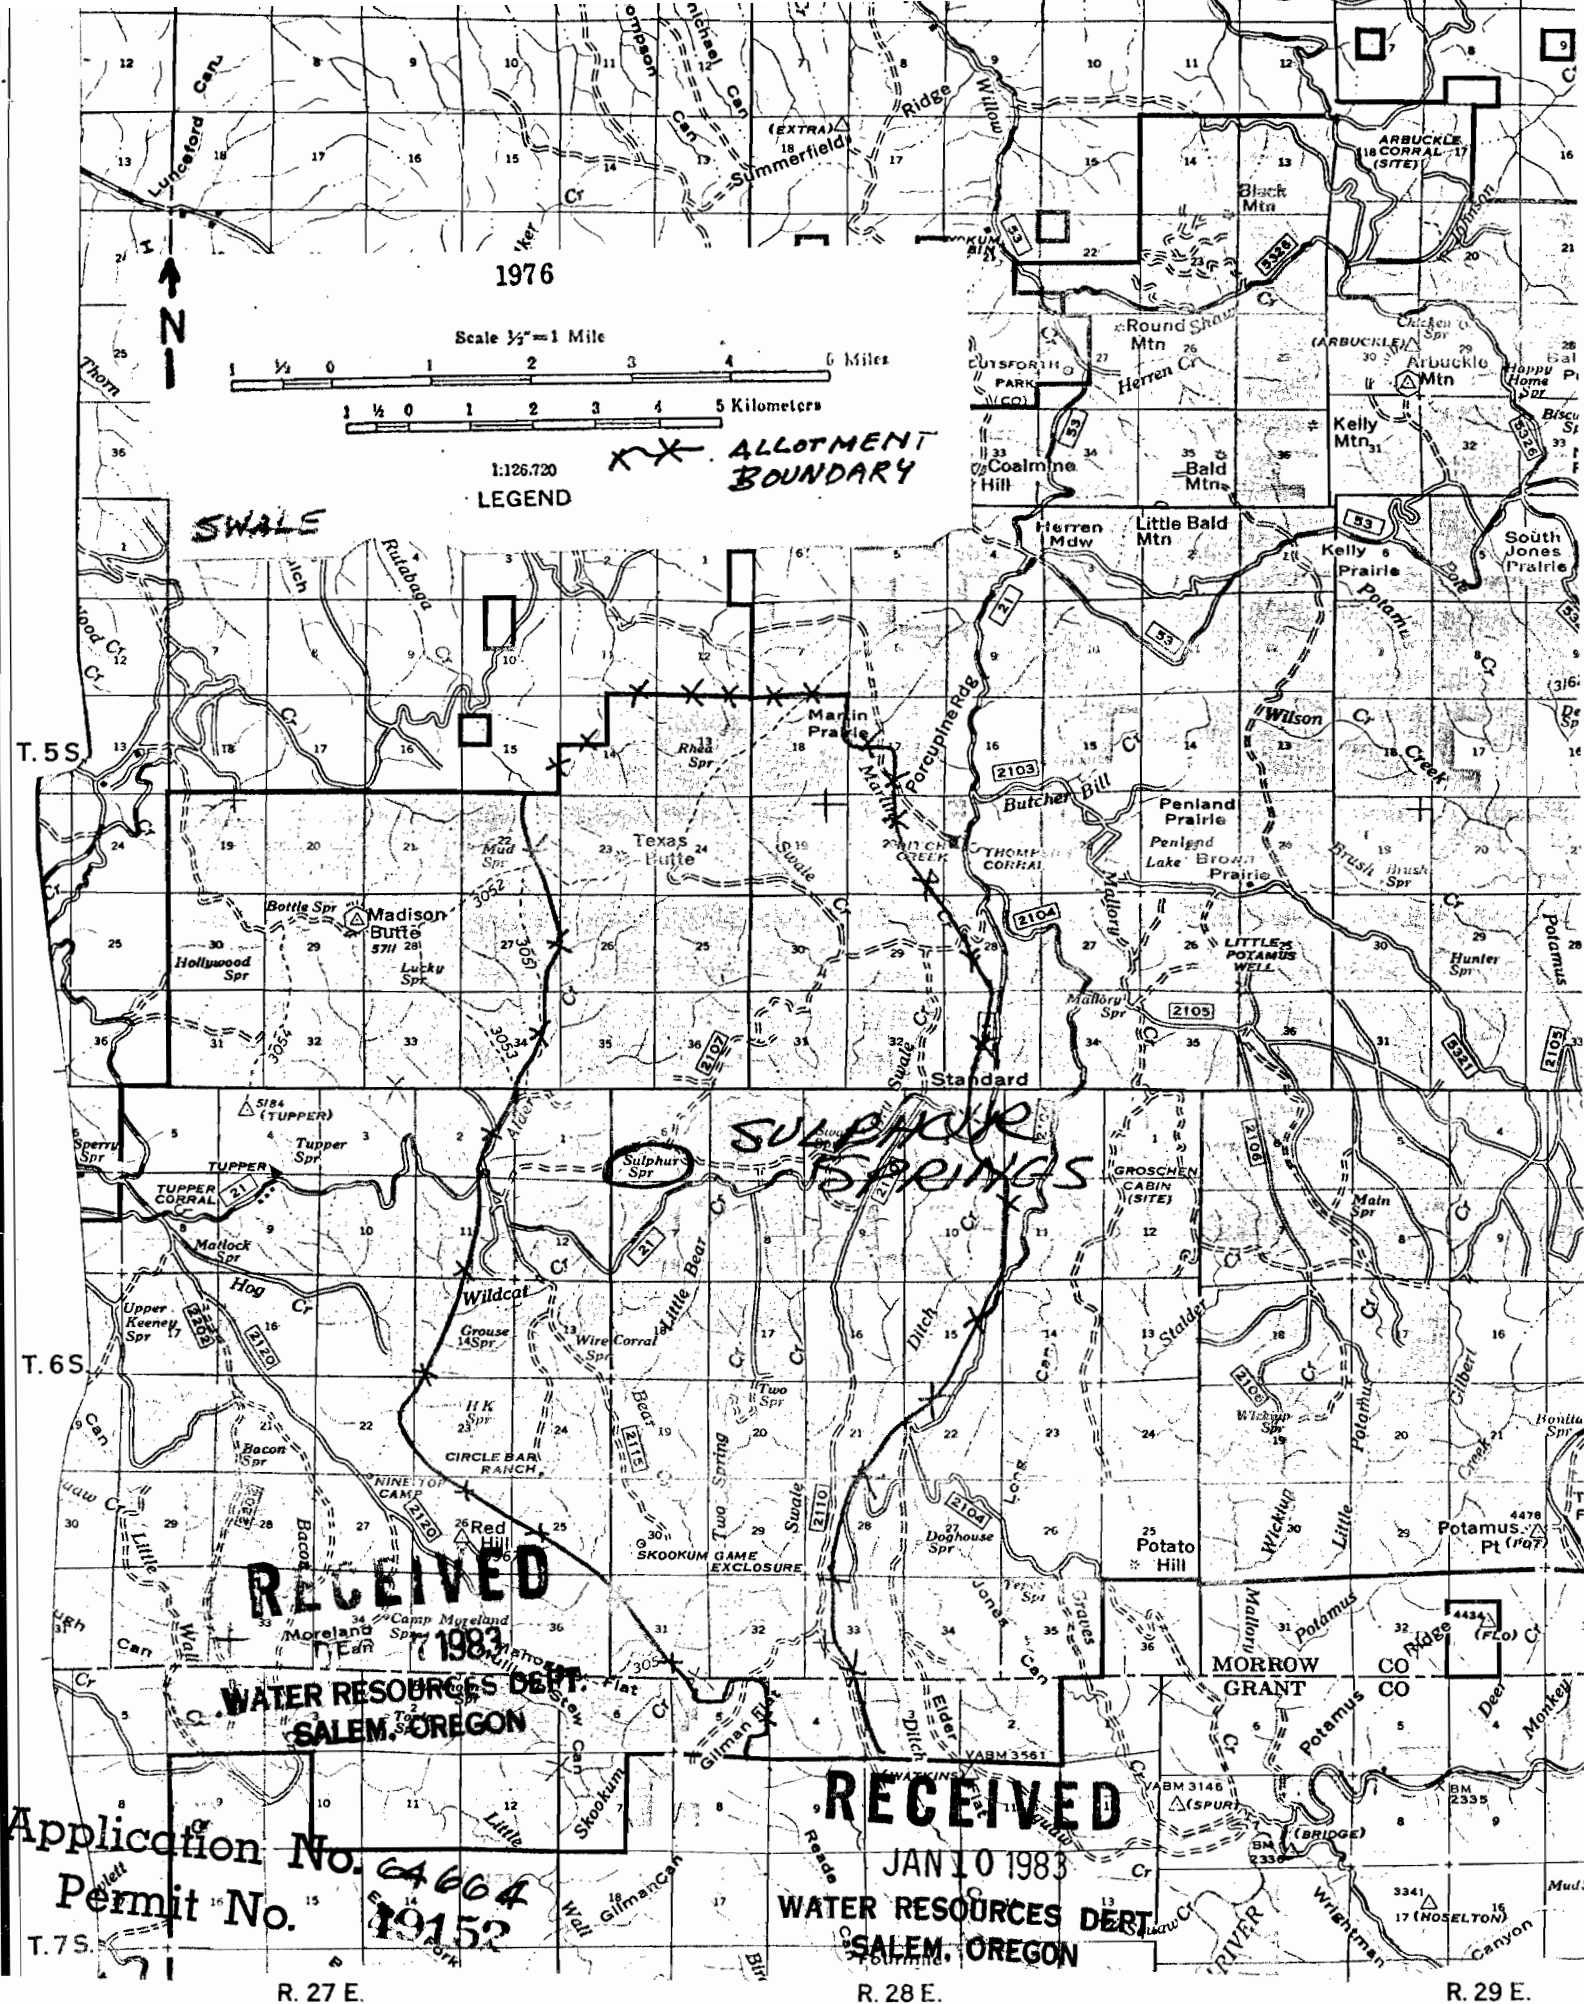

R. 27 E.

R. 28 E.

R. 29 E.

