

Patterson
Basin

4200

4800

4600

4000

29

67135
50388

Mulkey
Spring

32

4000

T8S
R32E




WATER RESOURCES DEPT.
SALEM, OREGON

06 RANGE

District Dale
Name Mulkey Spring Allotment Indian Creek

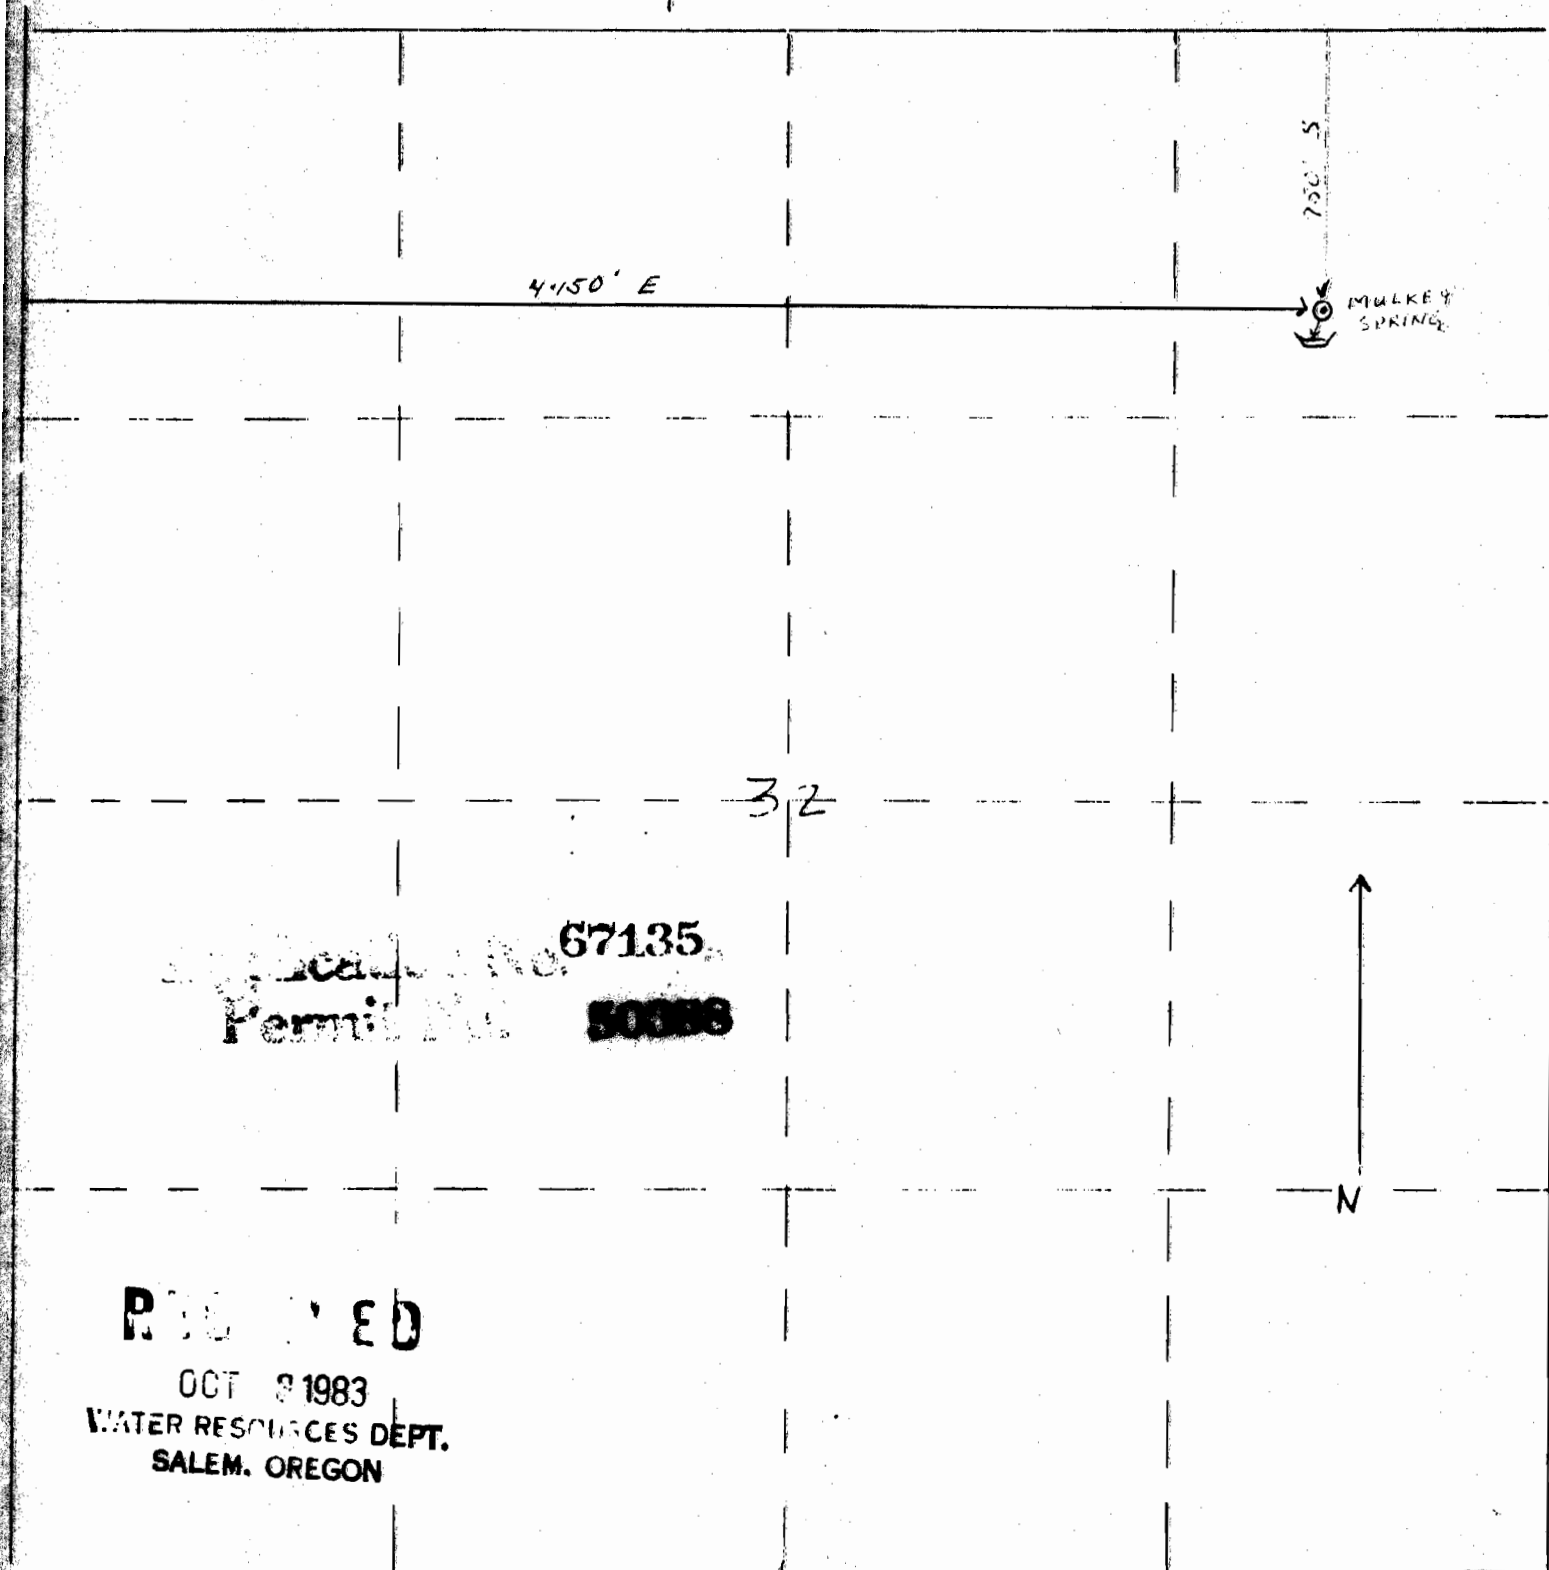

Township 8S Range 32E Section 32
Scale 1" = 660 FT.