


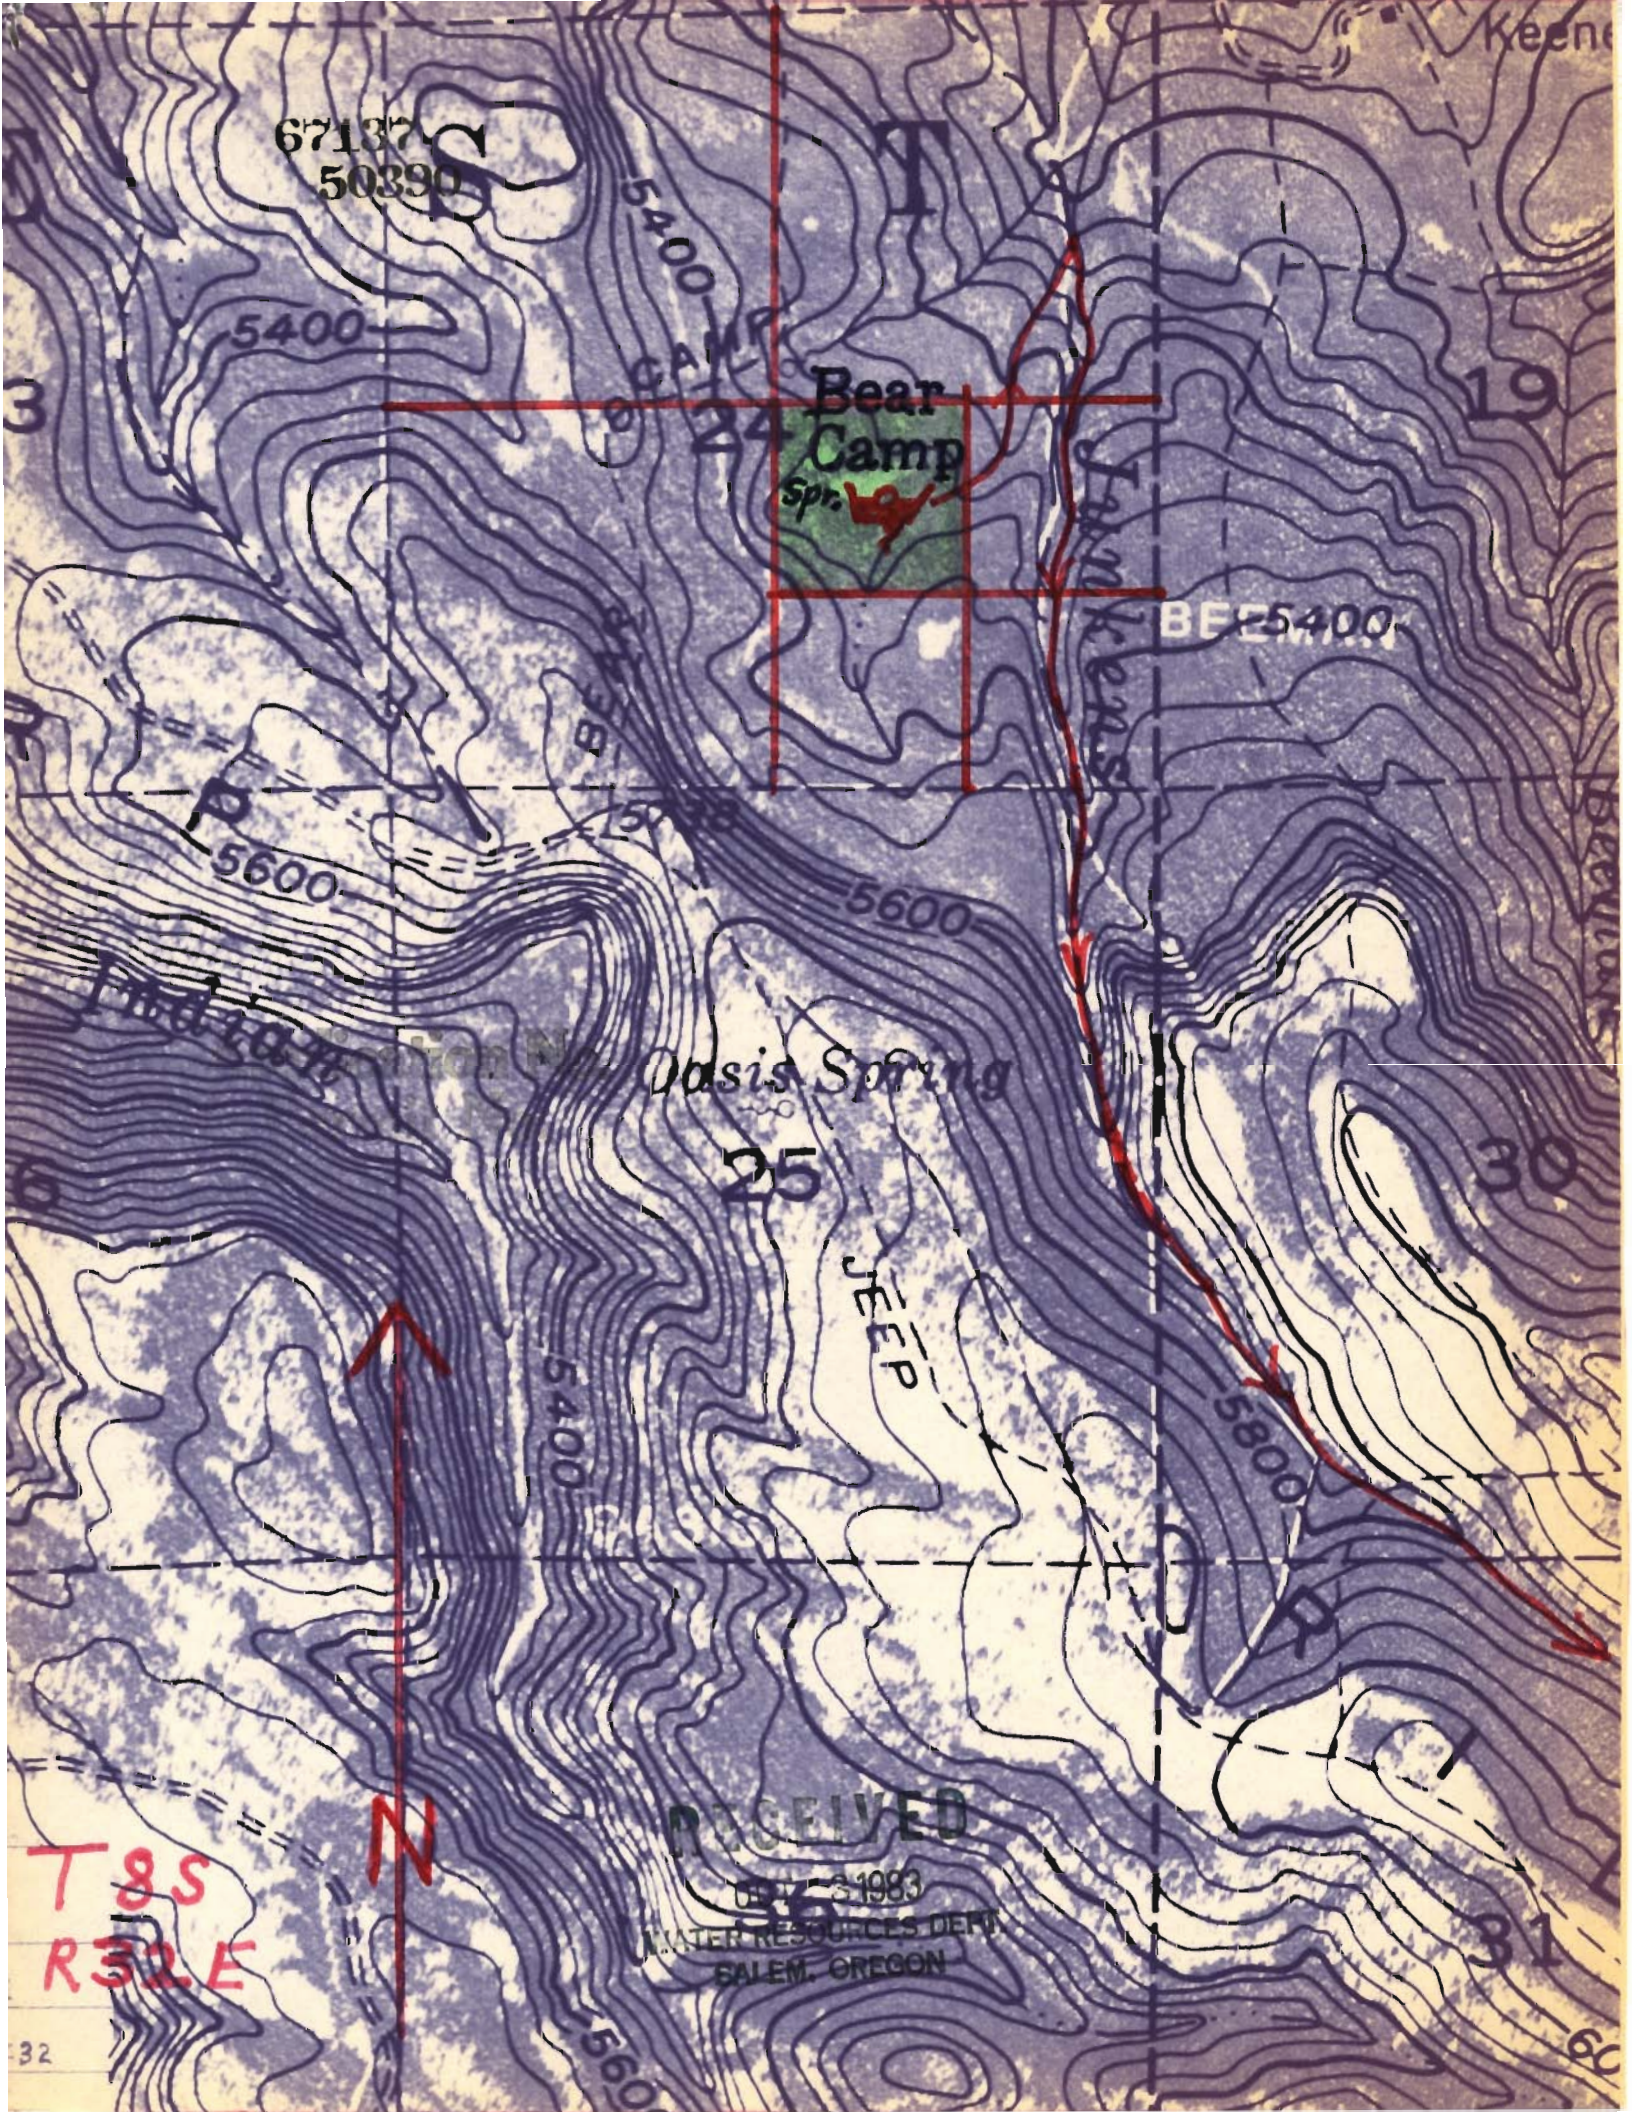

67137
50390

Bear
Camp
Spr.

BE 5400

Dasis Spring

JEOP

RECEIVED

OCT 13 1983

WATER RESOURCES DEPT.
SALEM, OREGON

T8S
R32E

N

District Dale

Name Bear Camp Spring Allotment Indian Creek

Application No **67137**
Permit No. **50390**

N

24

Bear
Camp
Springs

18.50' W

2000' N

RECEIVED

OCT 31 1983

WATER RESOURCES DEPT.
SALEM, OREGON

Township 8S. Range 32E. Section 24
Scale 1" = 660 FT.