


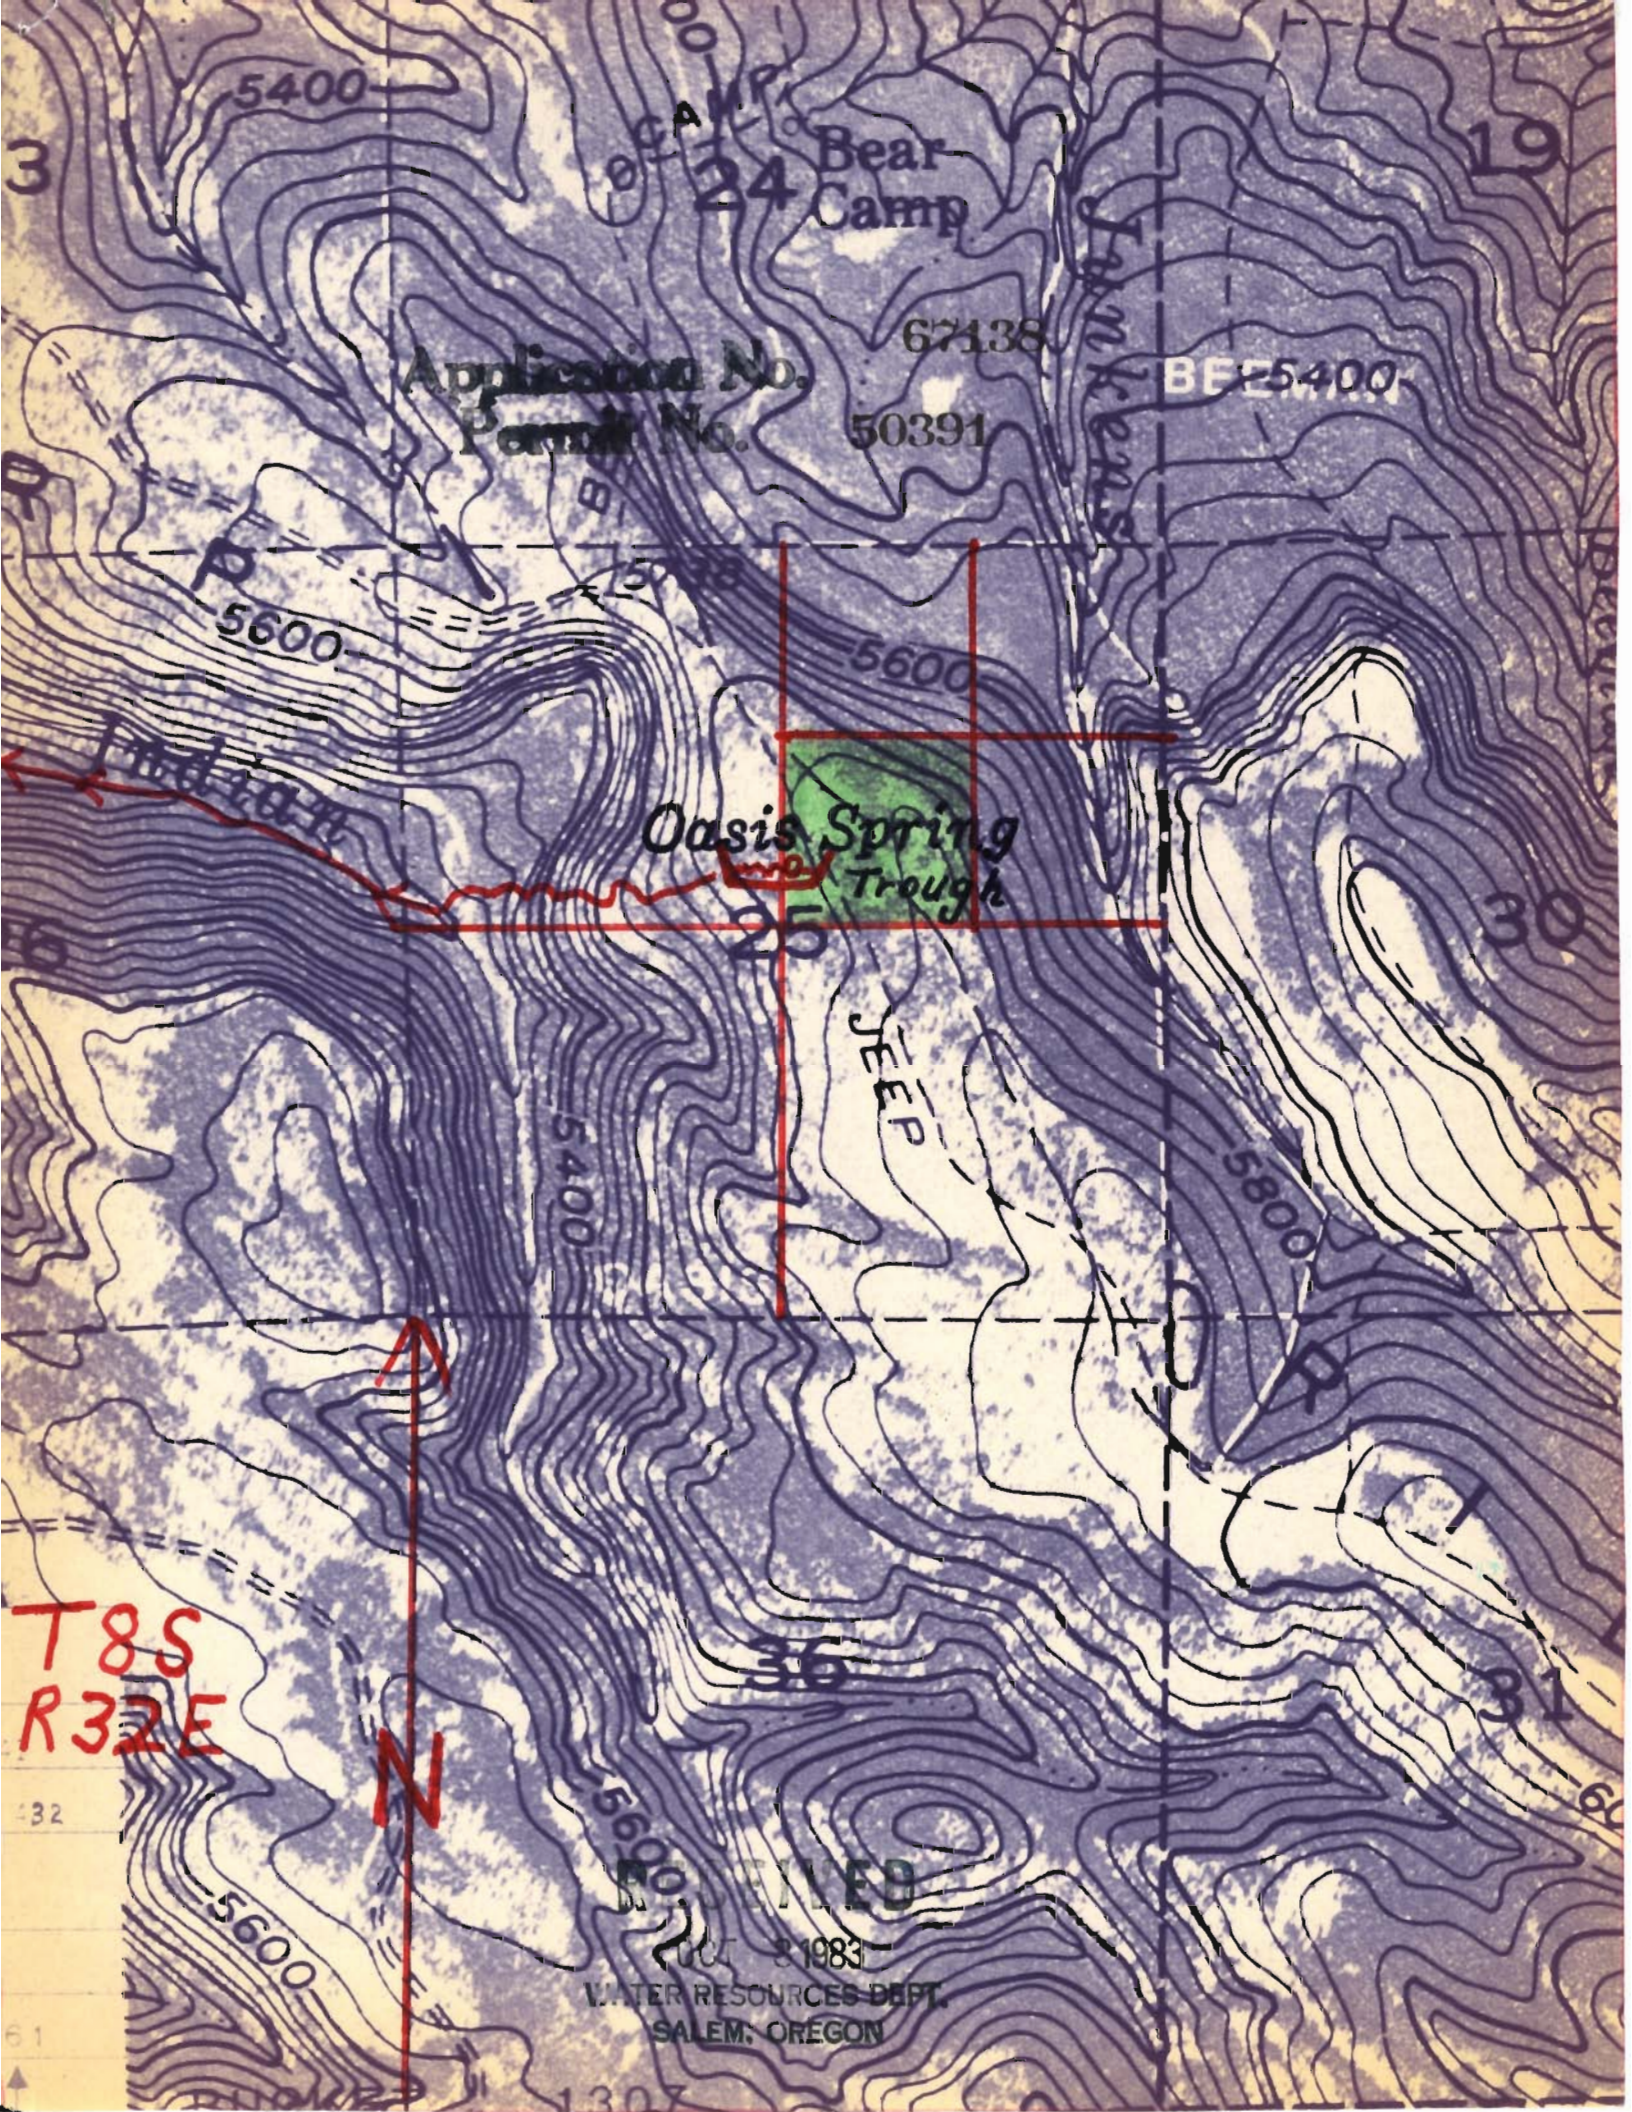

Bear Camp

Application No.
Permit No.

67138

50391

BEE5400

Oasis Spring
Trough

JEOP

T8S
R32E

N

REVISED

8/1983

WATER RESOURCES DEPT.
SALEM, OREGON

District _____ Date _____

Name Oasis Spring Allotment Indian Creek

Application No. 67138
Permit No. 50391

2200' S

2560' W

Oasis
Spring

25

N

RECEIVED

OCT 3 1983

WATER RESOURCES DEPT.
SALEM, OREGON

Township 8S. Range 32E. Section 25
Scale 1" = 660 FT.

District Dale

Name Oasis Spring Allotment Indian Creek

Application No. 67138
Permit No. 50391

2200' S

2560' W

Oasis
Spring

25

N

RECEIVED

OCT 31 1983

WATER RESOURCES DEPT.
SALEM, OREGON

Township 8S. Range 32E. Section 25
Scale 1" = 660 FT.