

District Date

Name Huckleberry Spring Allotment Indian Creek

1200' S

Huckleberry
Spring

100' W

N
↑

3

67140

~~Application No.~~
~~Permit No.~~

50393

RECEIVED

001 31983
WATER RESOURCES DEPT.
SALEM, OREGON

Township p 9S. Range 32. Section Lot 1
Scale 1" = 660 FT.

District Date
Name Dutton Spring Allotment Indian Creek

Application No.
Permit N

671-10
50393

1000' S

Dutton Spring



N

34

350' W

RECEIVED

OCT 2 1983

WATER RESOURCES DEPT.
SALEM, OREGON

Township 8S Range 32E Section 34
Scale 1" = 660 FT.

Application No.
Permit No.

67140



Municipal Watersheds



Special Use (long term)



Unpatented Claims




Private Land

Note: Area No. and/or Letters refer
to Line on Tabular Record.

R32E

scale 2" = 1 mile

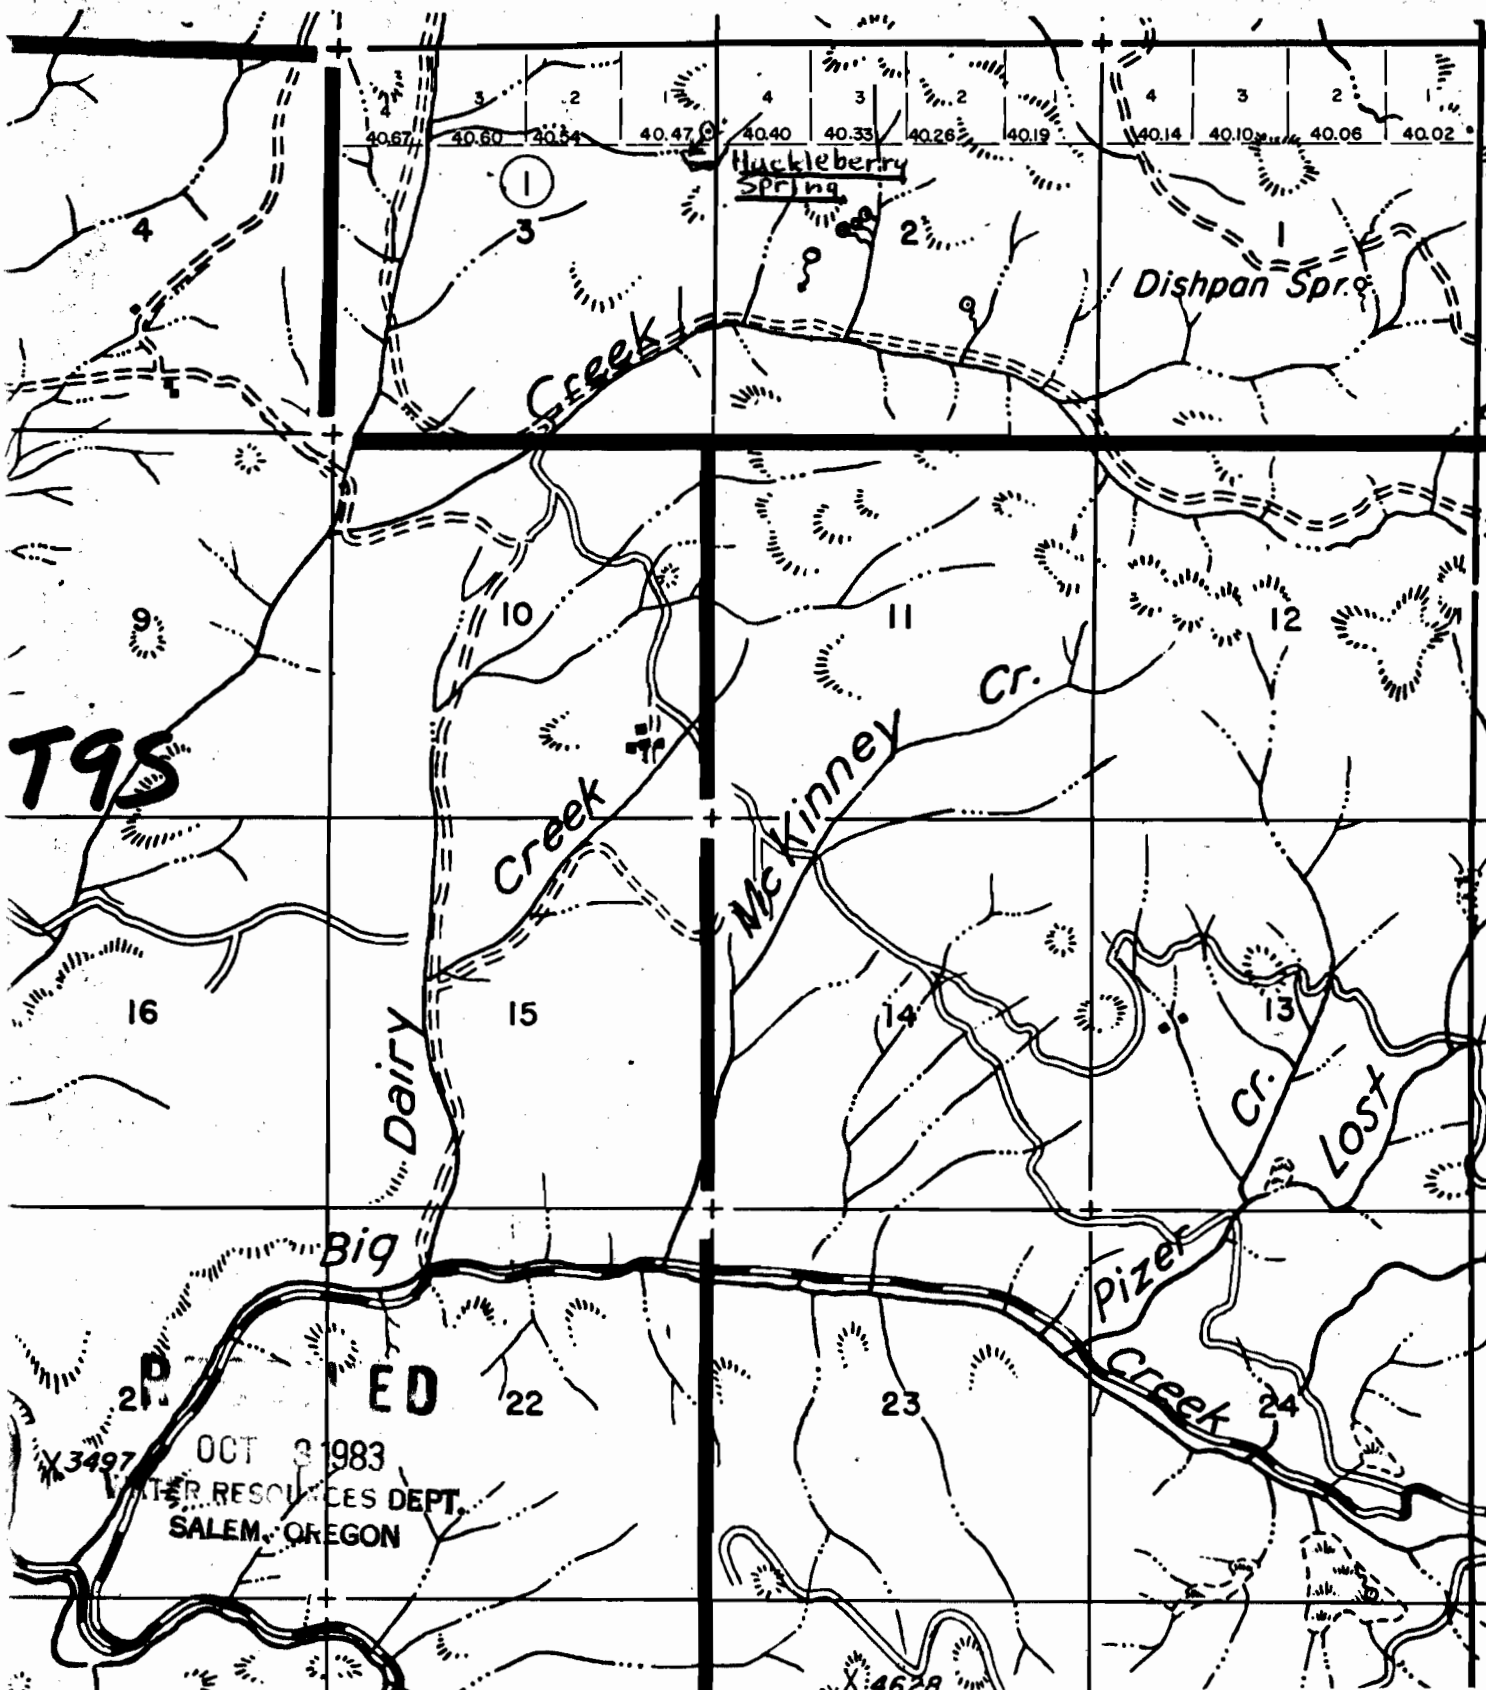

OCT 3 1983
WATER RESOURCES DEPT.
SALEM, OREGON

21

22

Application No.

67140

Patent No.

50393

S H

Ball Spring

Spring 5200

Lost Spr

28

P

ED

8/1983

SALEM, OREGON

4600

5000

Cherry
Spring

Monkey Spring

Dragon Spring

N

T-8 S
R-32 E

4800

