

McKenny
Spring

Dishpan Spring

RECEIVED
OCT 03 1983
WATER RESOURCES DEPT.
SALEM, OREGON

T9S
R32E


Application No. 6714
Permit No. 50894

N

13 Creek

Lost

District Date
Name McKinny Spring Allotment Indian Creek

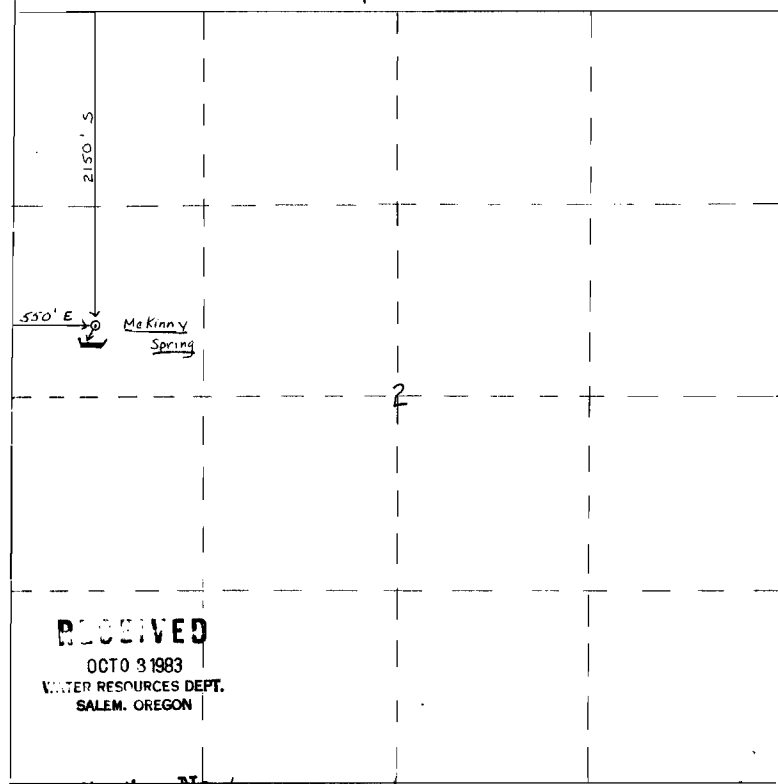

Application No. 67141

Permit No. 50394

Township 9S, Range 32E, Section 2
Scale 1" = 660 FT.

District Dale
Name Dishpan Spg. Allotment Indian Creek

N

1

Dishpan
Spring



1650' W

2550' N

RECEIVED

OCT 03 1983

WATER RESOURCES DEPT.
SALEM, OREGON


Application No. 67141

Permit No. **50394**

Township 9S Range 32E Section 1

Scale 1" = 660 FT.

District Date
Name McKinny Spring Allotment Indian Creek

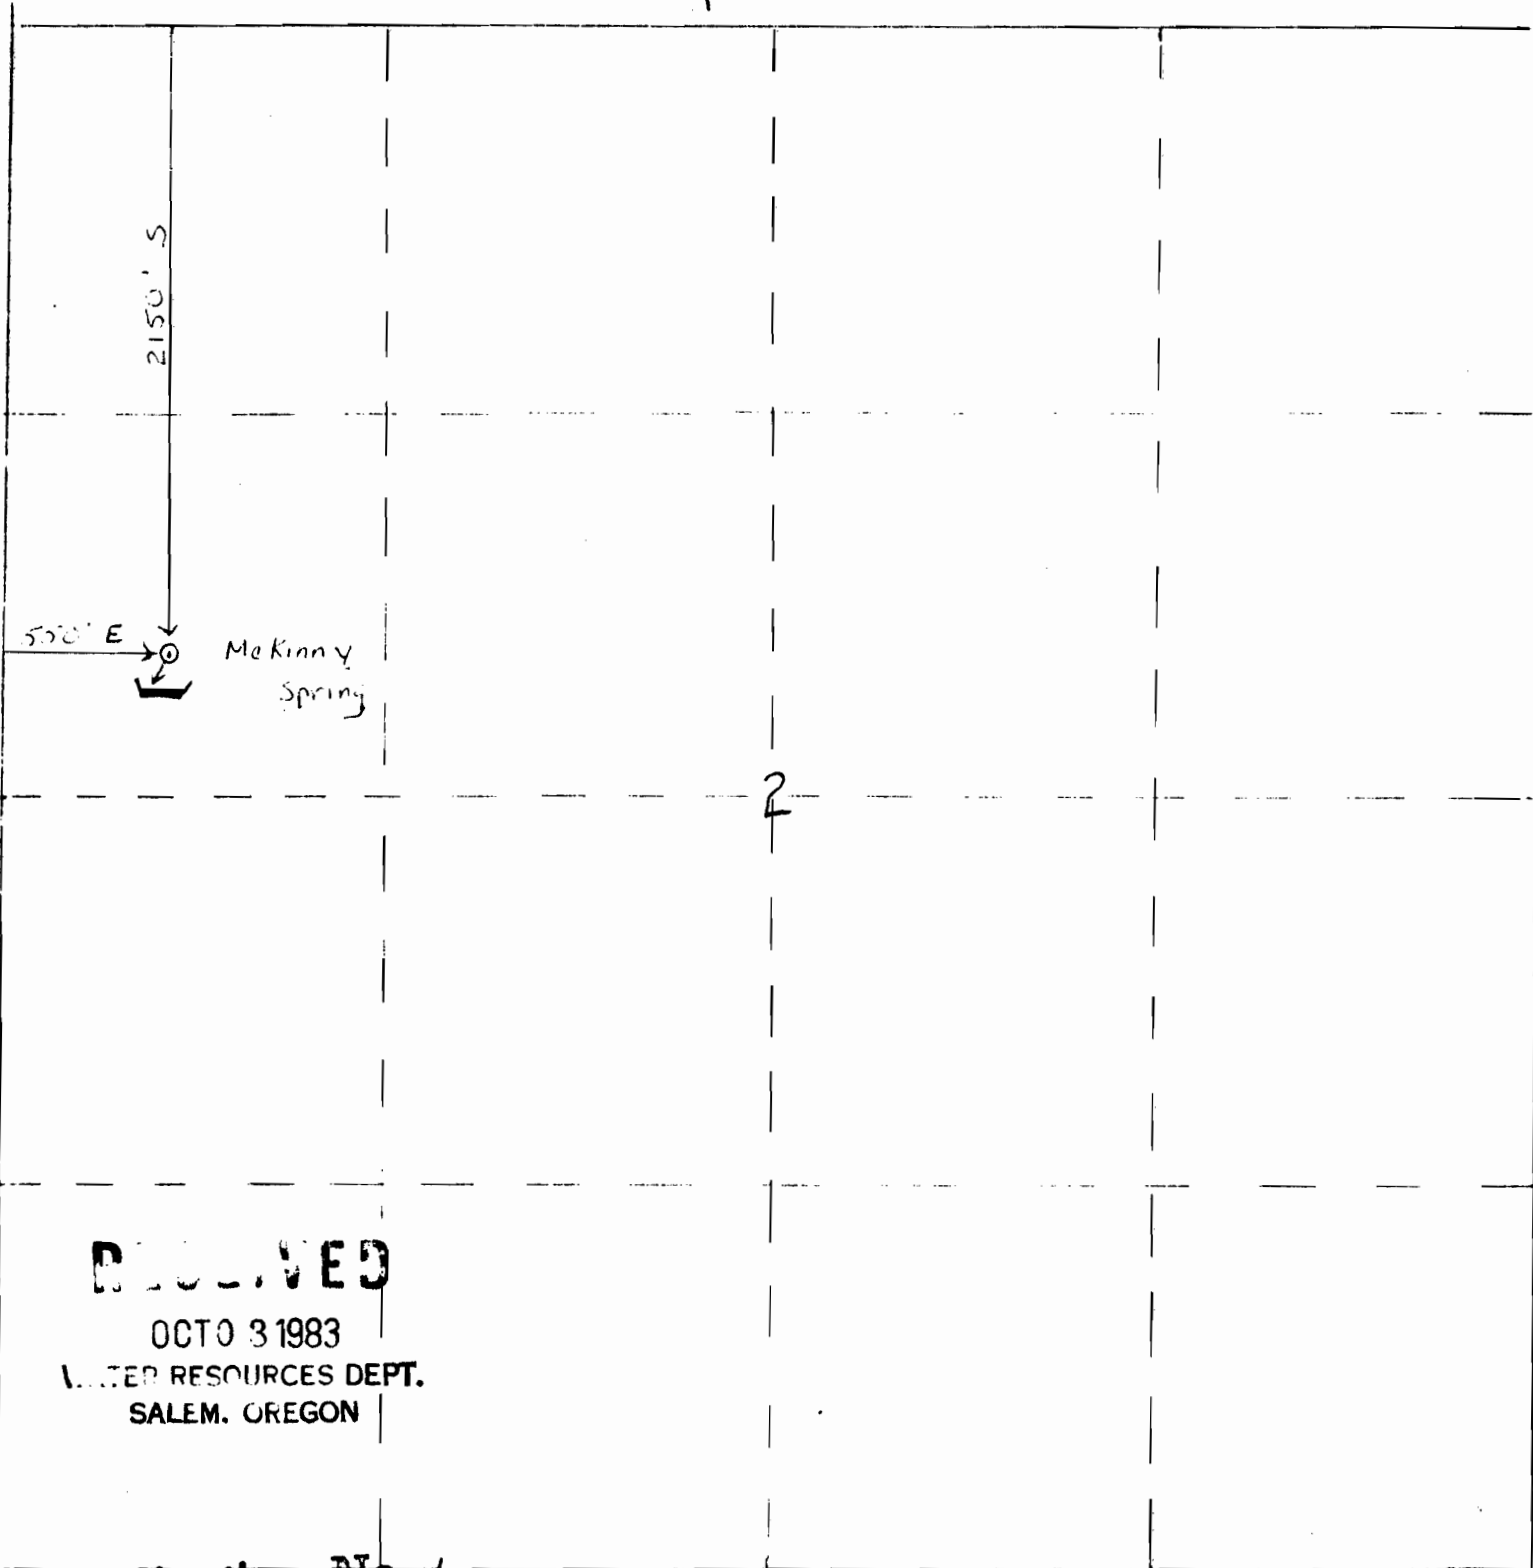

RECEIVED
OCT 03 1983
WATER RESOURCES DEPT.
SALEM, OREGON

Application No. 67141

Permit No. **50394**

Township 9 S. Range 32 E. Section 2

Scale 1" = 660 FT.