


District Dale
Name Park Creek Spring Allotment Indian Creek

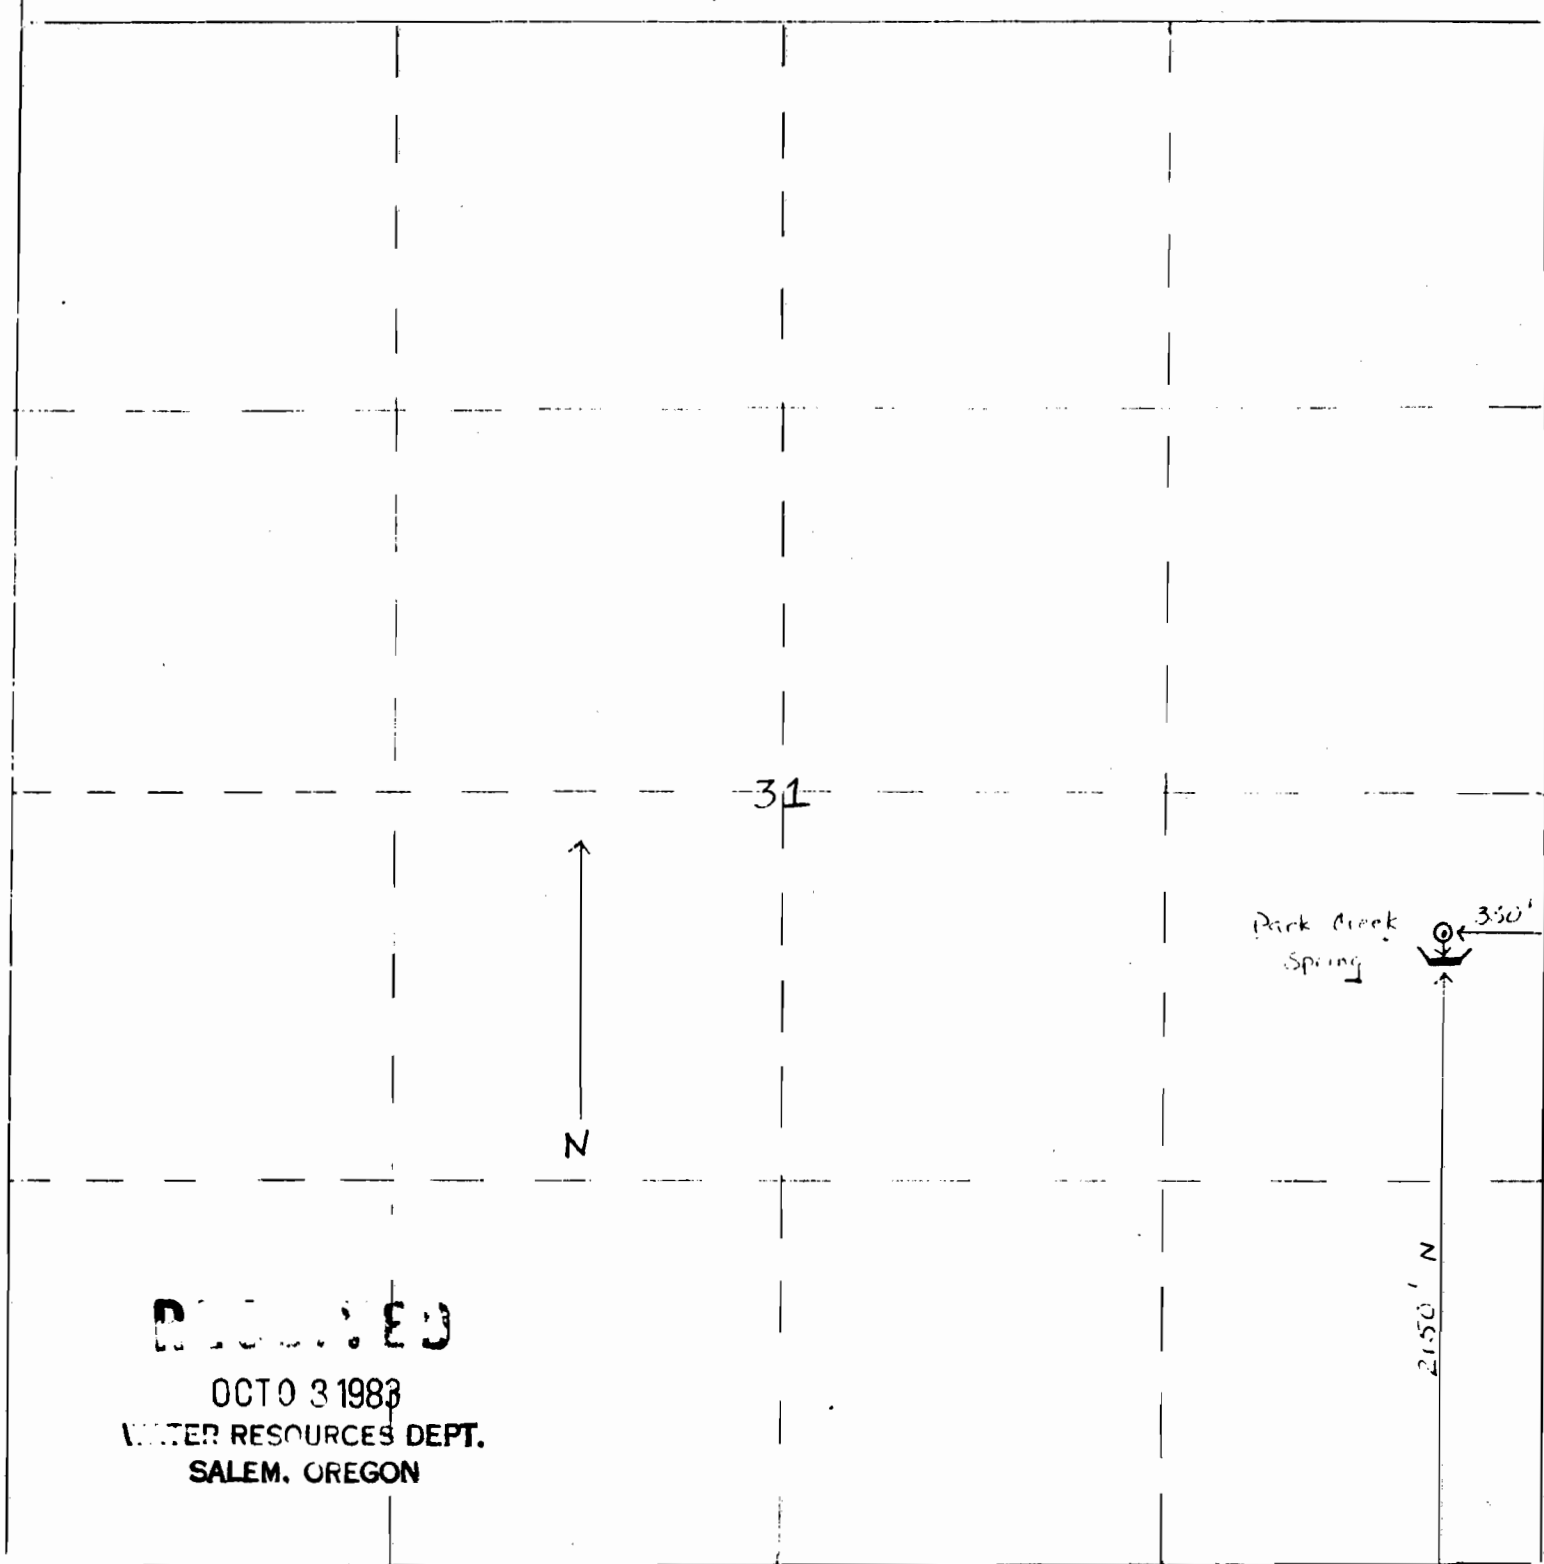

RECEIVED
OCT 03 1983
WATER RESOURCES DEPT.
SALEM, OREGON

Application No. 67142

Permit No. 50395

Township 7S Range 33E Section 31

Scale 1" = 660 FT.

T7S
R33E

N

4600
Kelso

BM 4520

Spring 36 Creek

Park Creek
Spring

Application No. 6744

39 Permit No. 50395

RECEIVED

OCT 3 1983

WATER RESOURCES DEPT
SALEM, OREGON

L

Desolation

Park

6