


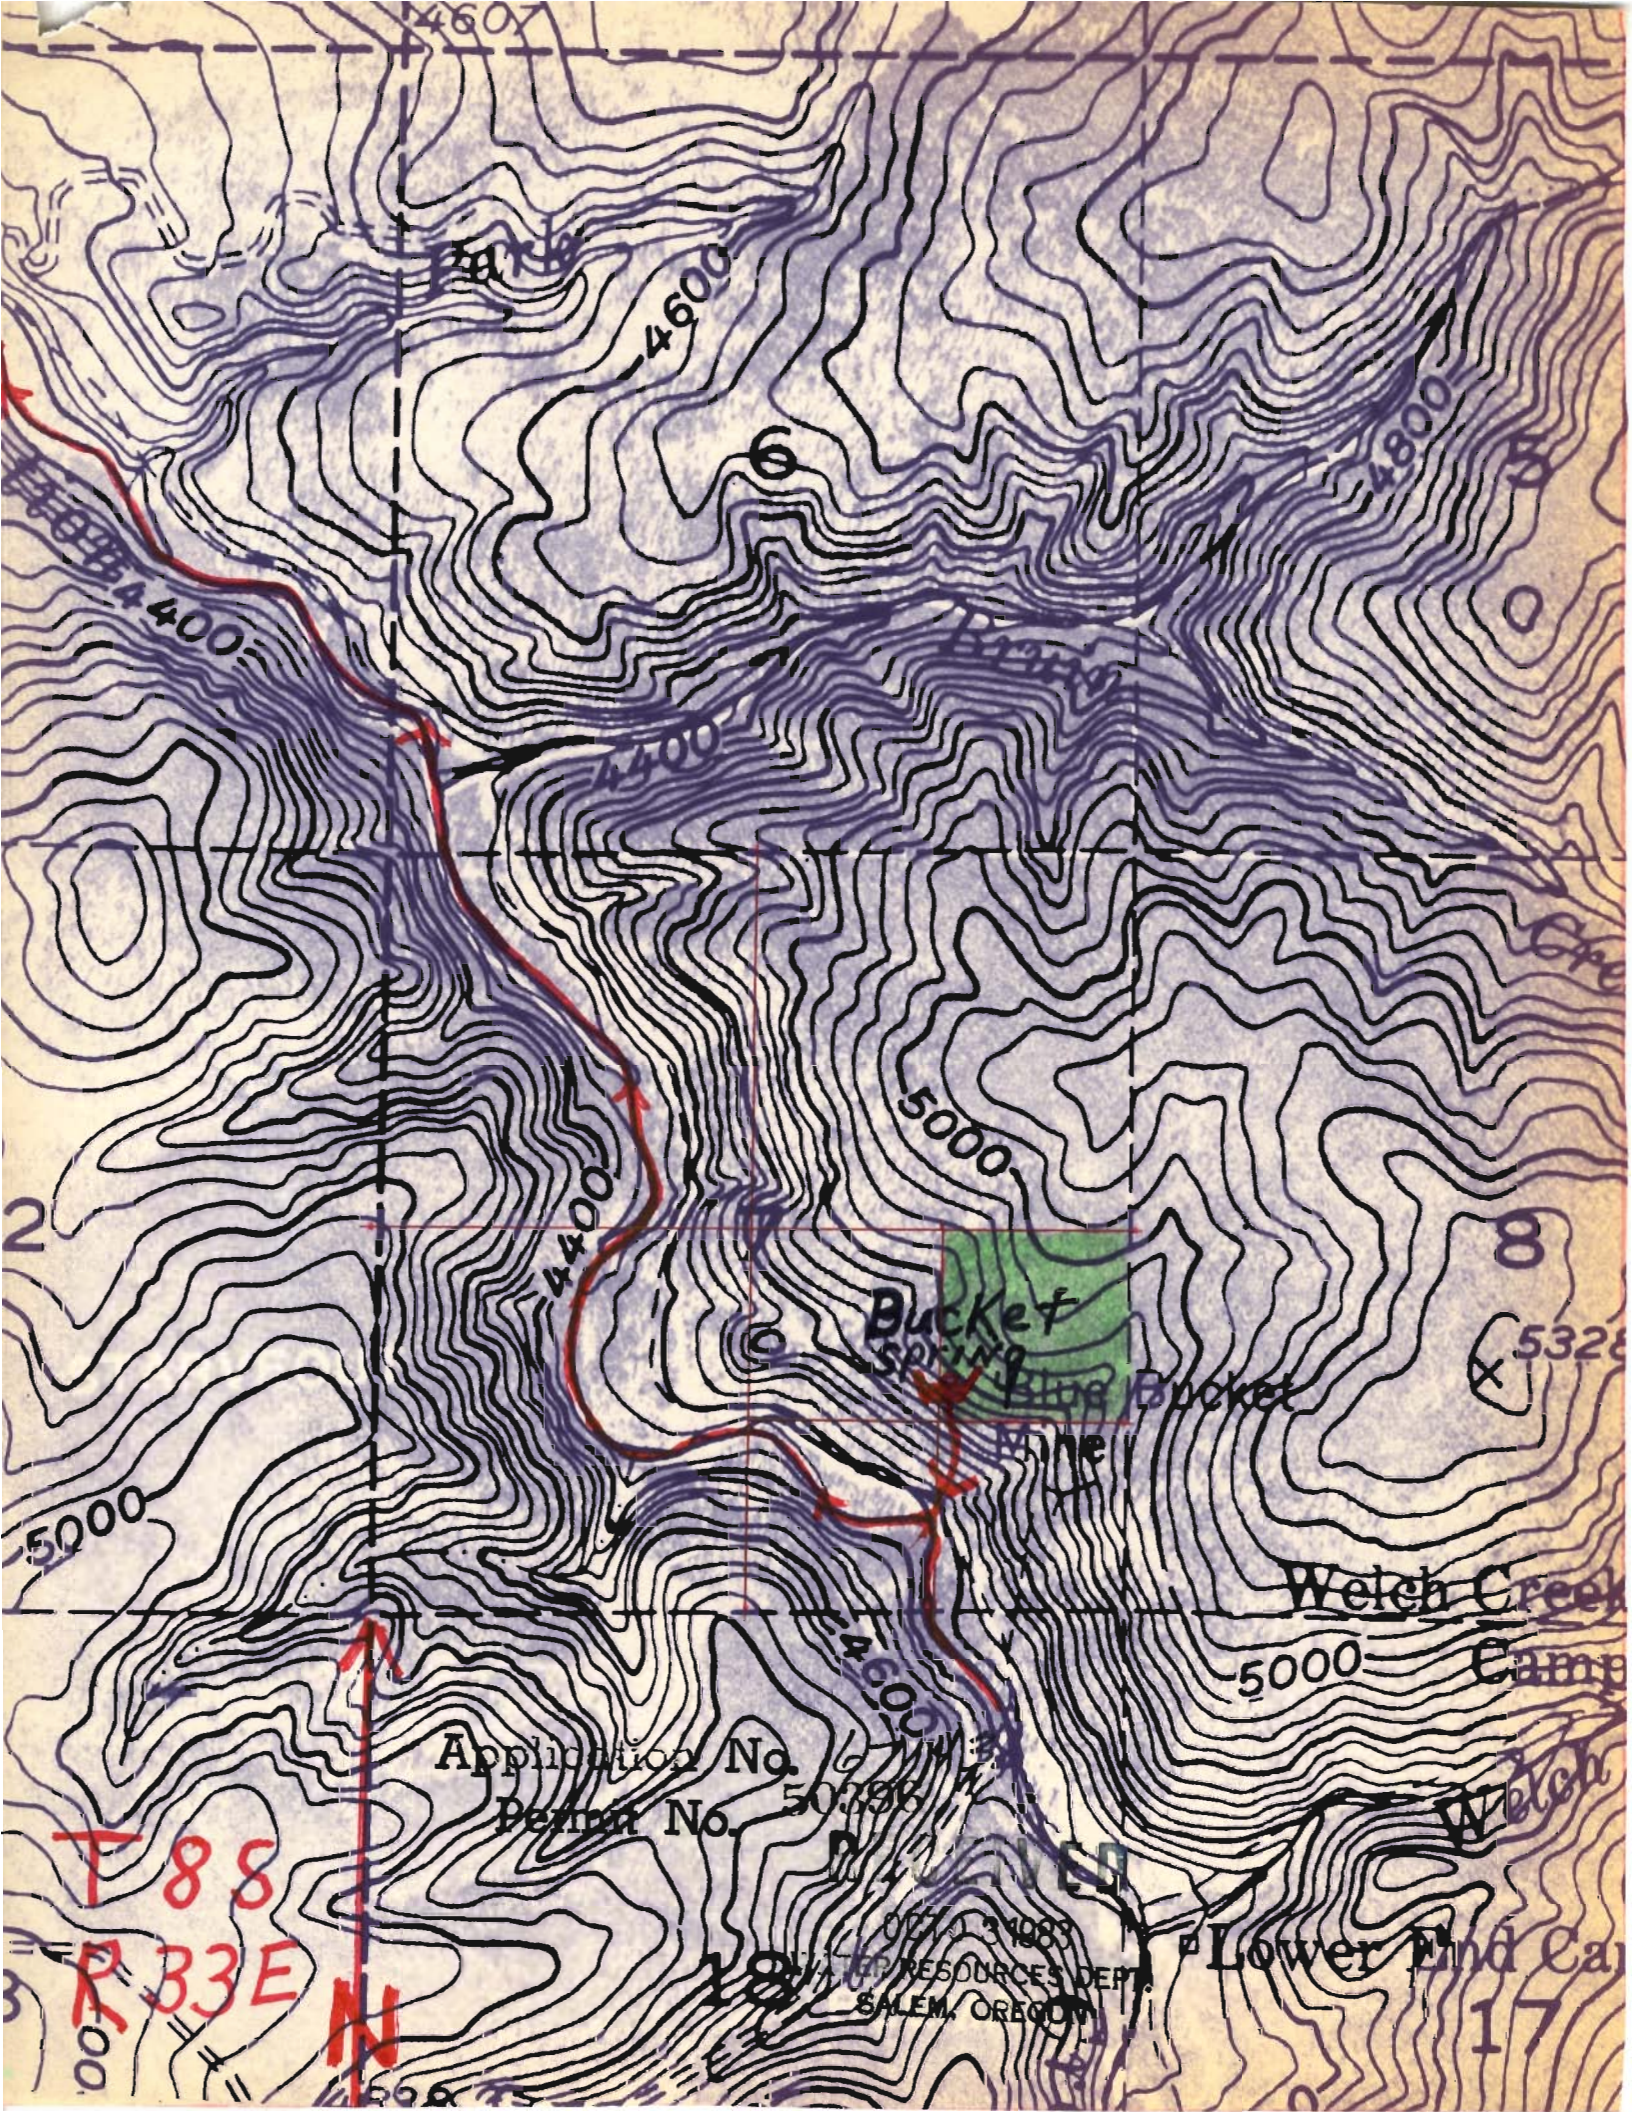

Application No. 61143
Permit No. 50386

007134083


WATER RESOURCES DEPT.
SALEM, OREGON

Lower End Can

17

T 8 S
R 33 E

Name Bucket Spring Allotment Indian Creek

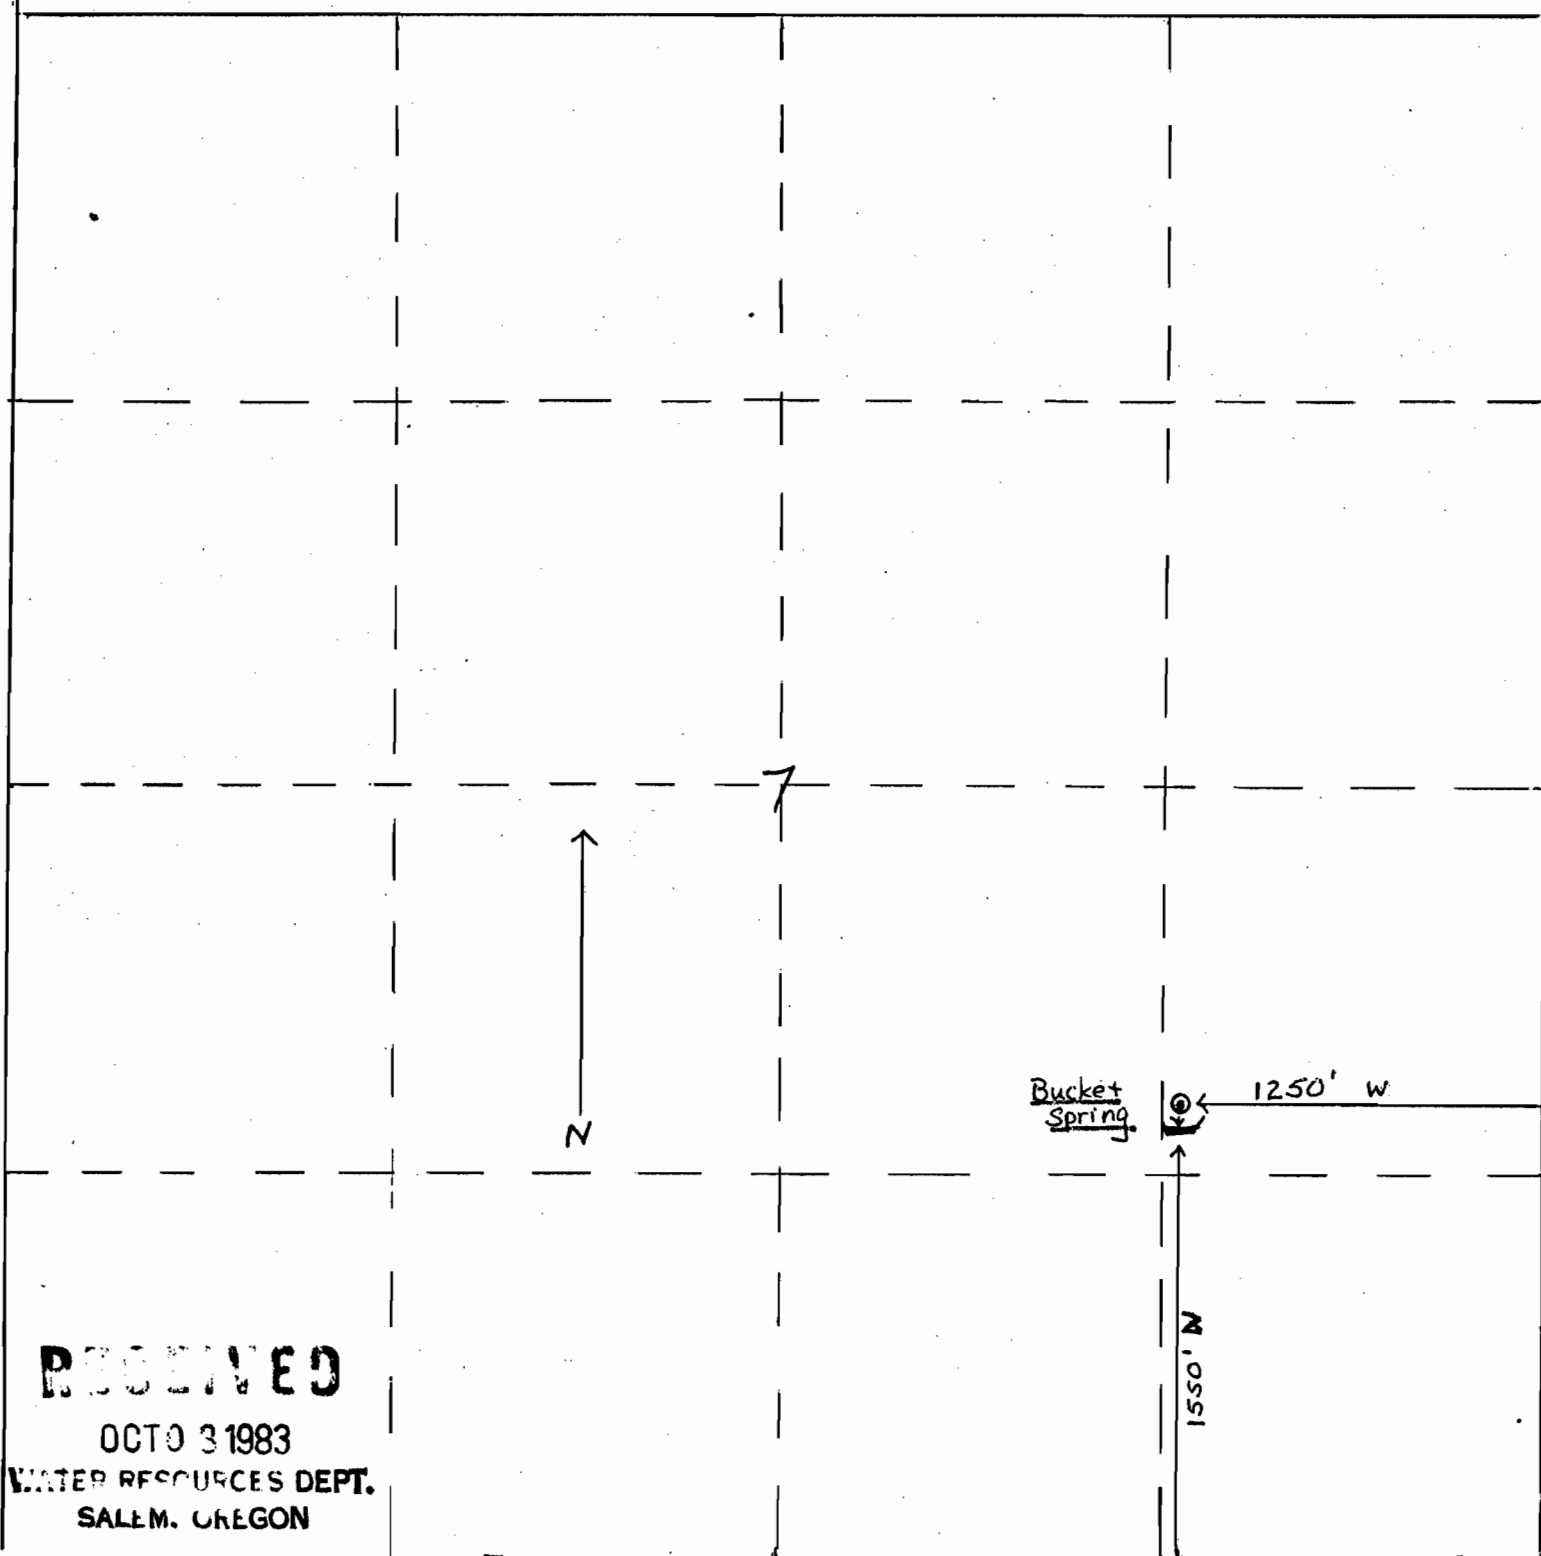

RECEIVED

OCT 03 1983

WATER RESOURCES DEPT.

SALEM, OREGON

Application No. 67143

Permit No. 50396

Township 8S, Range 33E, Section 7

Scale 1" = 660 FT.