

District _____ Date _____

Name Handy Spring Allotment Indian Creek

1300' E

1650' S



Handy Spring



13

RECEIVED

OCT 13 1983


LAND RESOURCES DEPT.
SALEM, OREGON

Application No. 67144

Permit No. 50397

Township 8 S. Range 33 E. Section 13

Scale 1" = 660 FT

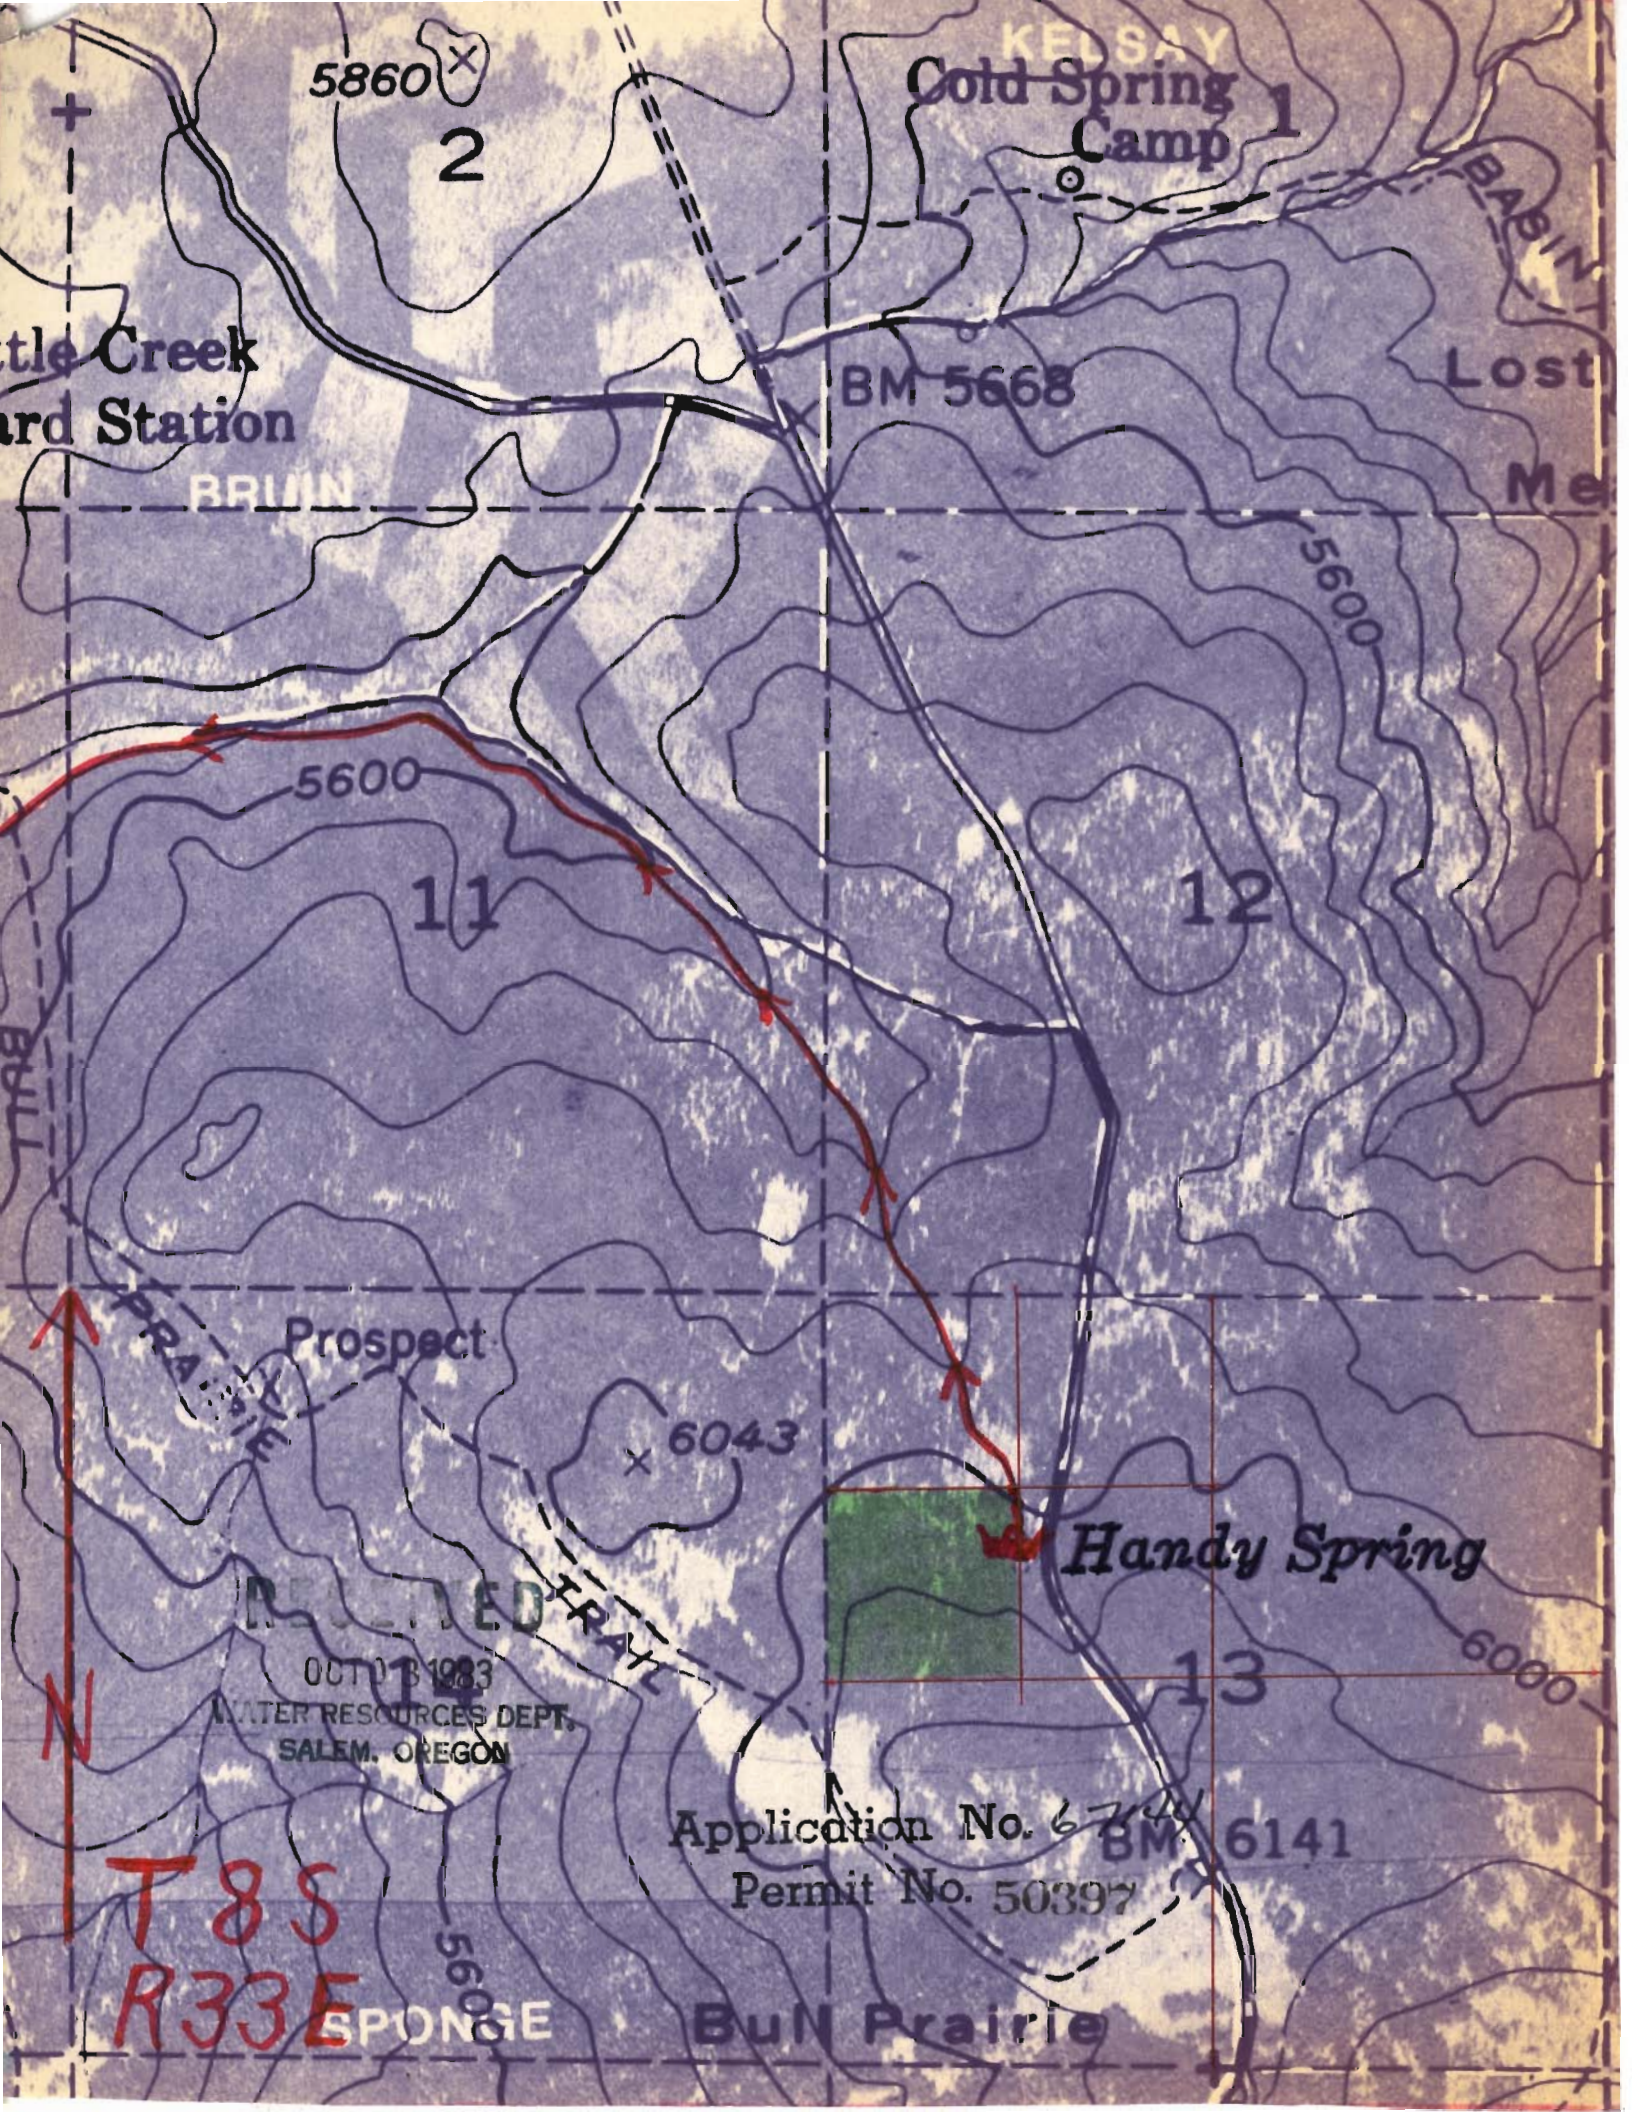

5860

2

KELSA
Cold Spring
Camp

tle Creek
ard Station

BRAIN

BM 5668

Lost

Me

5600

5600

11

12

Prospect

6043

Handy Spring

6000

RECEIVED

OCT 13 1983

WATER RESOURCES DEPT.
SALEM, OREGON

Application No. 6744

Permit No. 50397

BM 6141

13

N

T8S
R33E

SPONGE

Bull Prairie