


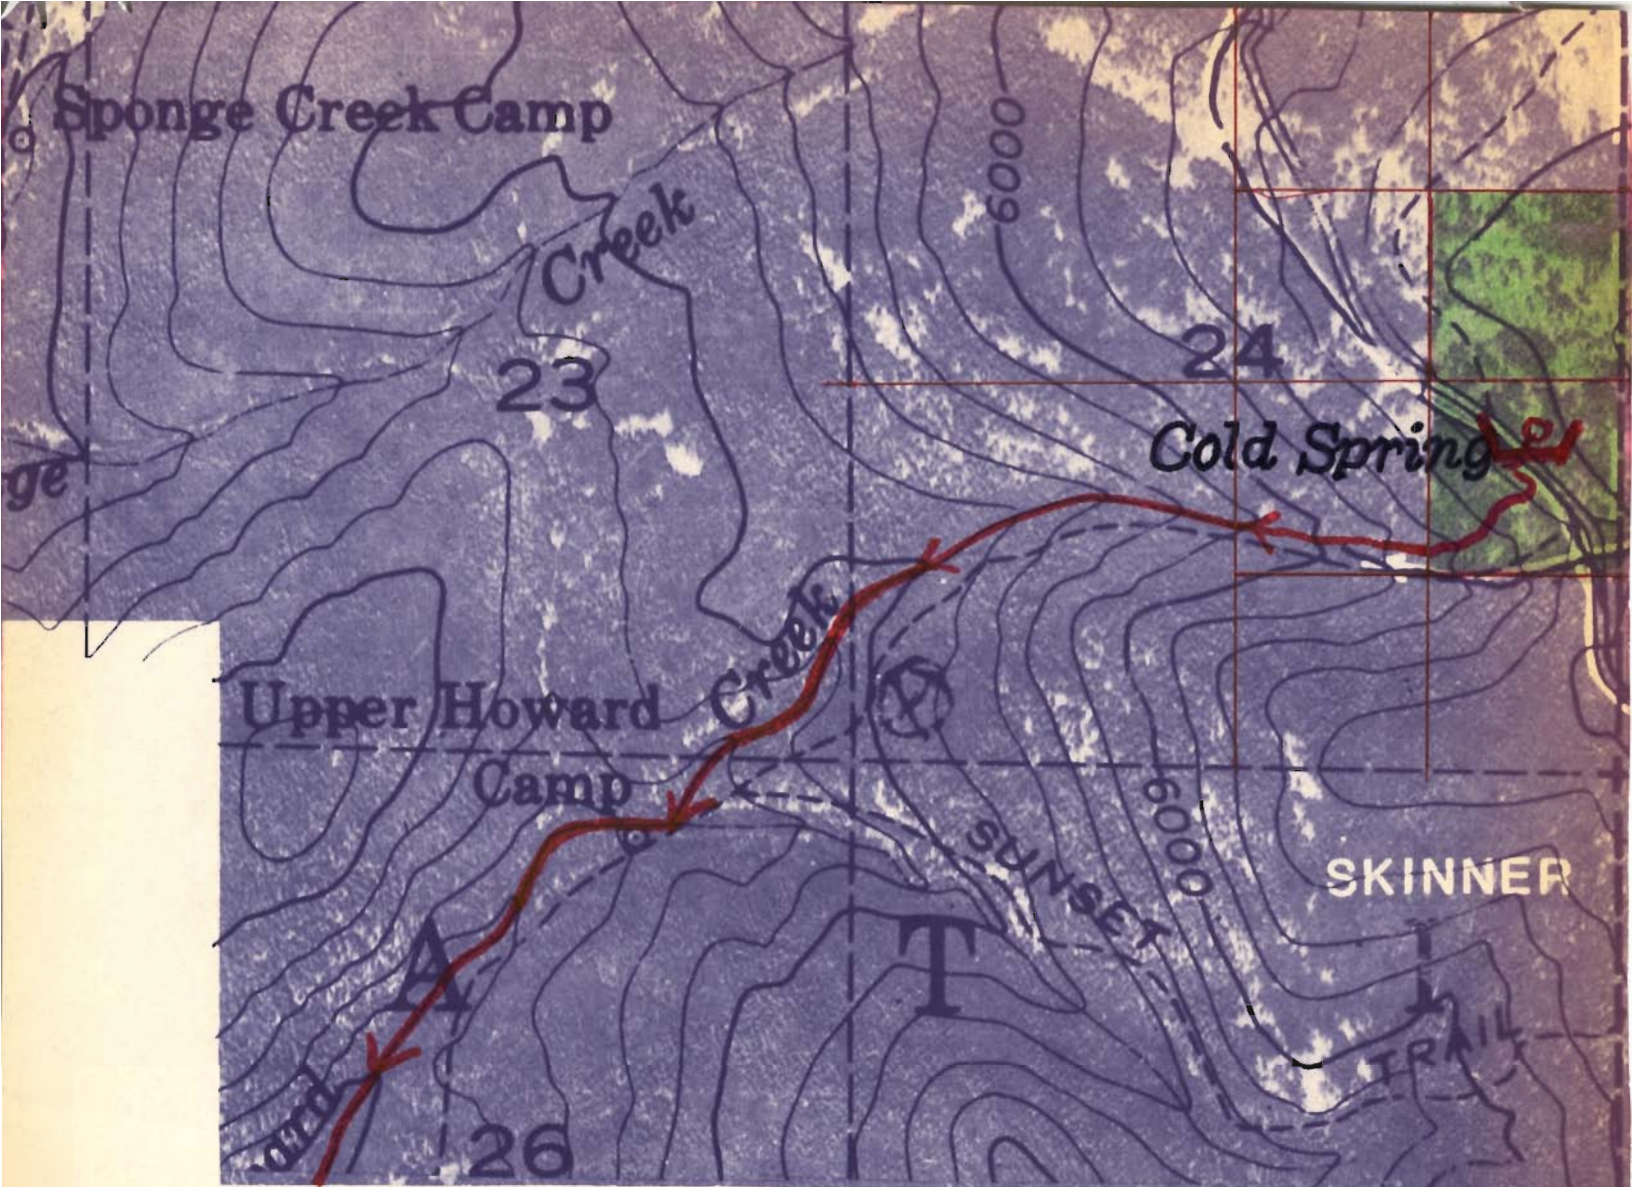

TRI COMPARTMENT PHOTOMAP		
ADMINISTERING NF NUMBER: 14	FOREST NAME: Umatilla	STATE CODE: 41
RANGER DISTRICT NUMBER: 01	DISTRICT NAME: Dale	PROCLAIMED NF NUMBER: 432
COMPARTMENT NUMBER: 1407	COMPARTMENT NAME: HANDY	
DATE PHOTOMAP CONSTRUCTED: October 1979	DATE PHOTOMAP REVISED:	
ORTHOPHOTOS Aerial MADE FROM: Photo Year-1976	Aerial Photo Identification Code- 41061	
0 1 2 3 4		↑ N
FINISHED PHOTOMAP SCALE: 4 in. = 1 mile		


Application No. 67145
Permit No. 50398

RECEIVED
OCT 3 1983
WATER RESOURCES DEPT.
SALEM, OREGON

District _____ Date _____

Name Cold Spring

Allotment Indian Creek

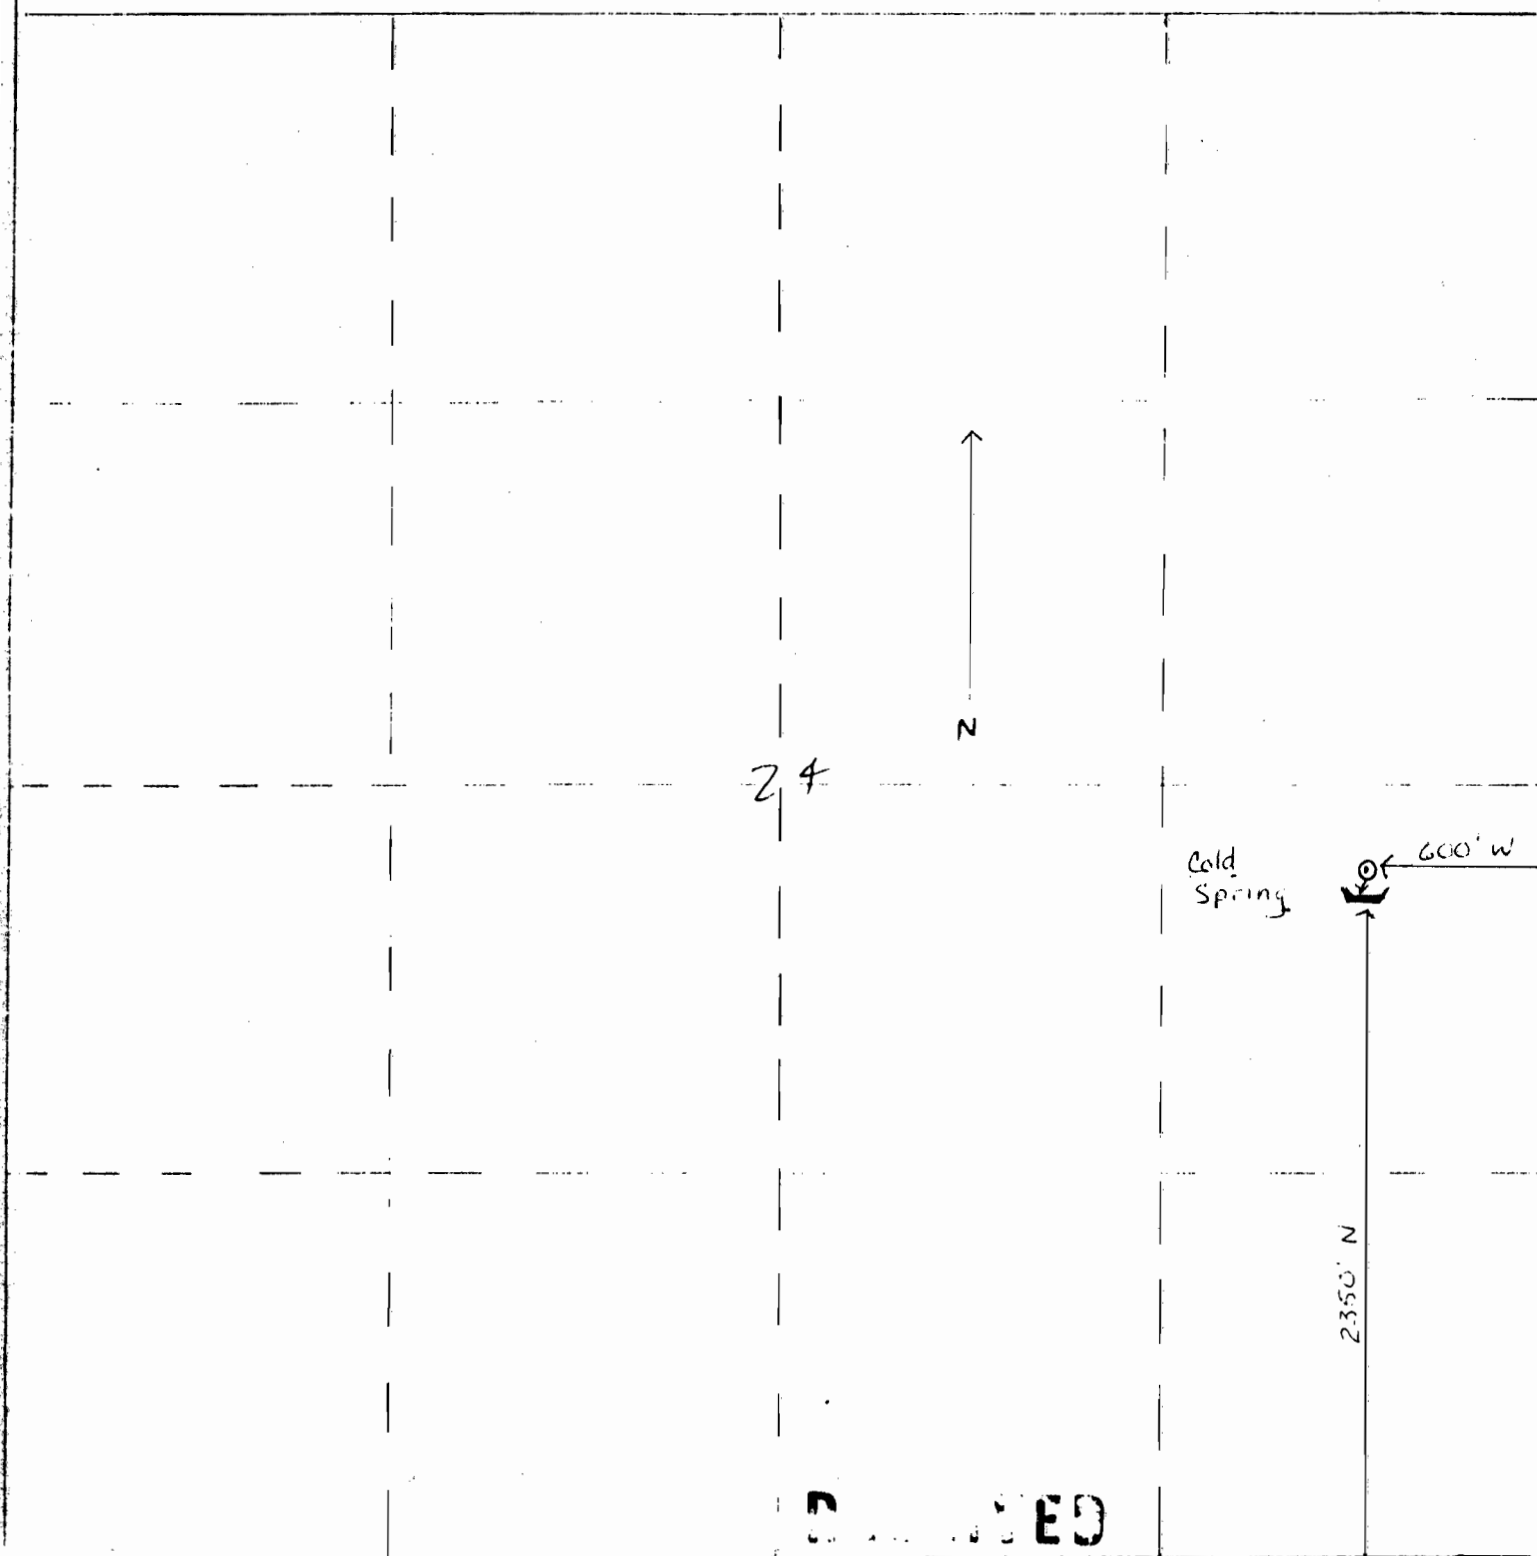

RECEIVED

Application No. 67145
Permit No. 50398

OCT 3 1983
LAND RESOURCES DEPT.
SALEM, OREGON

Township SS Range 33E Section 24
Scale 1" = 660 FT