


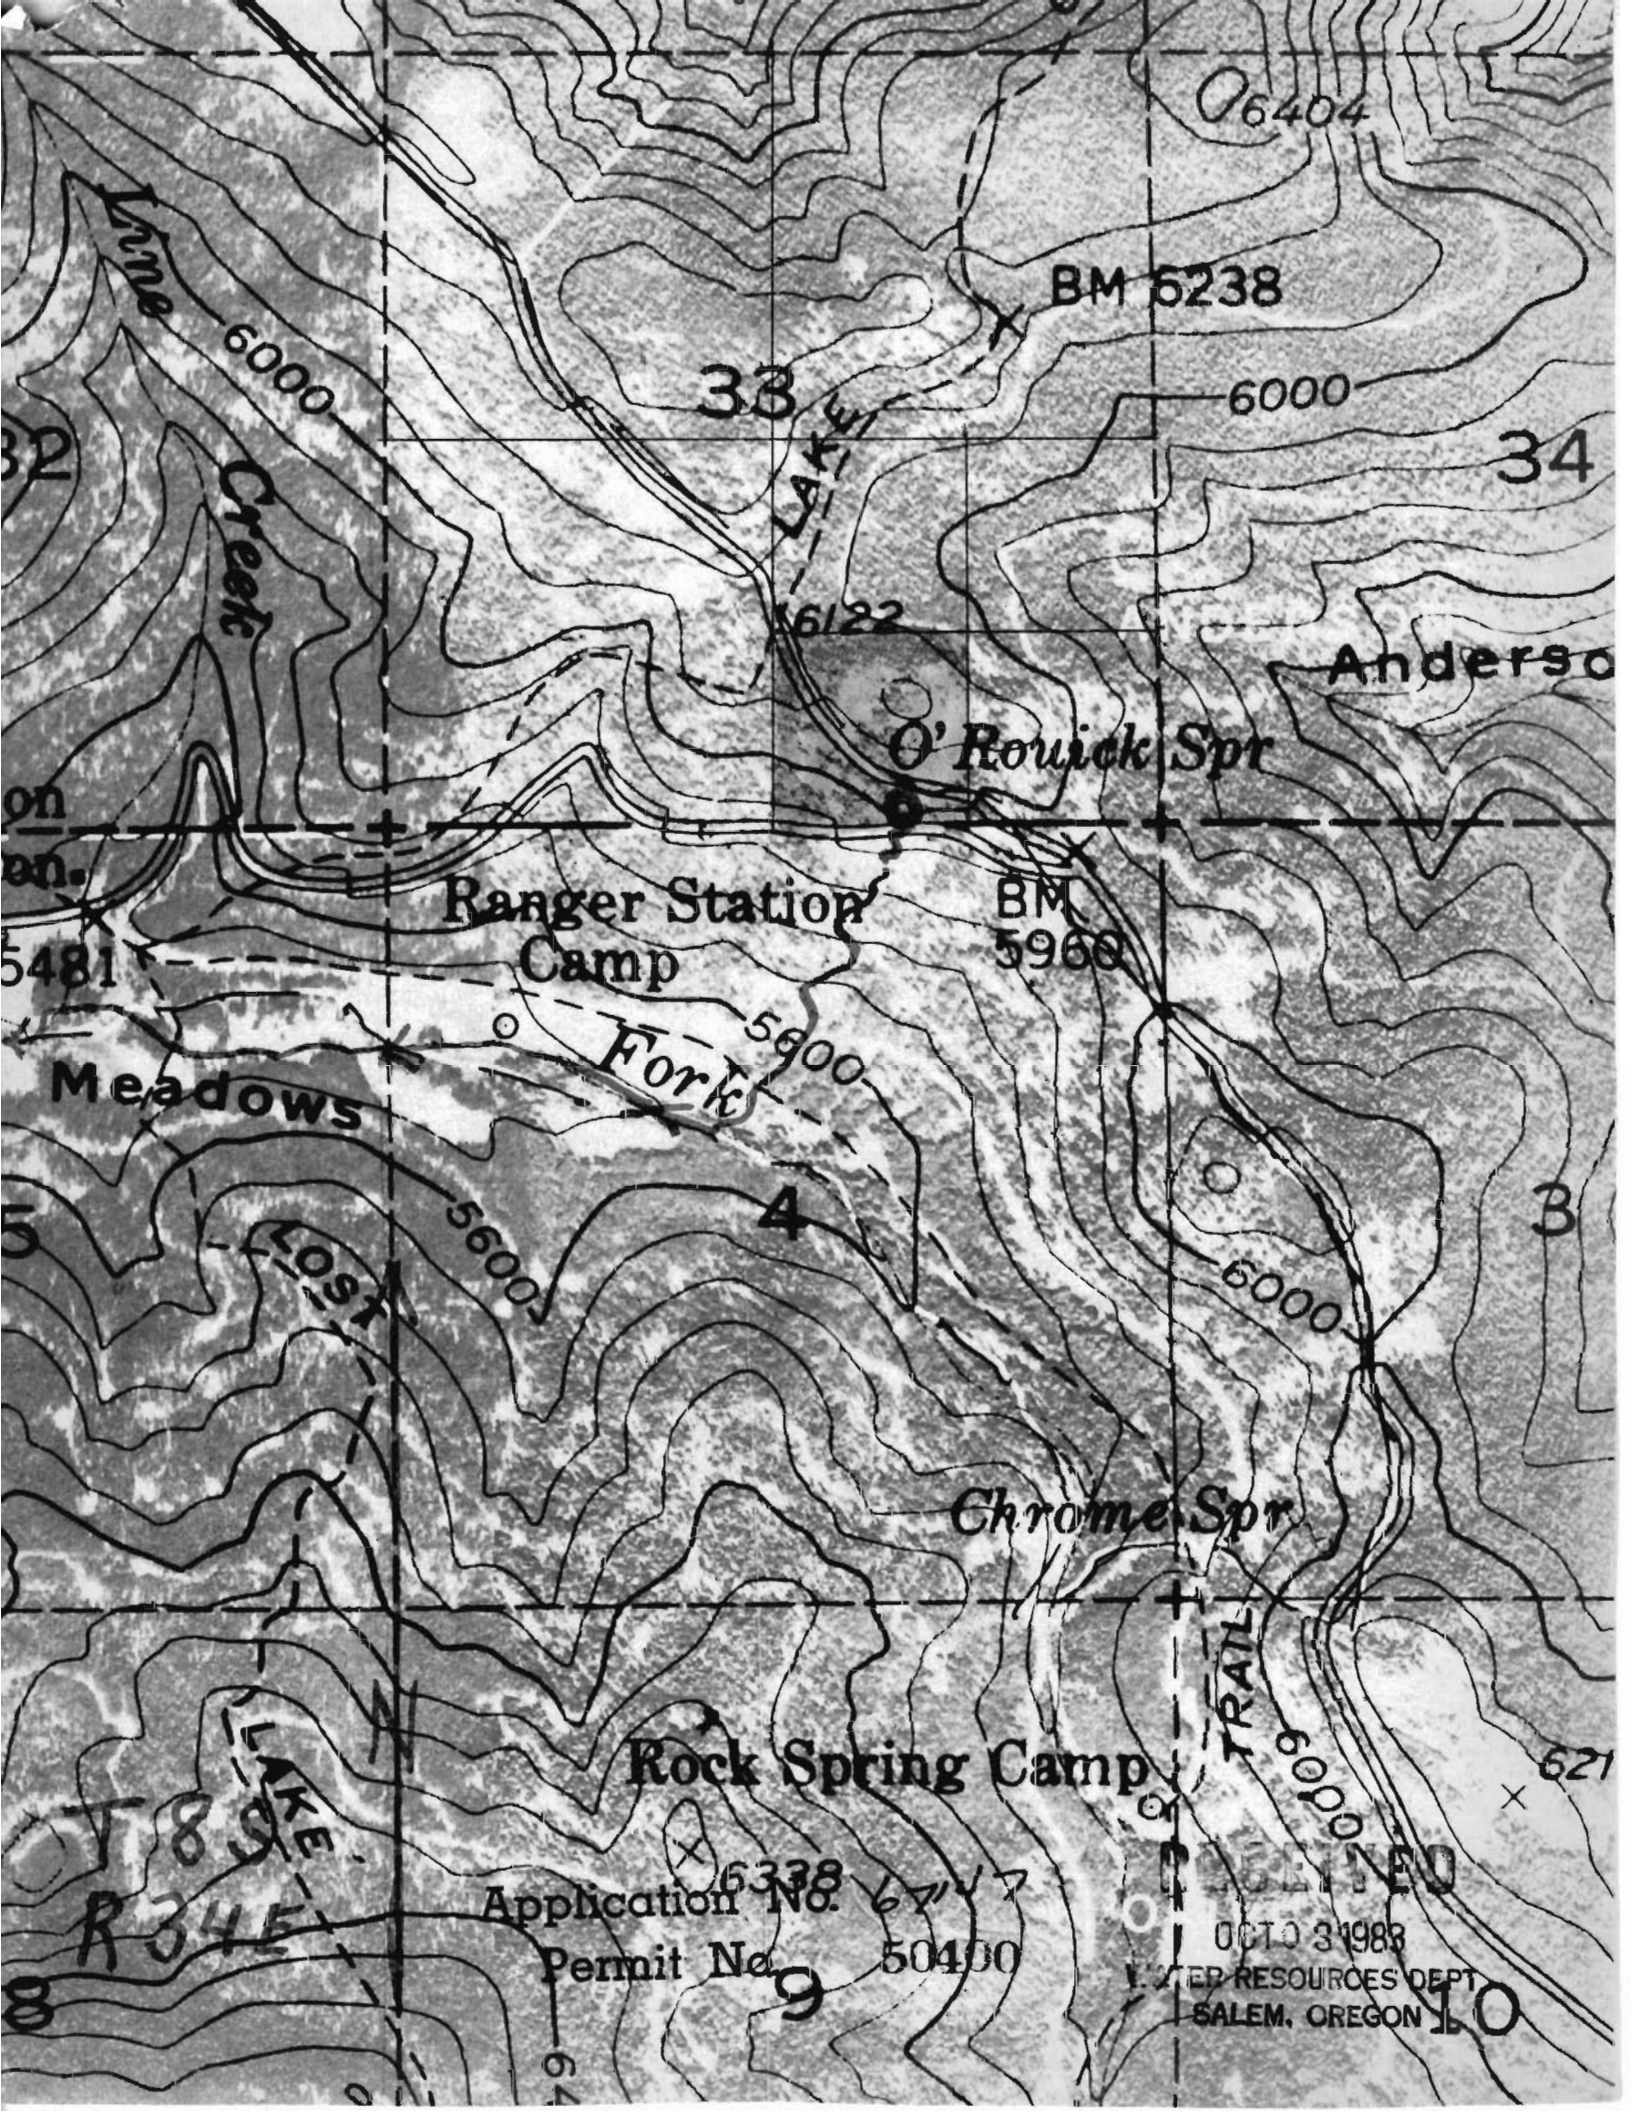

on
en.

5481

5

8

33

34

4

3

9

10

Ranger Station
Camp

BM
5968

Fork

Chrome Spr

Rock Spring Camp

Application No. 6717
Permit No. 50400

BM 6238

O' Rouick Spr

Anderso

6404

621

OCT 3 1988

WATER RESOURCES DEPT
SALEM, OREGON

T89
R345

RECEIVED

District Date

Name O'Rourke Spring Allotment Indian Creek

33



RECEIVED

OCT 2 1983

WATER RESOURCES DEPT.
SALEM, OREGON

O'Rourke Spring

1750' W

1.25

Σ 100' N

Application No. 67147

Permit No. 50400

Township p 8 S, Range 34 E Section 33

Scale 1" = 660 FT.