

District _____ Date _____
Name Coil Spring Allotment Indian Creek

1500' S
Coil Spring 450' W

N

6


Application No. 67149

Permit No. **50402**

Township 8S. Range 32E. Section 6 007031983

Scale 1" = 660 FT

RECEIVED
SALEM, OREGON

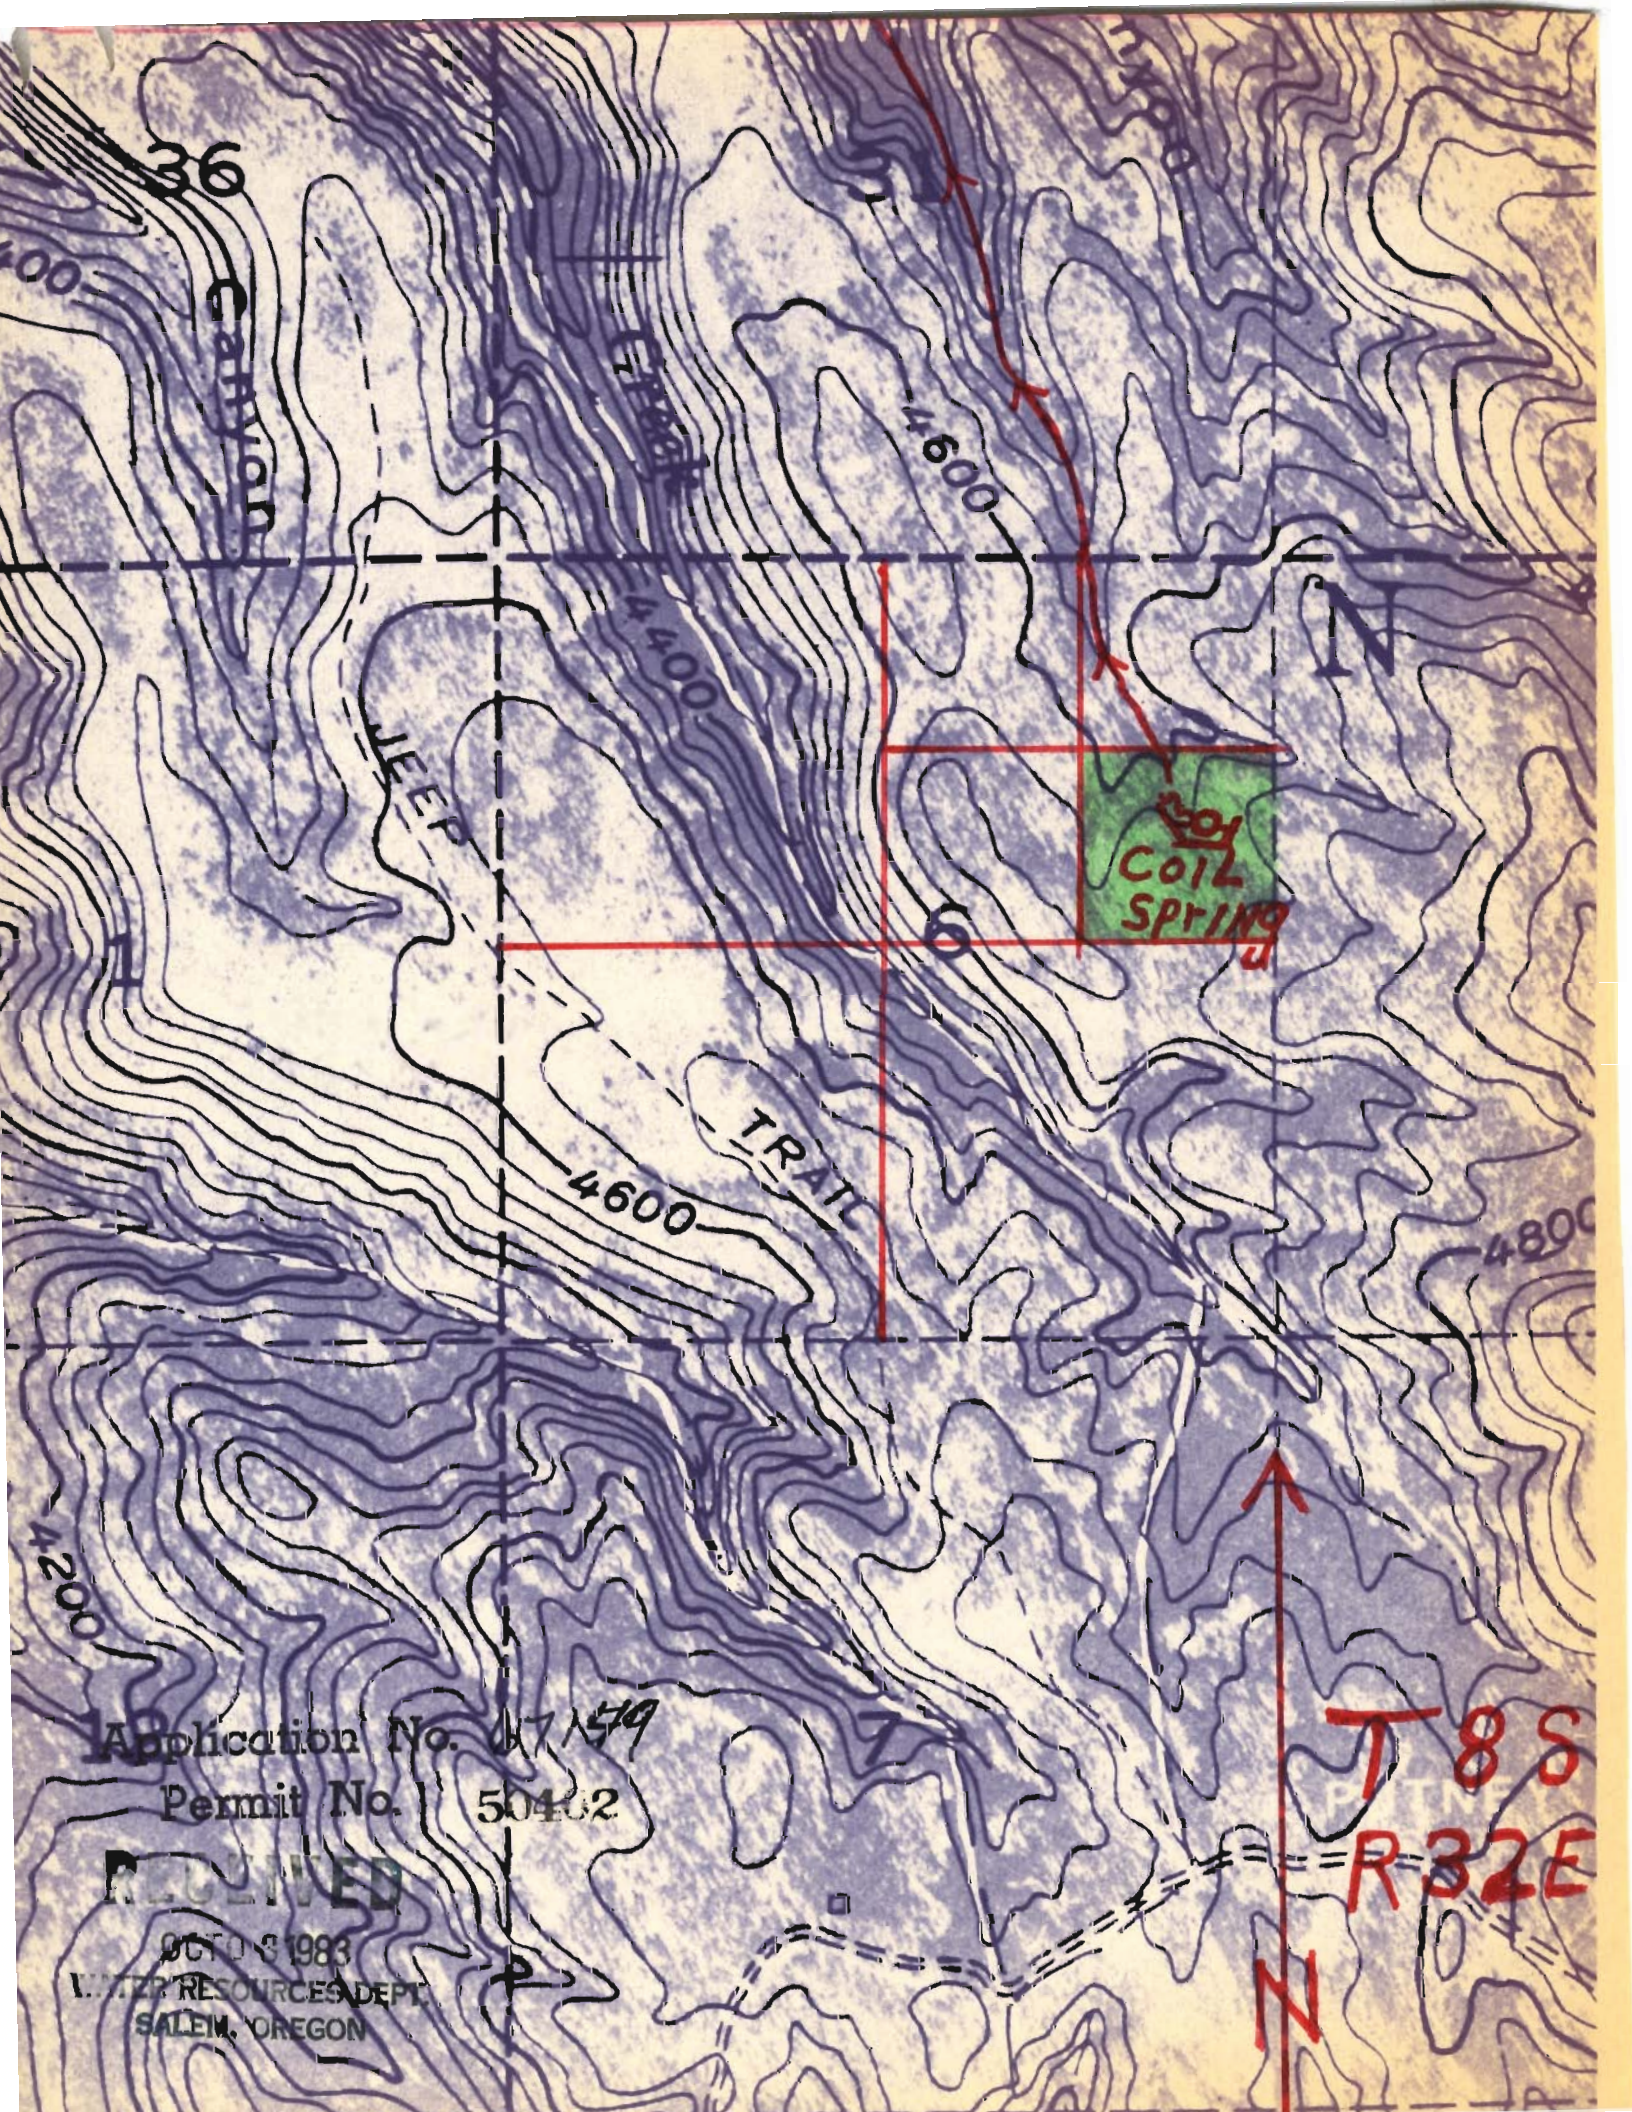

Application No. 471519

Permit No. 50402

RECEIVED

OCT 13 1983

WATER RESOURCES DEPT.
SALEM, OREGON