


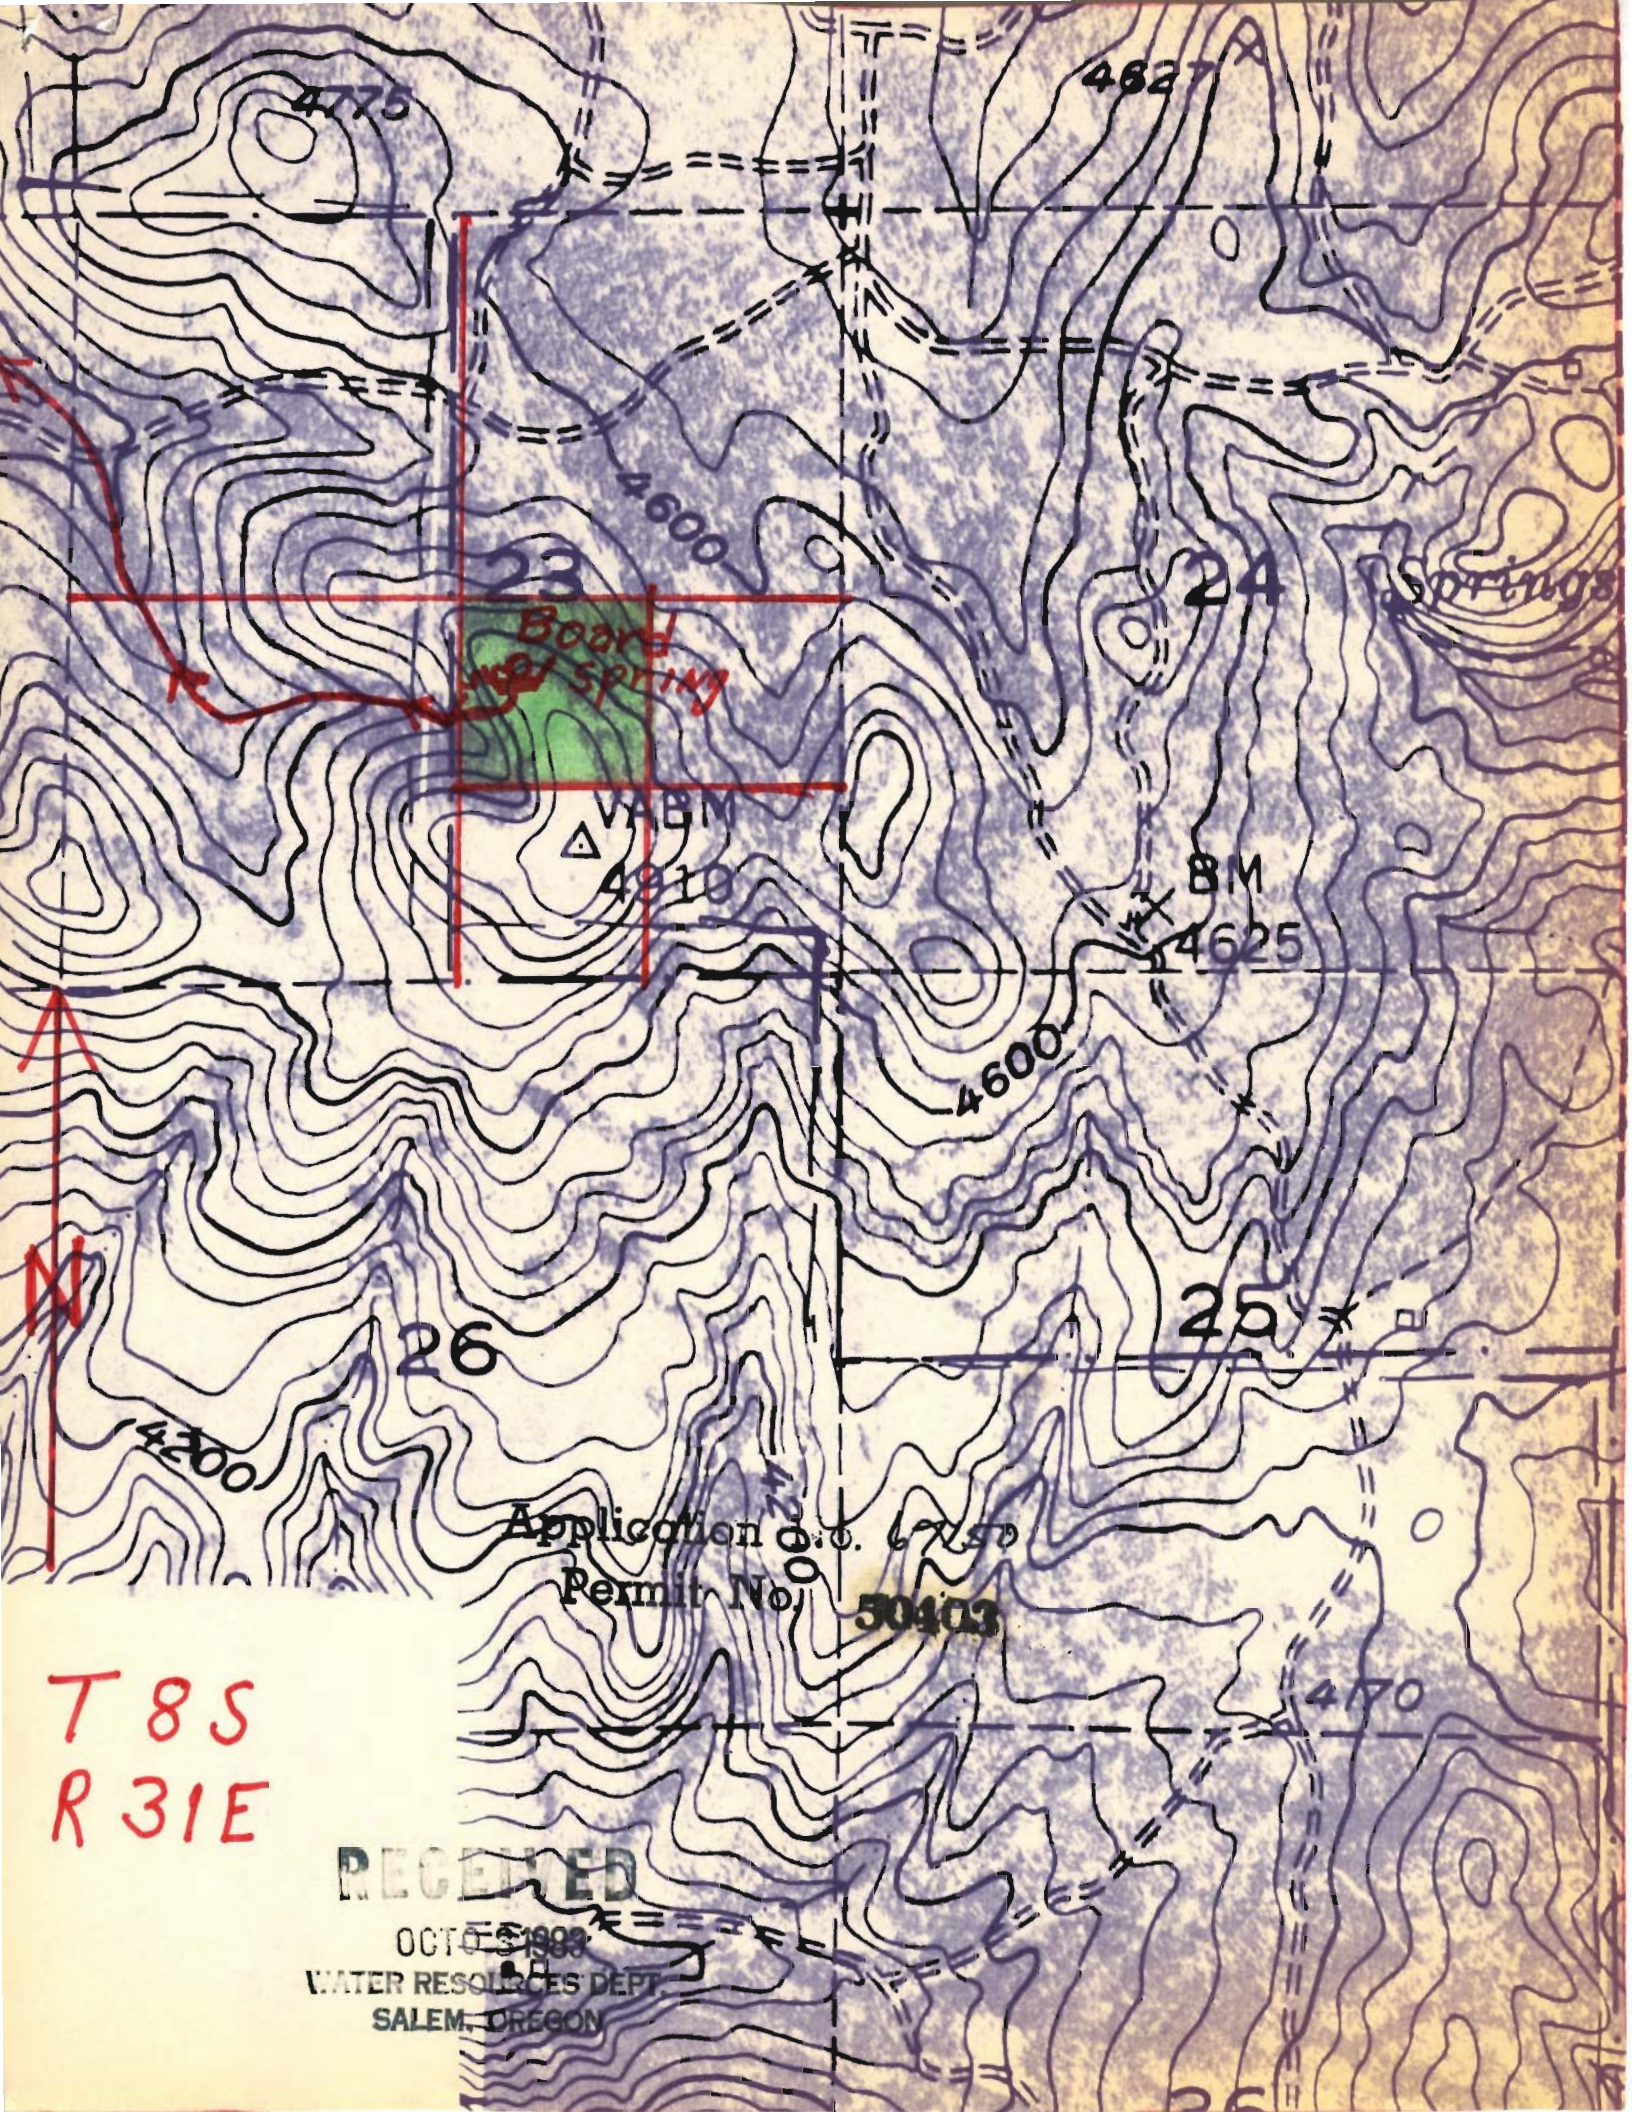

N

T 8 S
R 31 E

RECEIVED
OCT 5 1988
WATER RESOURCES DEPT.
SALEM, OREGON

Application O.O. 6750
Permit No. 50403

District Date

Name Board Spring Allotment Indian Creek



Board
Spring



2200' W

2150' N

Application No. 67150

Permit No. 50403

Township 8 S. Range 31 E Section 23

Scale 1" = 660 ft.

RECEIVED

0010 81983

SALEM, OREGON