

District _____ Dale _____
Name Lick Spring Allotment Indian Creek

1850' E

1550' S



LICK
SPRING

25




Application No. 67151

Permit No. 50404

Township 8S Range 31E Section 25

Scale 1" = 660 FT

RECEIVED
001031983
UNITED RESOURCES DEPT
SALEM, OREGON

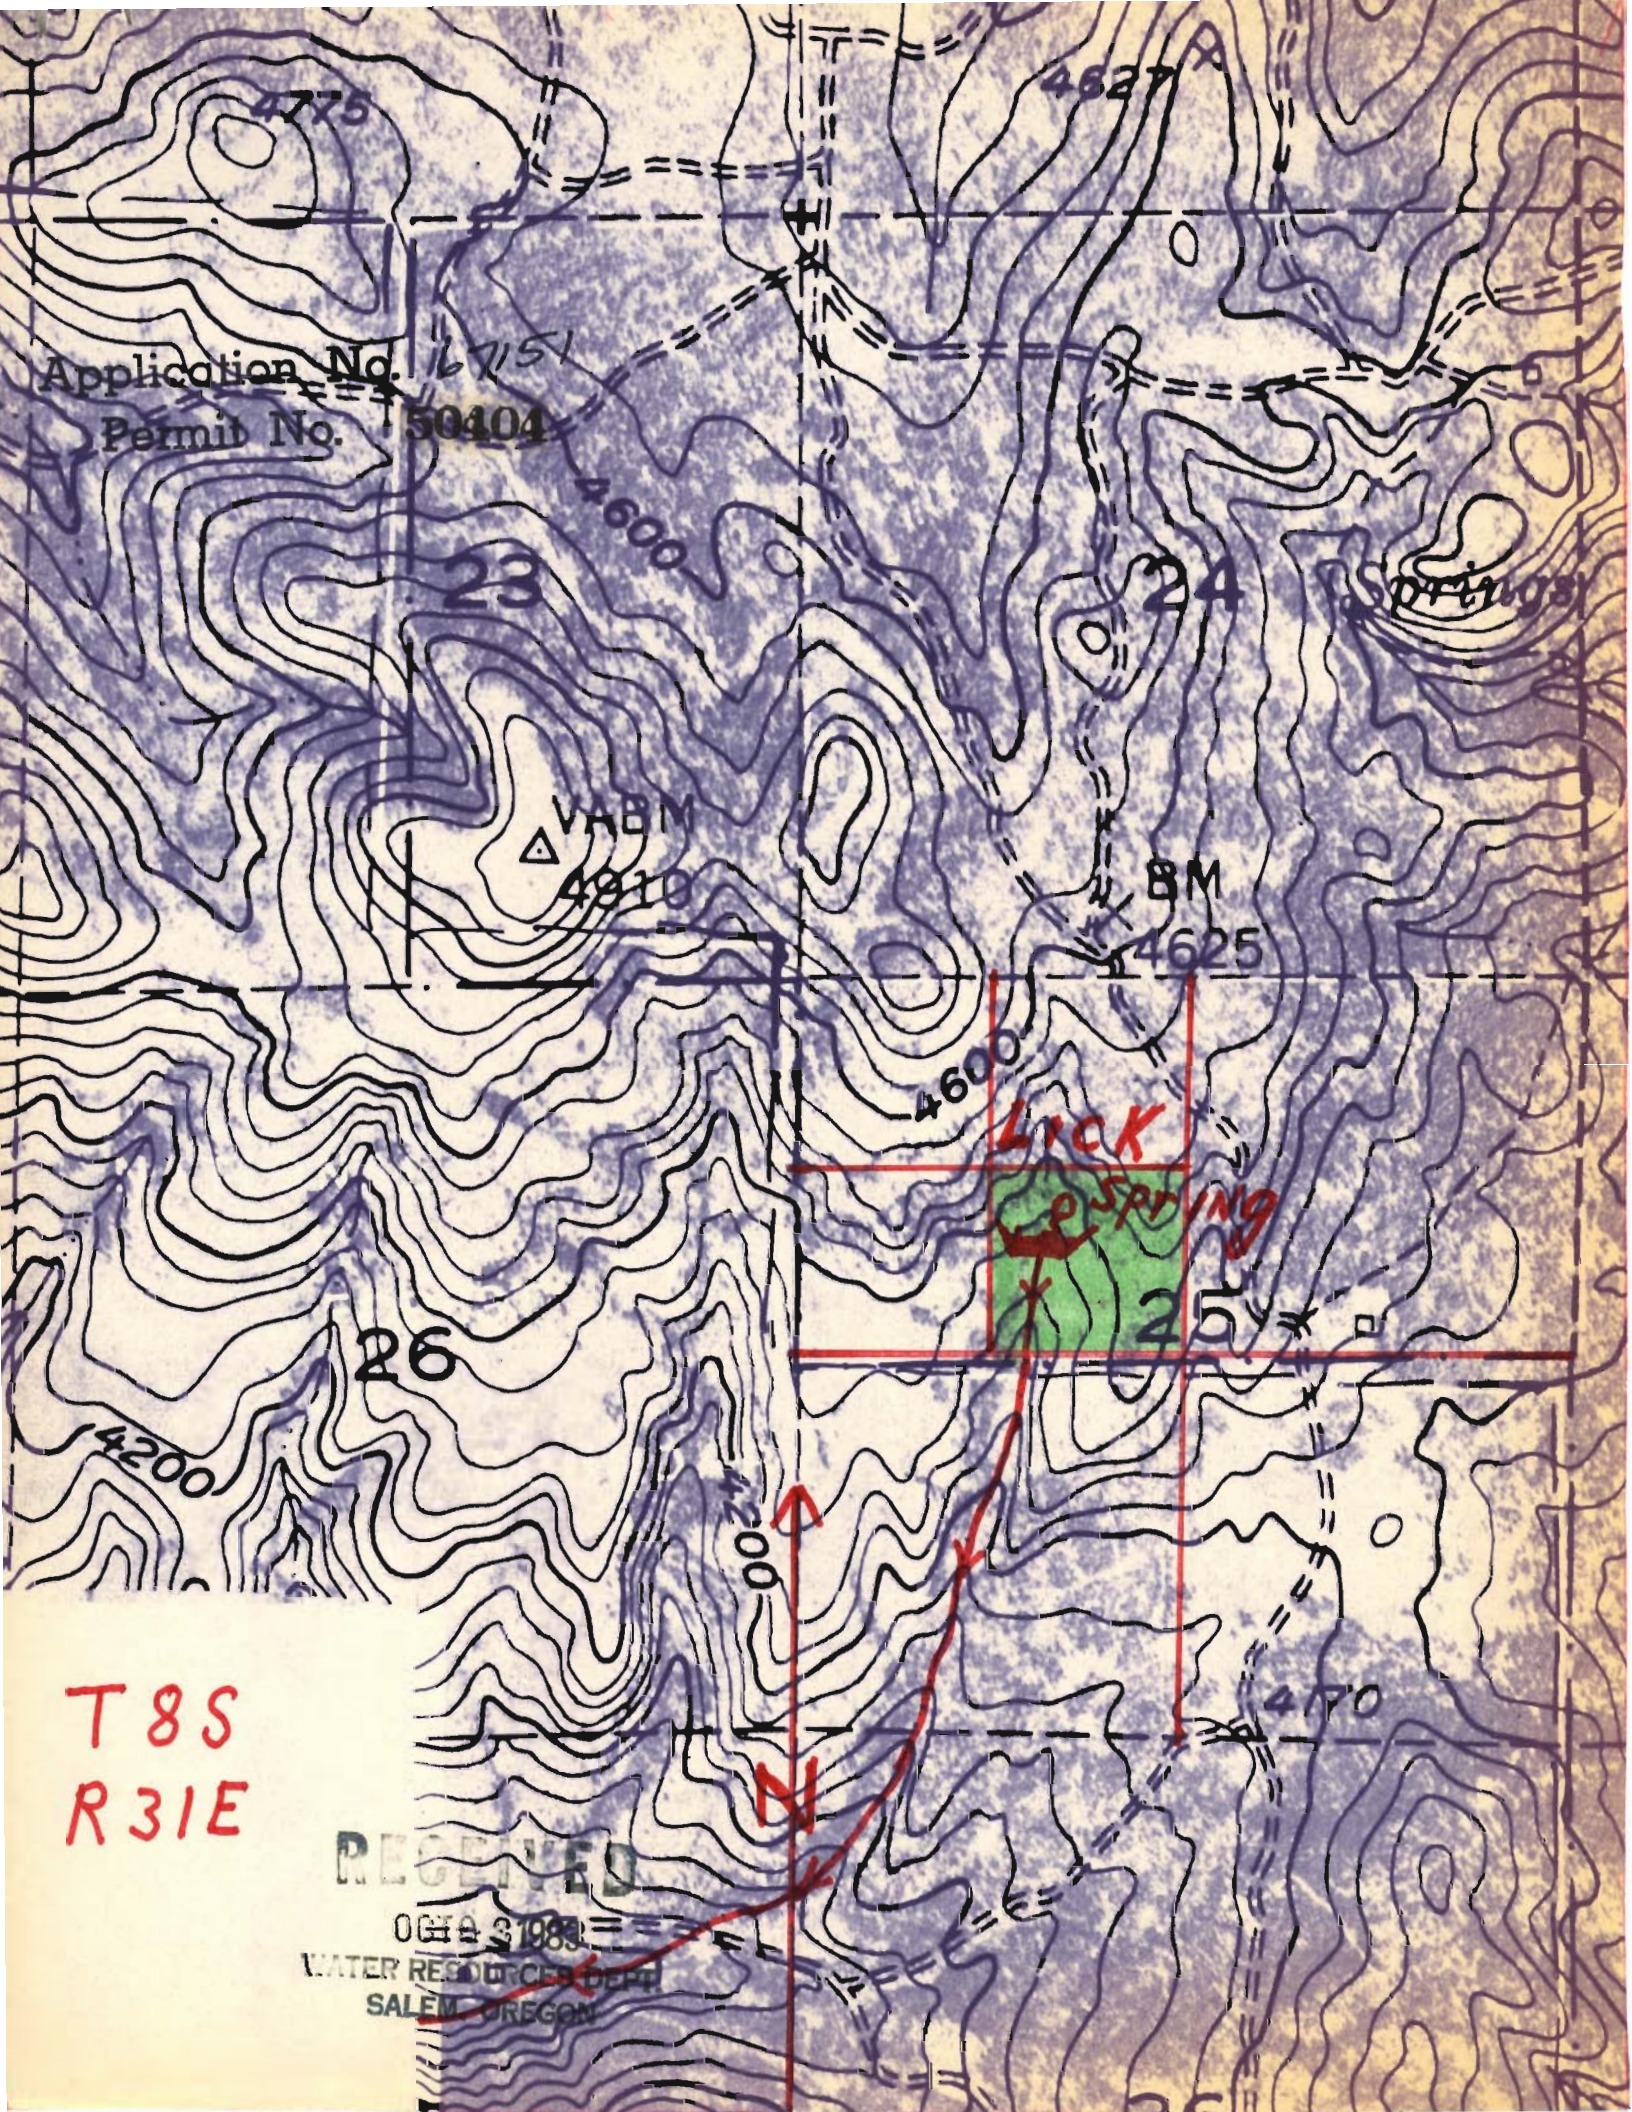

4775

4827

Application No. 167151

Permit No. 50404

23

24

Spring

VABM
4810

BM
4625

4600

LICK
Spring

25

26

4200

4700

4700

T8S
R31E

RECEIVED
OCT 2 1983
WATER RESOURCES DEPT
SALEM OREGON