


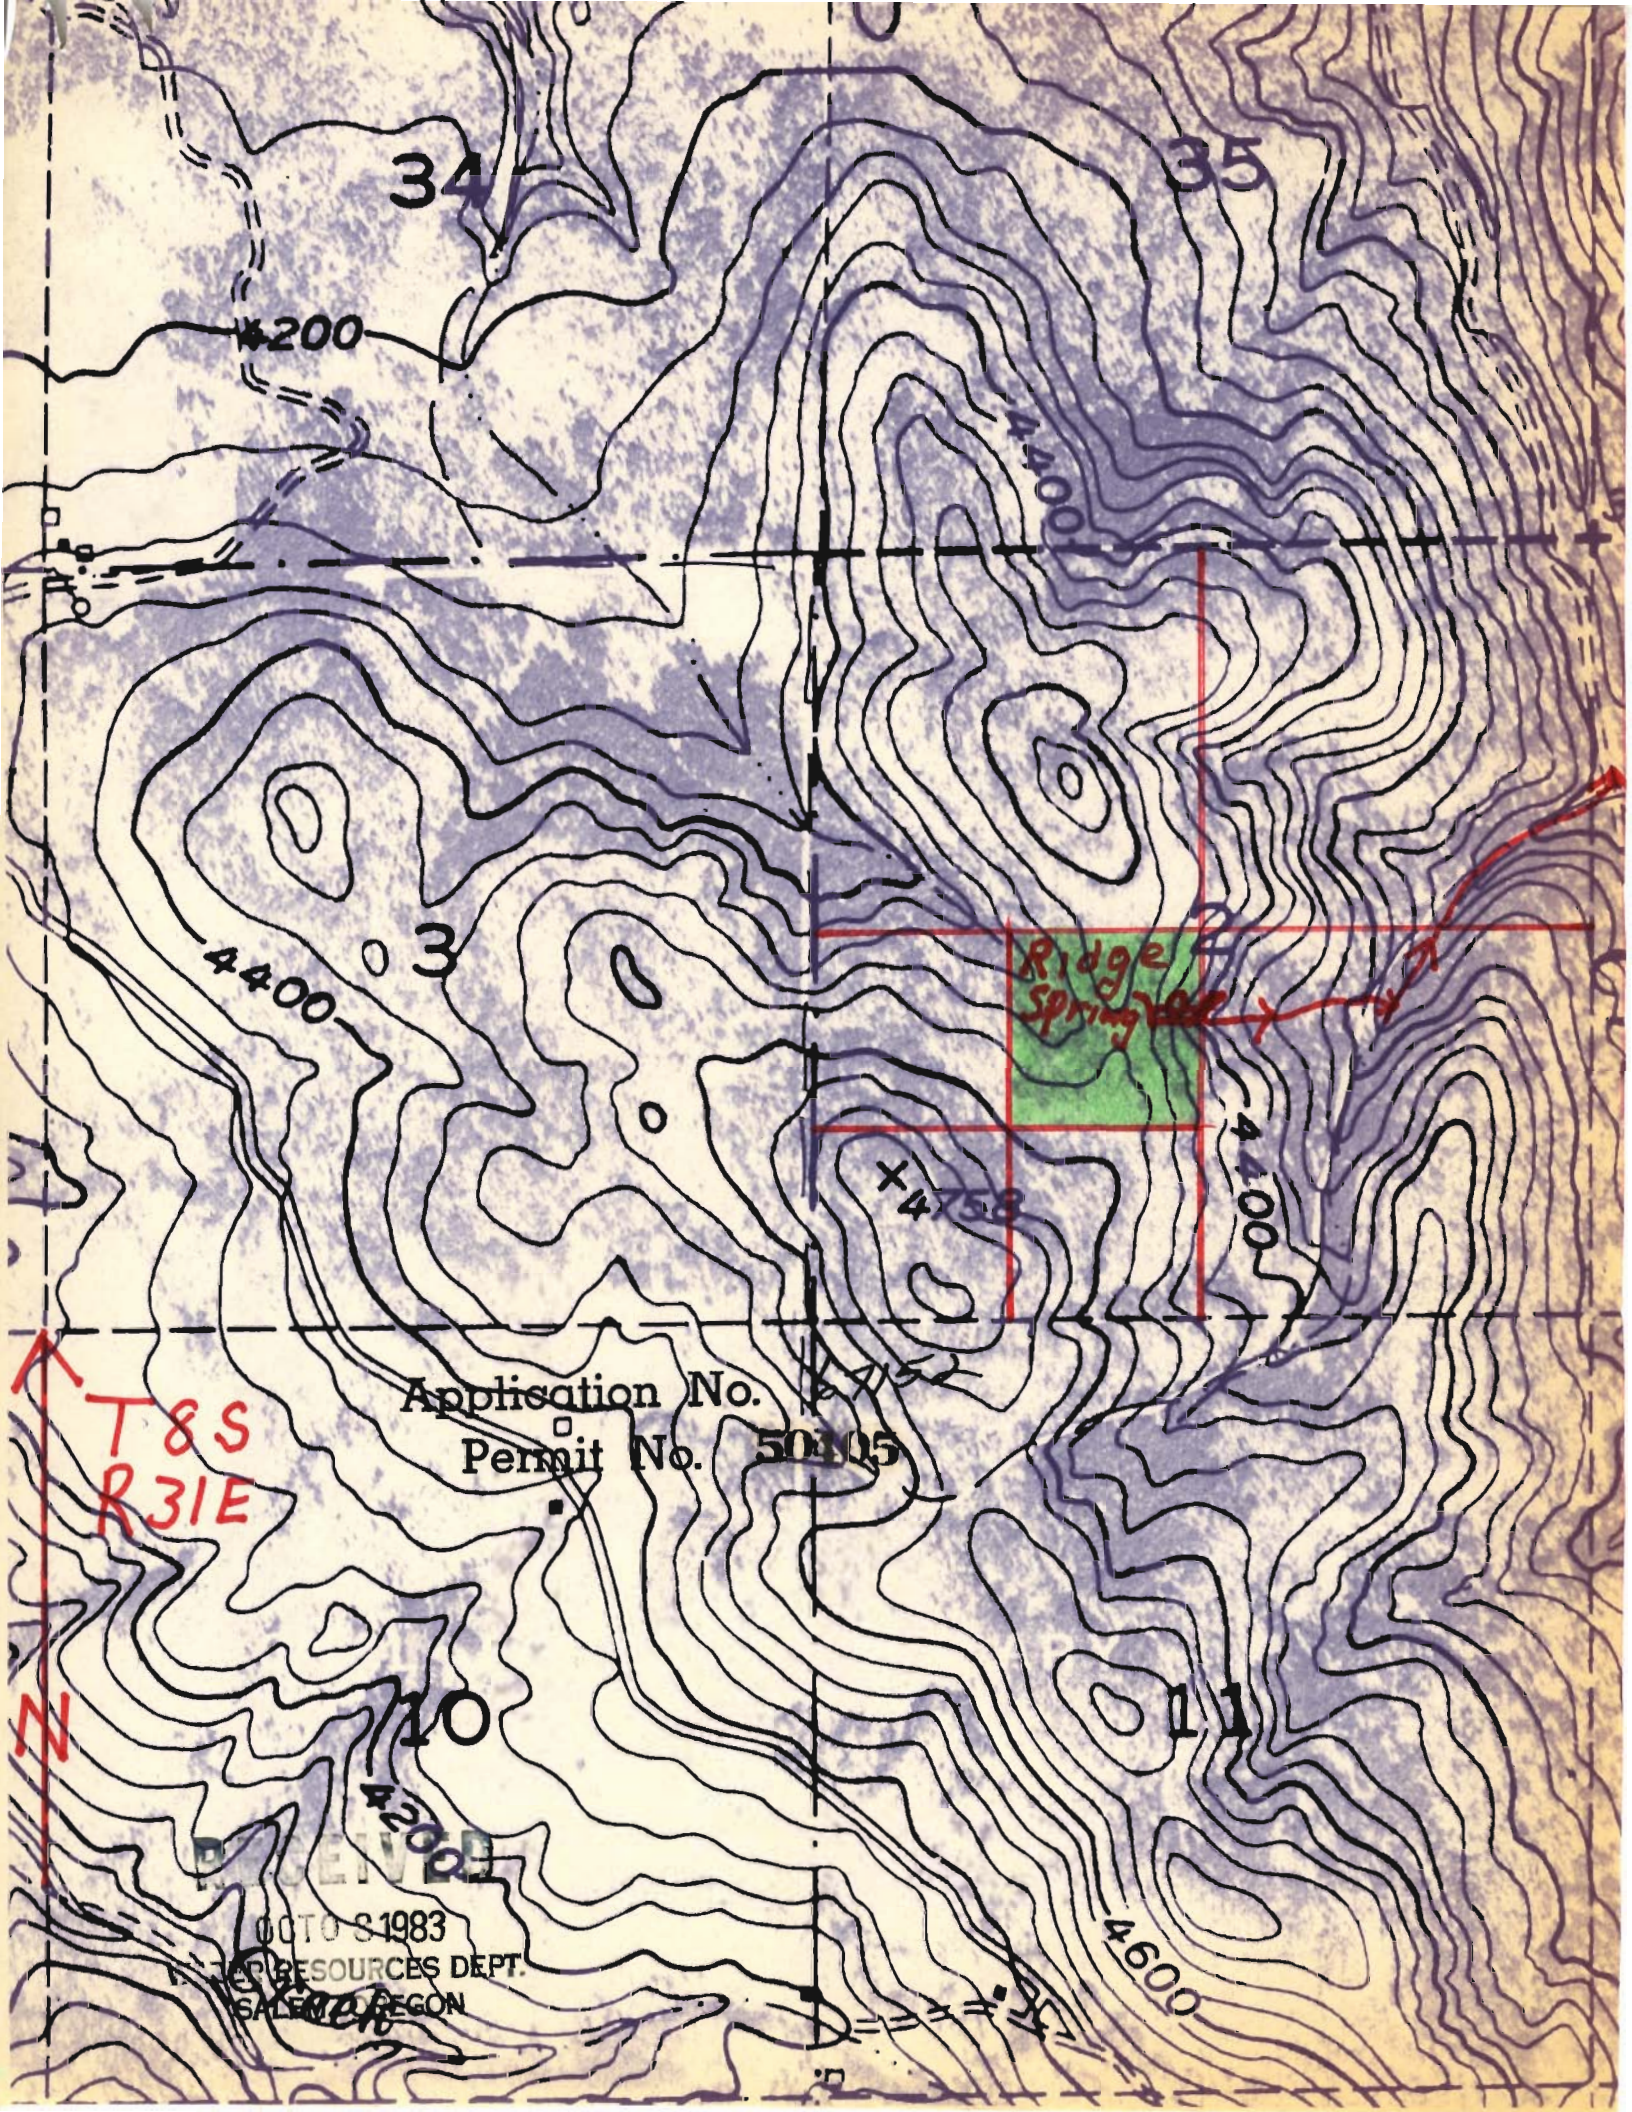

Application No. 50405
Permit No. 50405

T8S
R31E

Ridge
Spring

OCTO 8 1983
WATER RESOURCES DEPT.
SALEM, OREGON

District Dale
Name Ridge Spring Allotment Indian Creek

2500' E



RIDGE
SPRING

2150' N



Application No. 67152

Permit No. 50405

Township p 8S Range 31E Section 2

Scale 1" = 660 FT

FILED

007001983

RECORDS DEPT.
SALEM, OREGON