


District _____ Date _____

Name Sample Spring Allotment Indian Creek

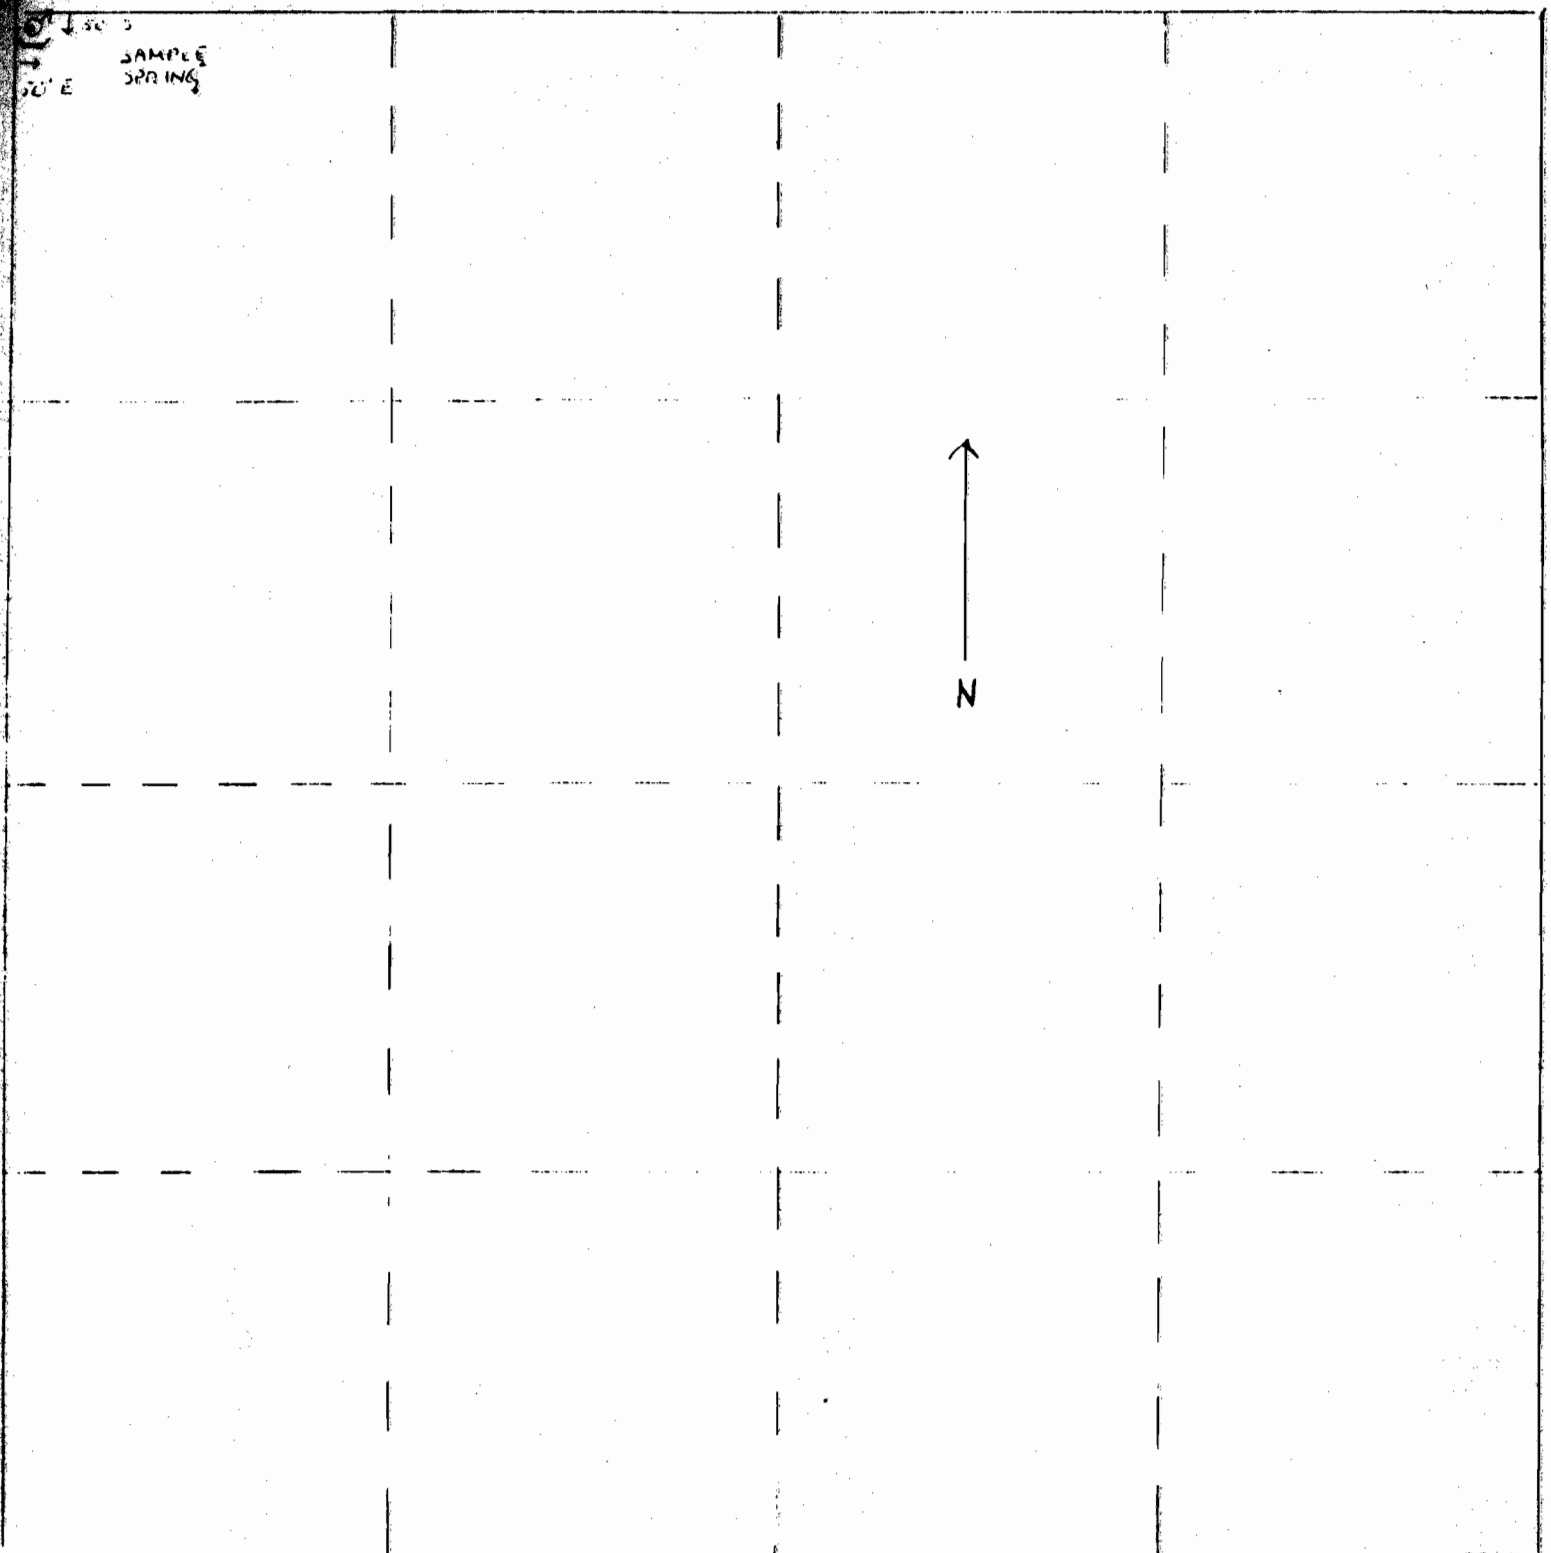


Application No. 67153

Permit No. 50406

Township 8S Range 32E Section 10

Scale 1" = 660 FT.

RECEIVED
JUN 13 1983
WATER RESOURCES DEPT.
SALEM, OREGON

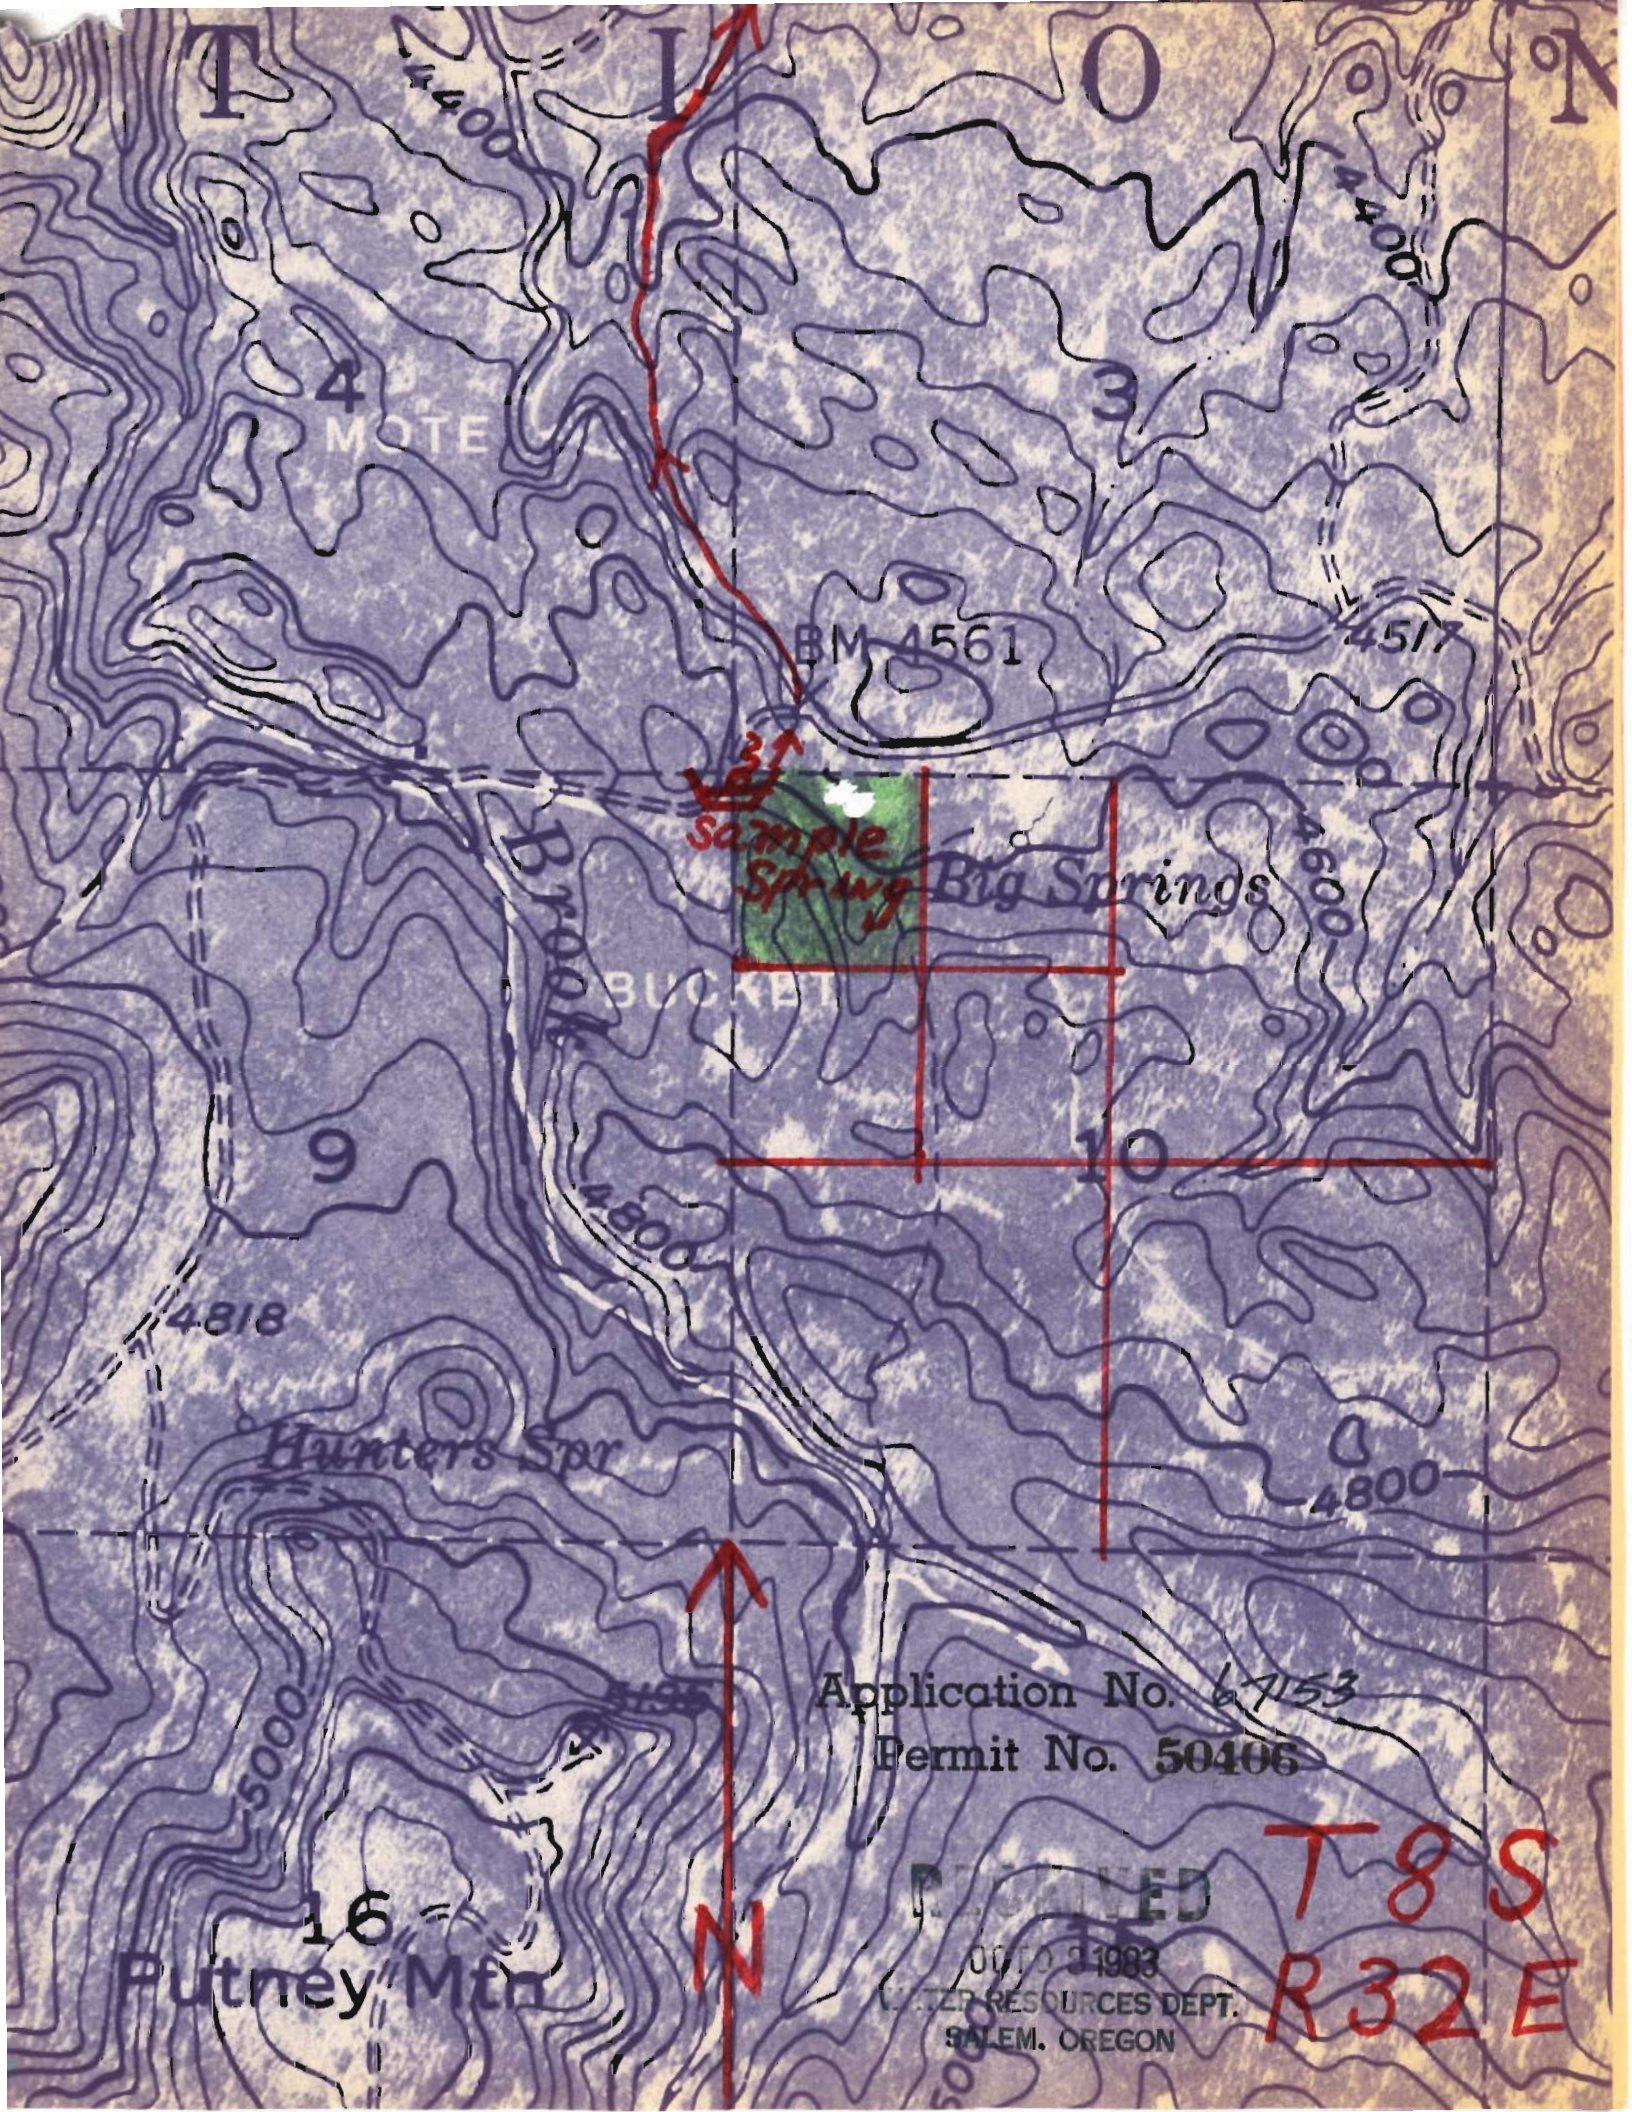

T I O N

4
MOTE

BM 4561

4517

Sample Spring

Big Springs

BUCKET

9

10

4818

Hunters Spr

4800

16

Putney Mtn

N

Application No. 67153
Permit No. 50406

RECEIVED

OCTO 21 1983

UNITED STATES DEPT.
SALEM, OREGON

T8S
R32E