

District Dale
Name Big Springs Allotment Indian Creek

1950'E



10

2


Application No. 67155

Permit No. **50408**

Township 8 S. Range 32 E. Section 10

Scale 1" = 660 FT.

106-03-1983
ED. RE. L. CES DEPT.
SALEM, OREGON

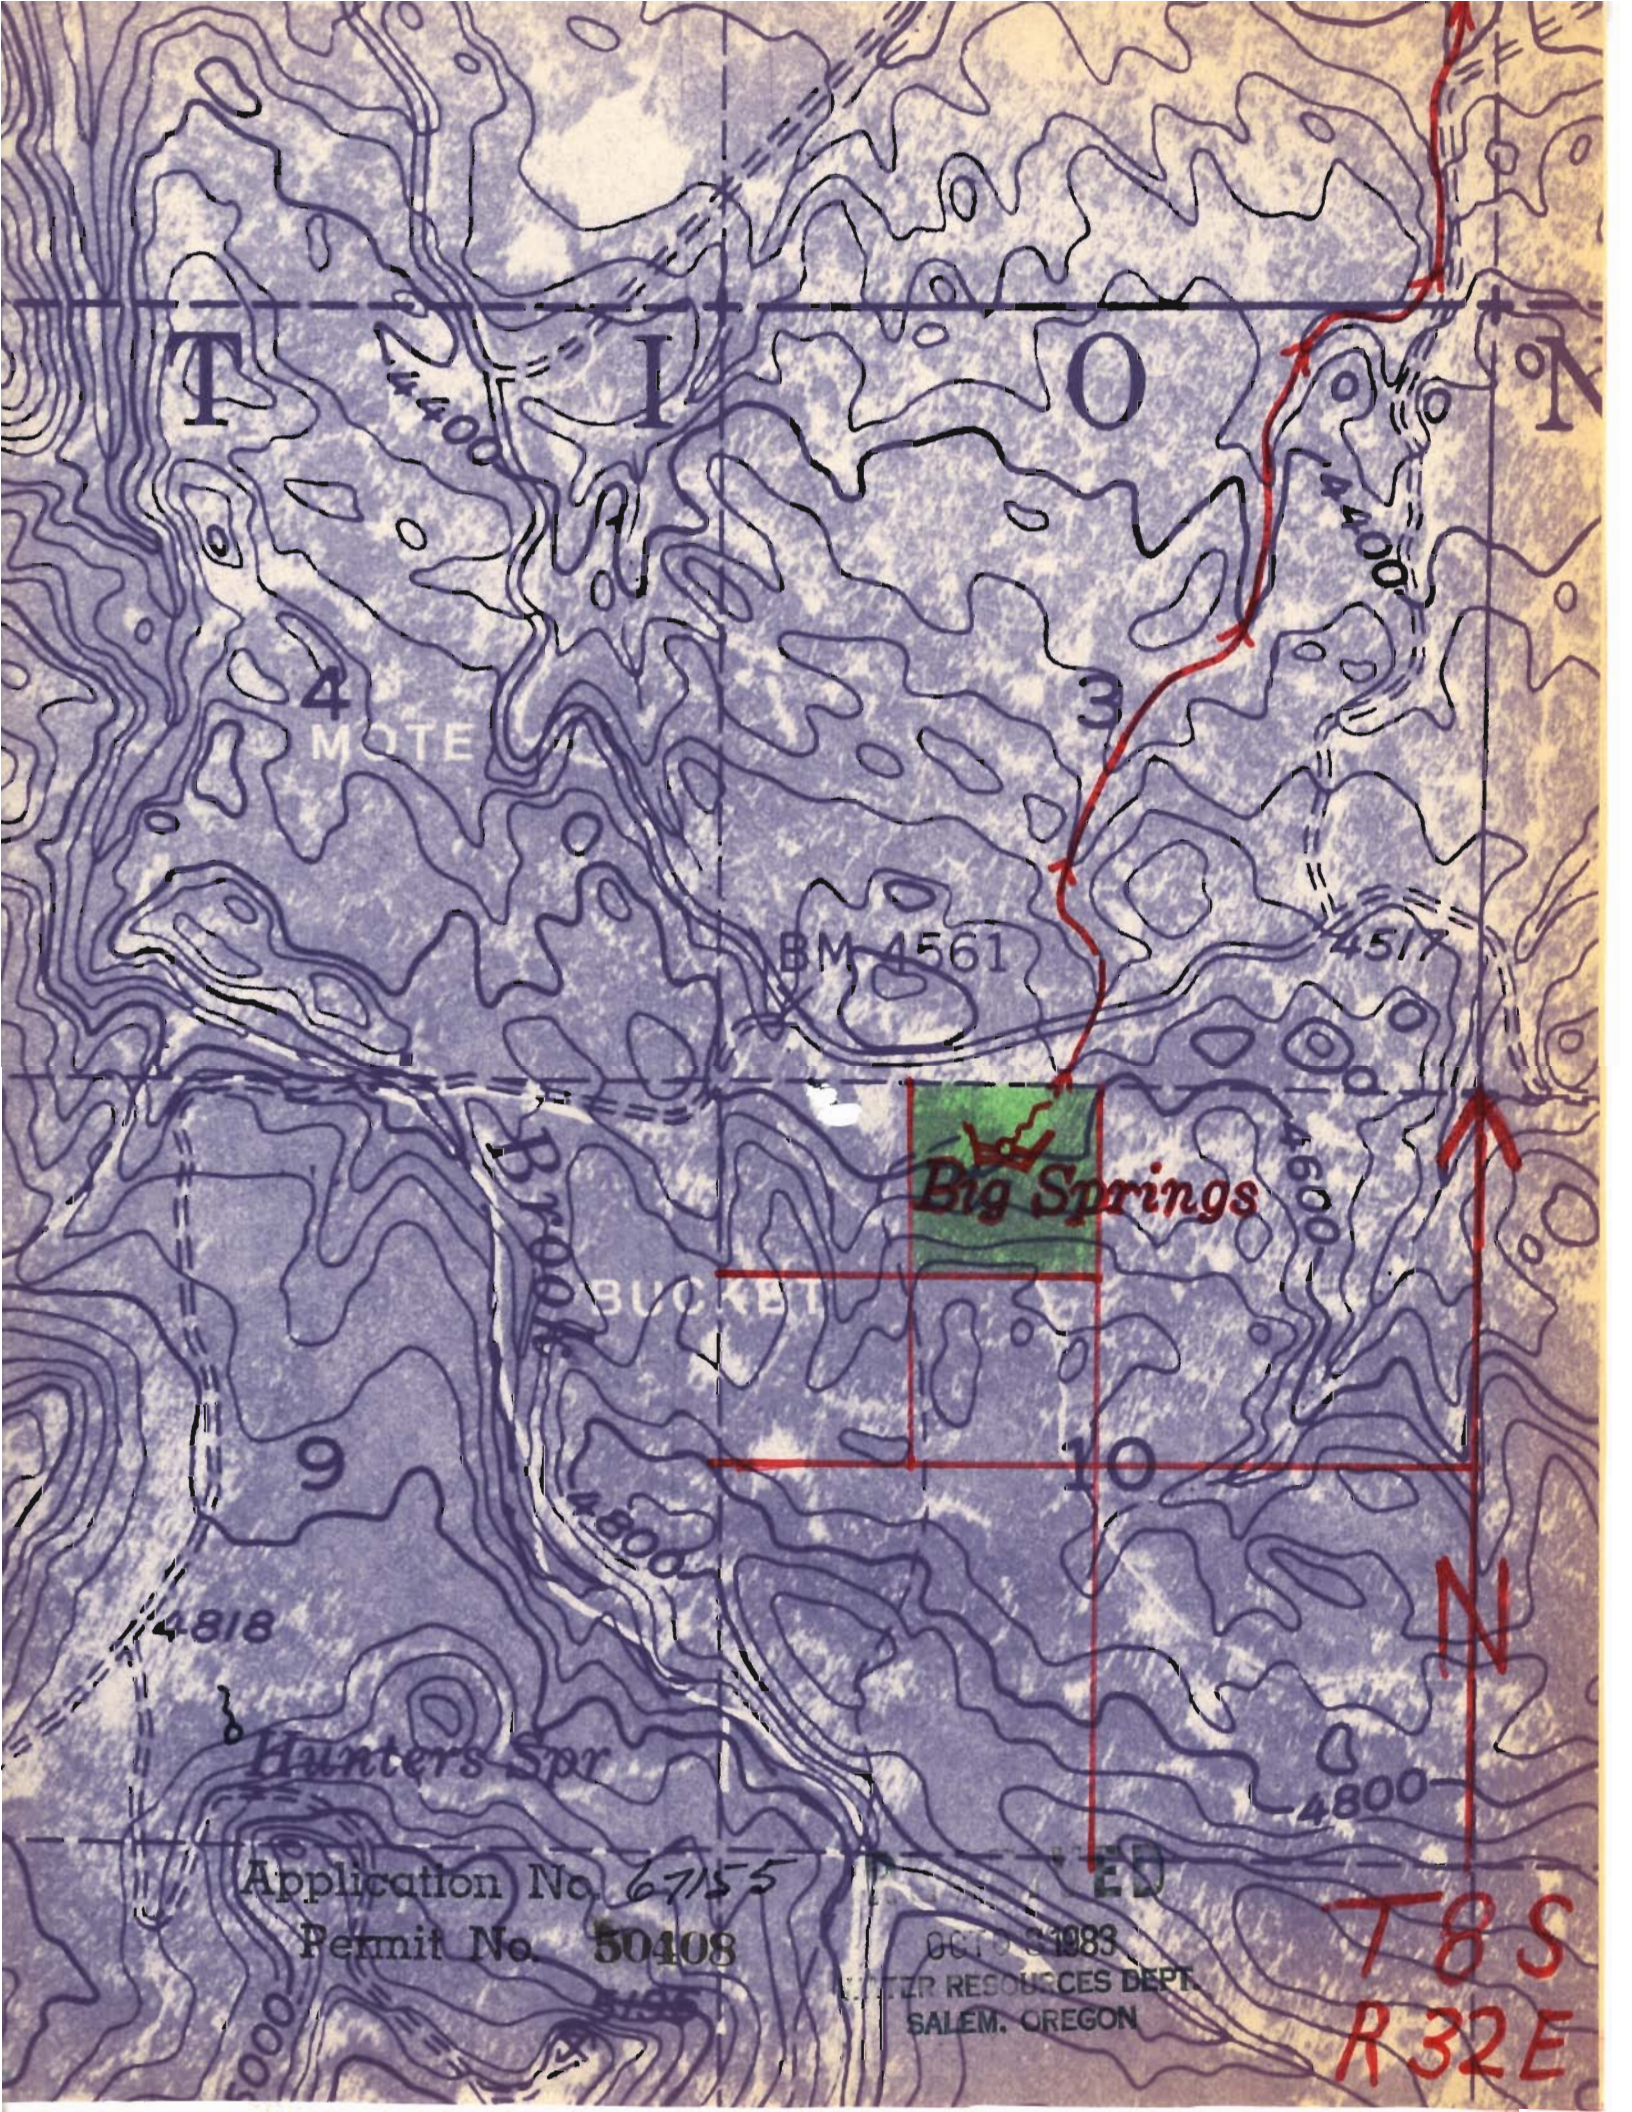

T

I

O

N

4

MOTE

3

BM 4561

4517

Big Springs

BUCKET

9

10

N

Hunters Spr

Application No. 67155

Permit No. 50408

0610 01983
WATER RESOURCES DEPT.
SALEM, OREGON

T8S
R32E