


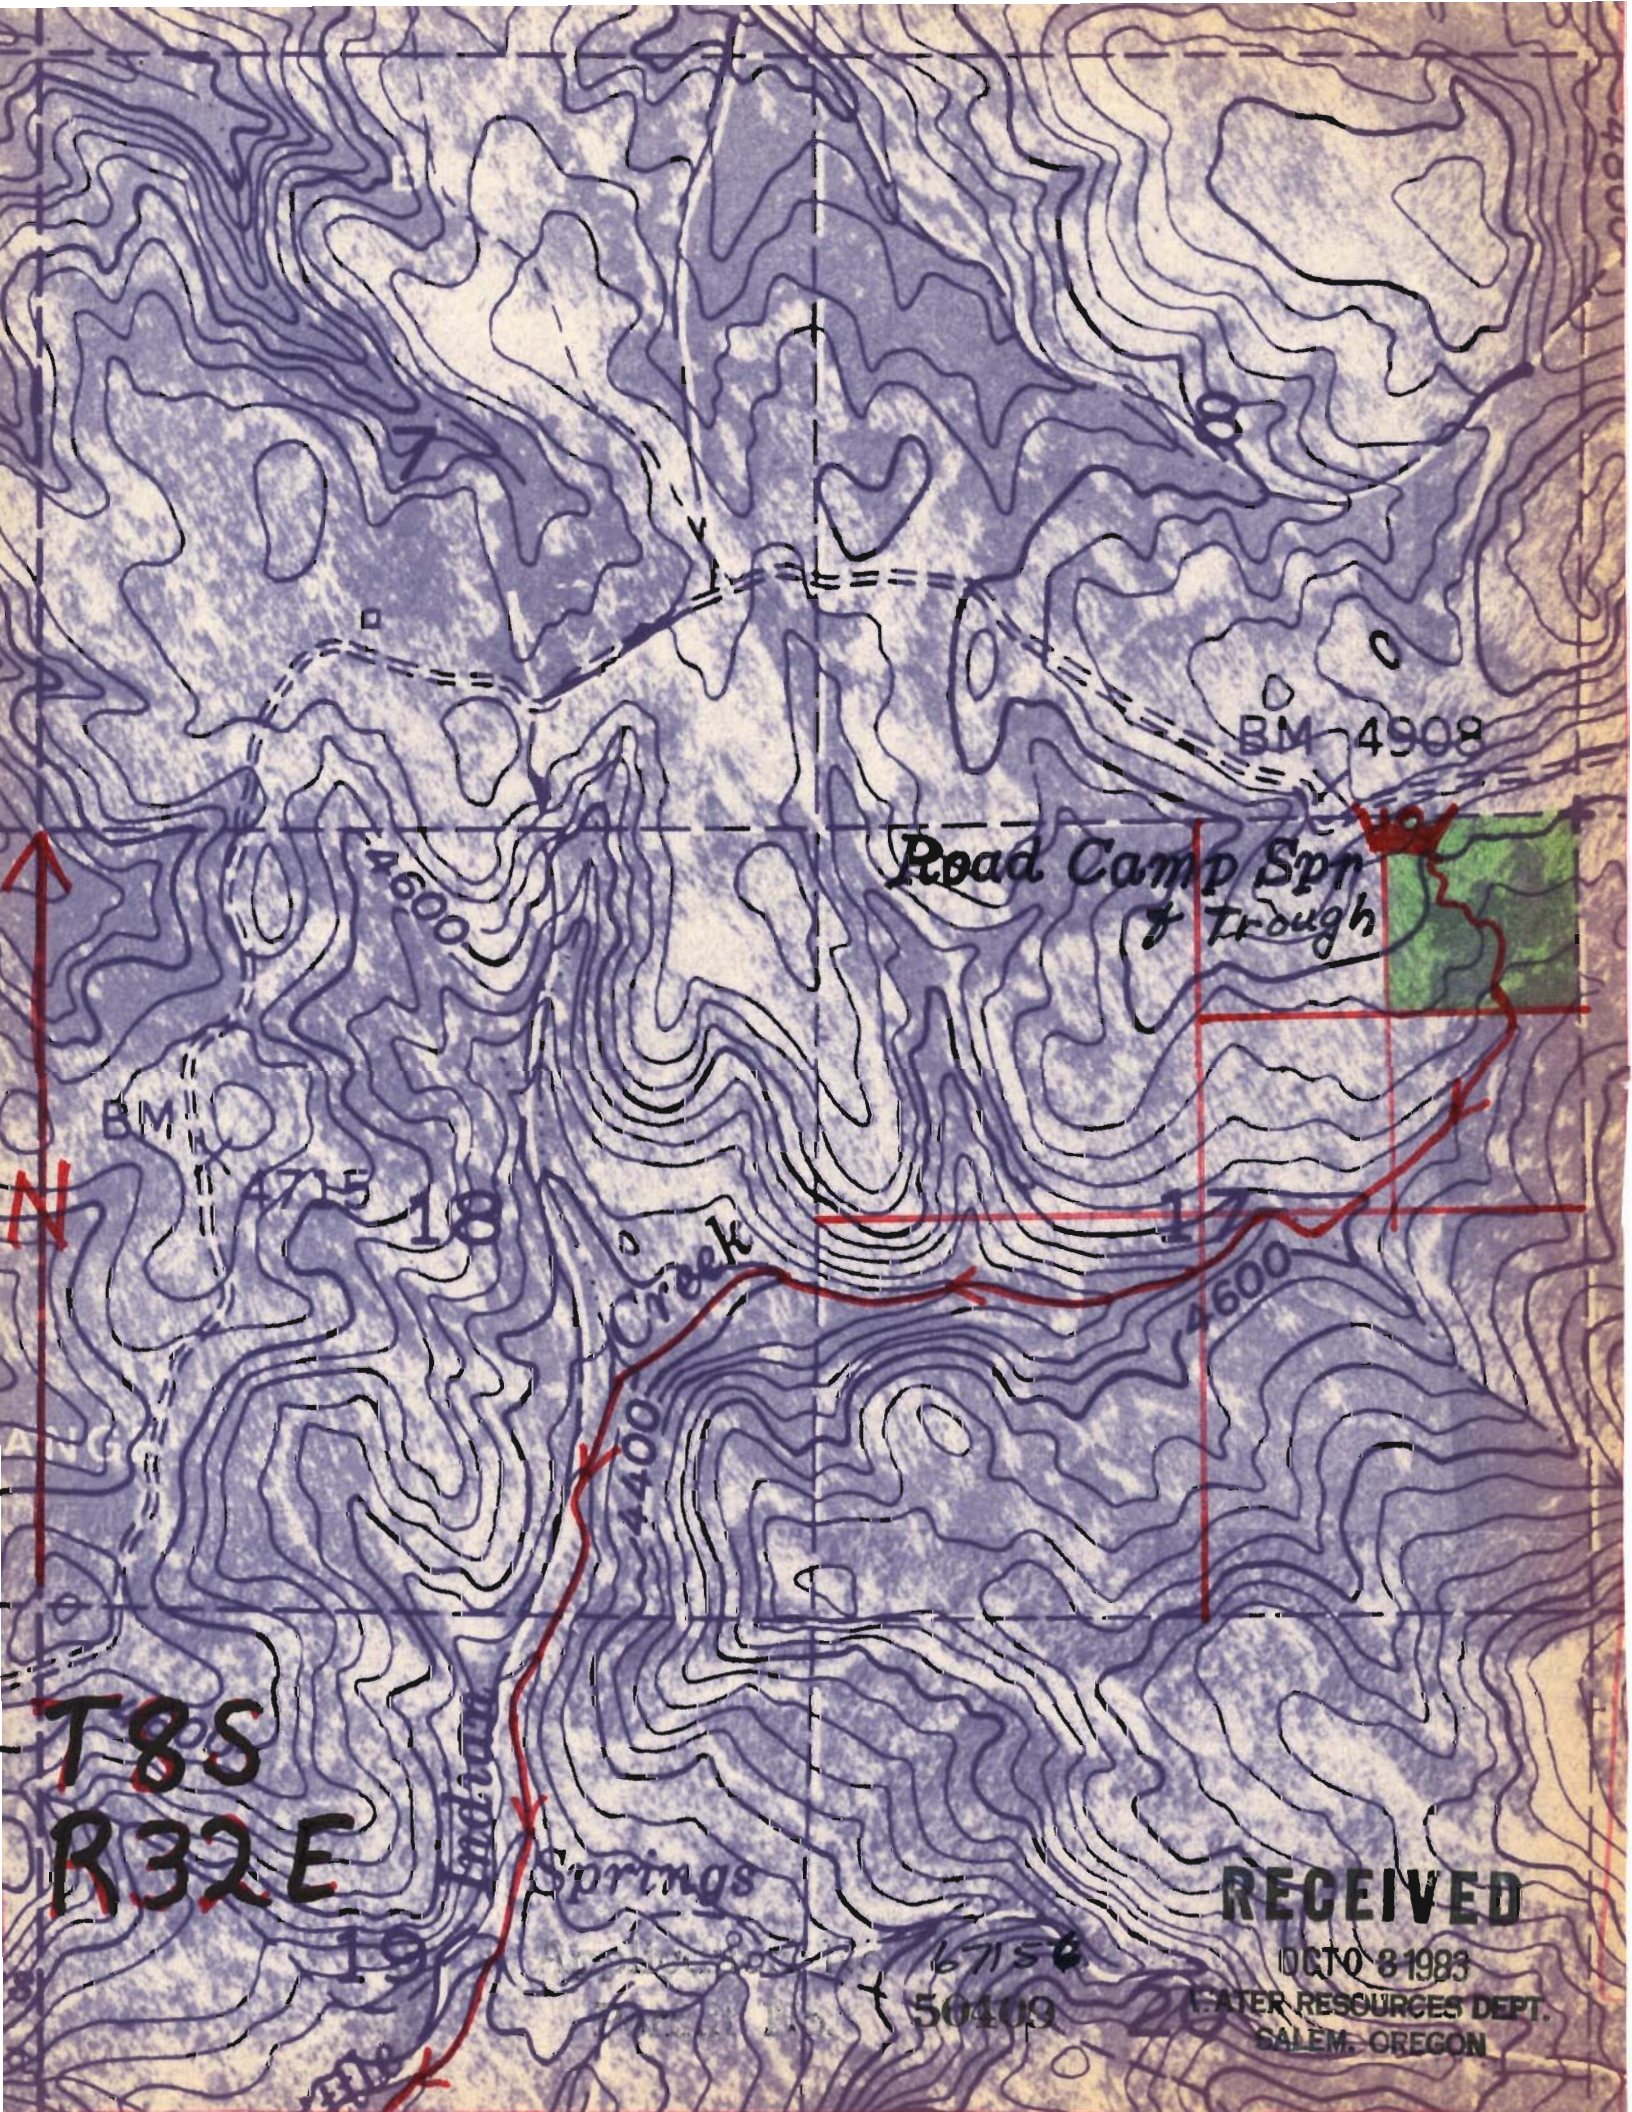

Road Camp Spr
& Trough

BM 4908

BM

4715

18

17

Creek

4400

4600

T8S
R32E

Indian

Springs

6715

50409

RECEIVED

OCTO 8 1983

WATER RESOURCES DEPT.
SALEM, OREGON

District _____ Date _____
Name Road Camp Spring Allotment Indian Creek

50's
40's

1150' W

17



RECEIVED

OCT 8 1983

WATER RESOURCES DEPT.
SALEM, OREGON

67156

50409

Township 8S Range 32E Section 17

Scale 1" = 660 FT.