

District _____ Date _____

Name Hunter Spring Allotment Indian Creek

9

2050' E

750' W

RECEIVED

OCT 03 1983


WATER RESOURCES DEPT.
SALEM, OREGON

Ap. Number No 67157

Section No 50410

Township p 8S. Range 32E. Section 9

Scale 1" 660 FT.

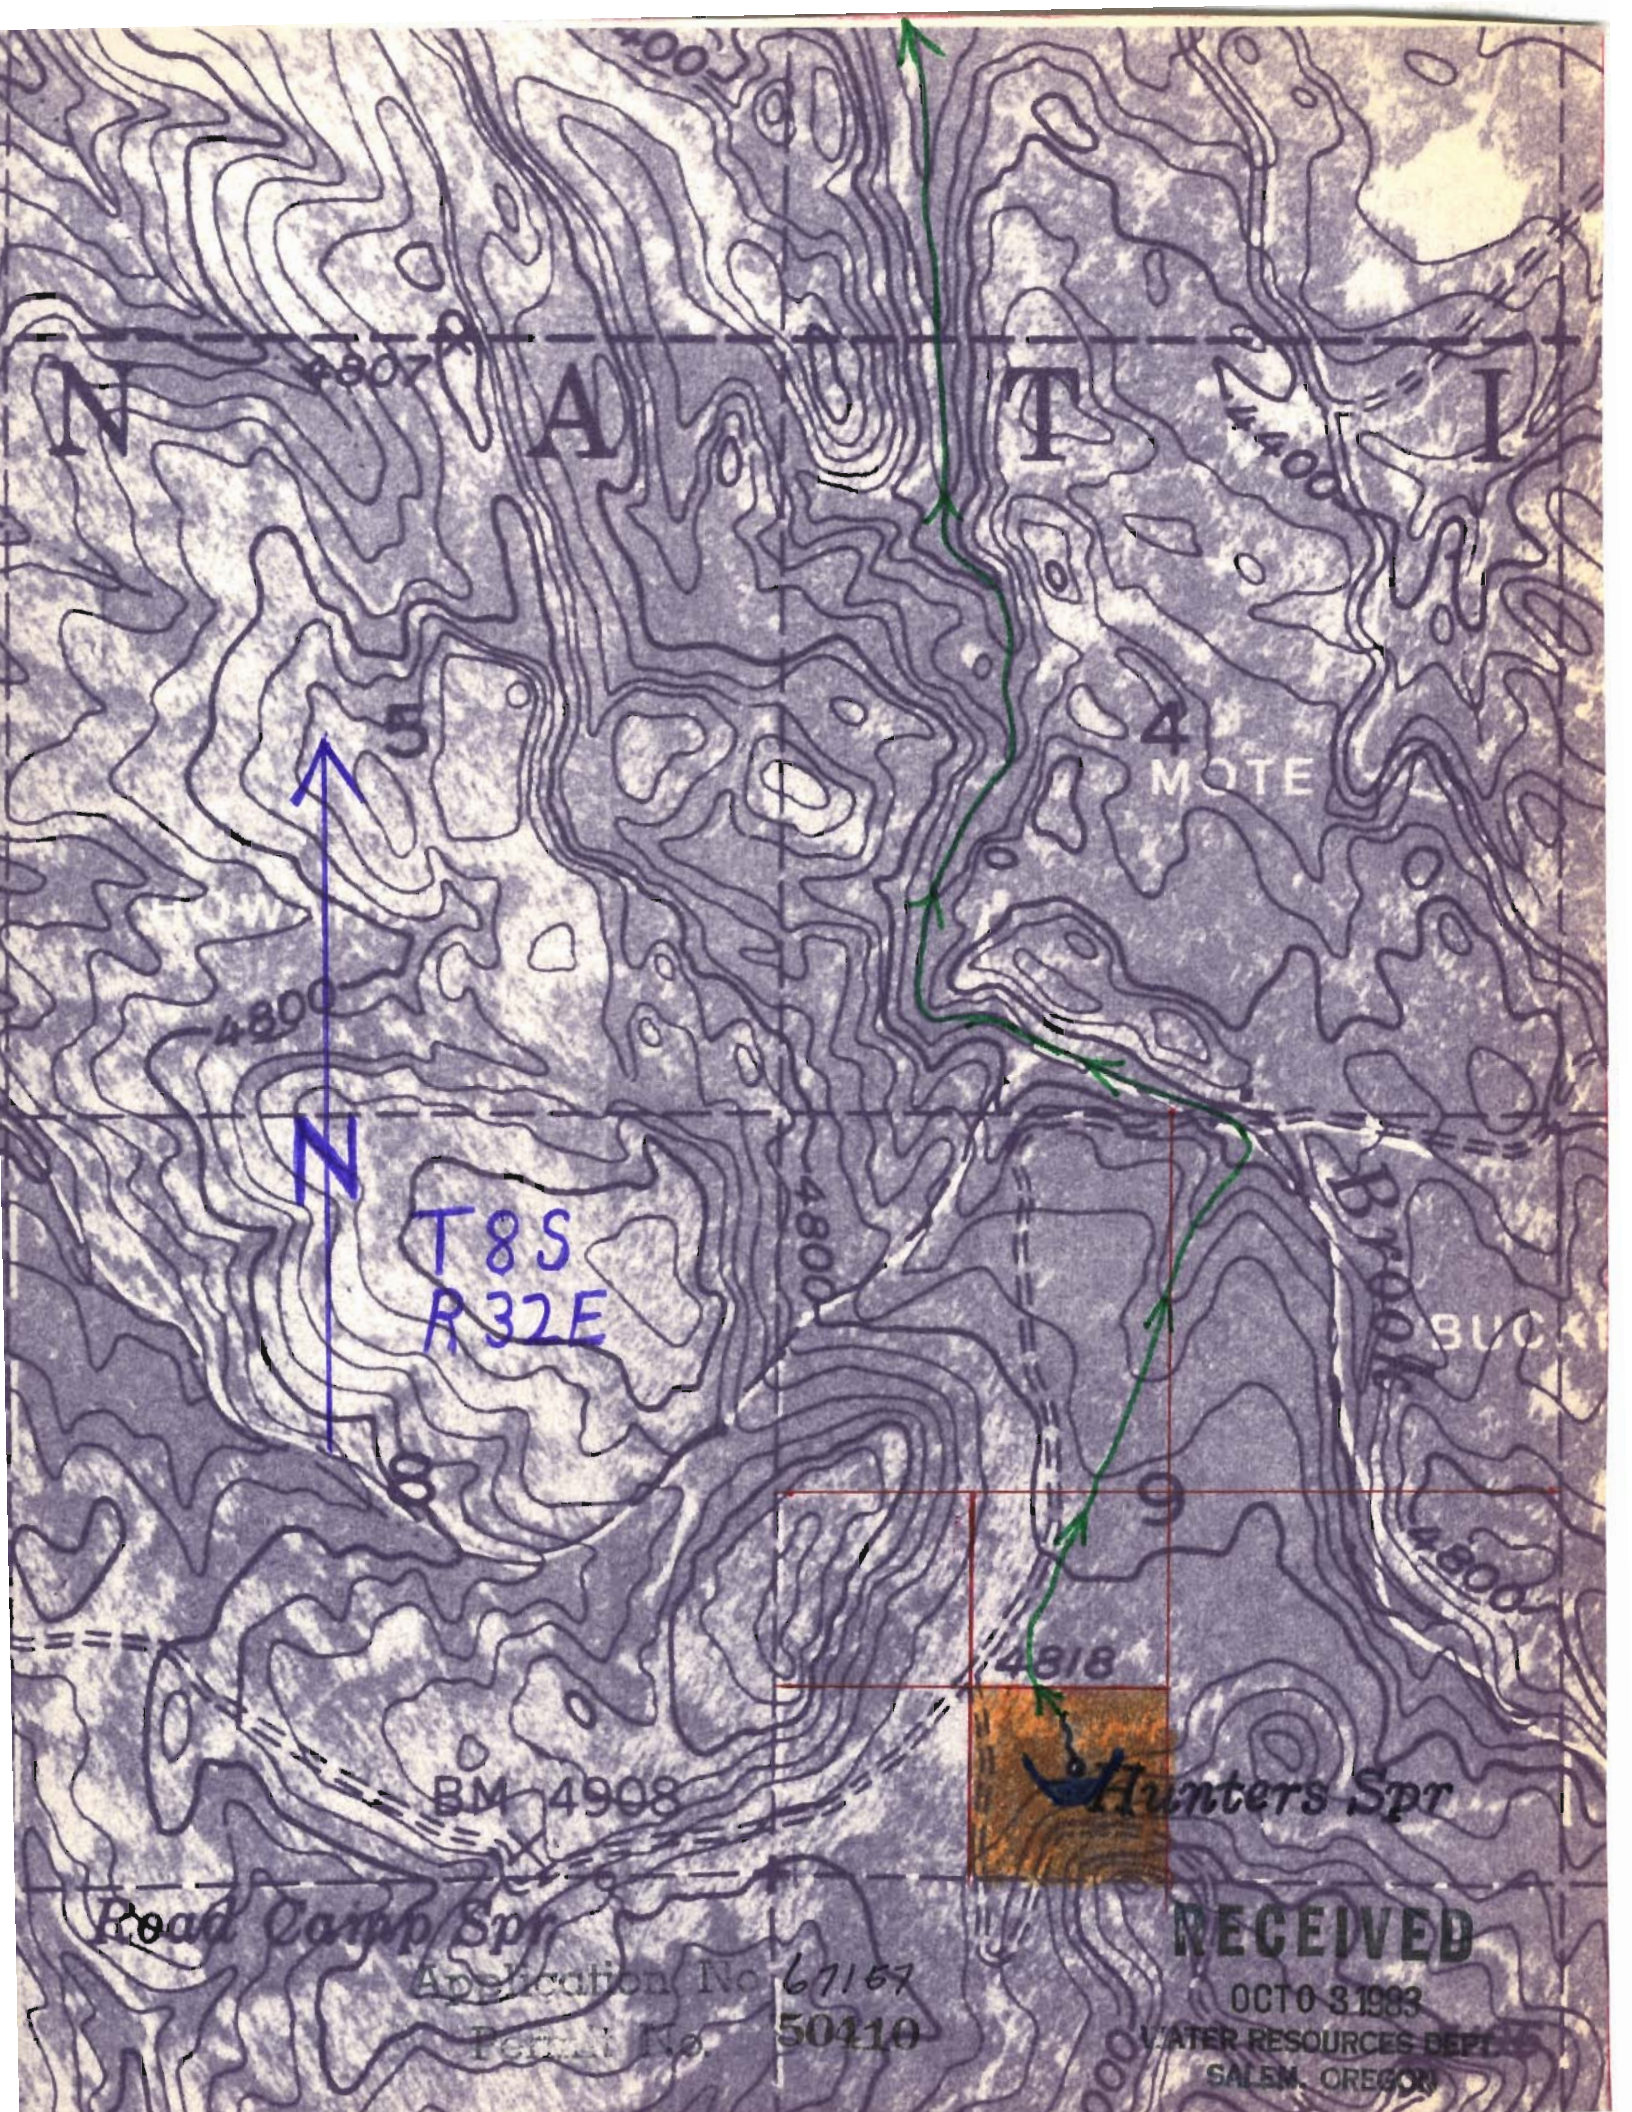

N

A

T

I

5

4

MOTE

N

T8S
R32E

Brook

BUCK

BM 4908

Road Camp Spr

Hunters Spr

Application No. 67167

Permit No. 50410

RECEIVED

OCTO 31 1983

WATER RESOURCES DEPT
SALEM, OREGON