


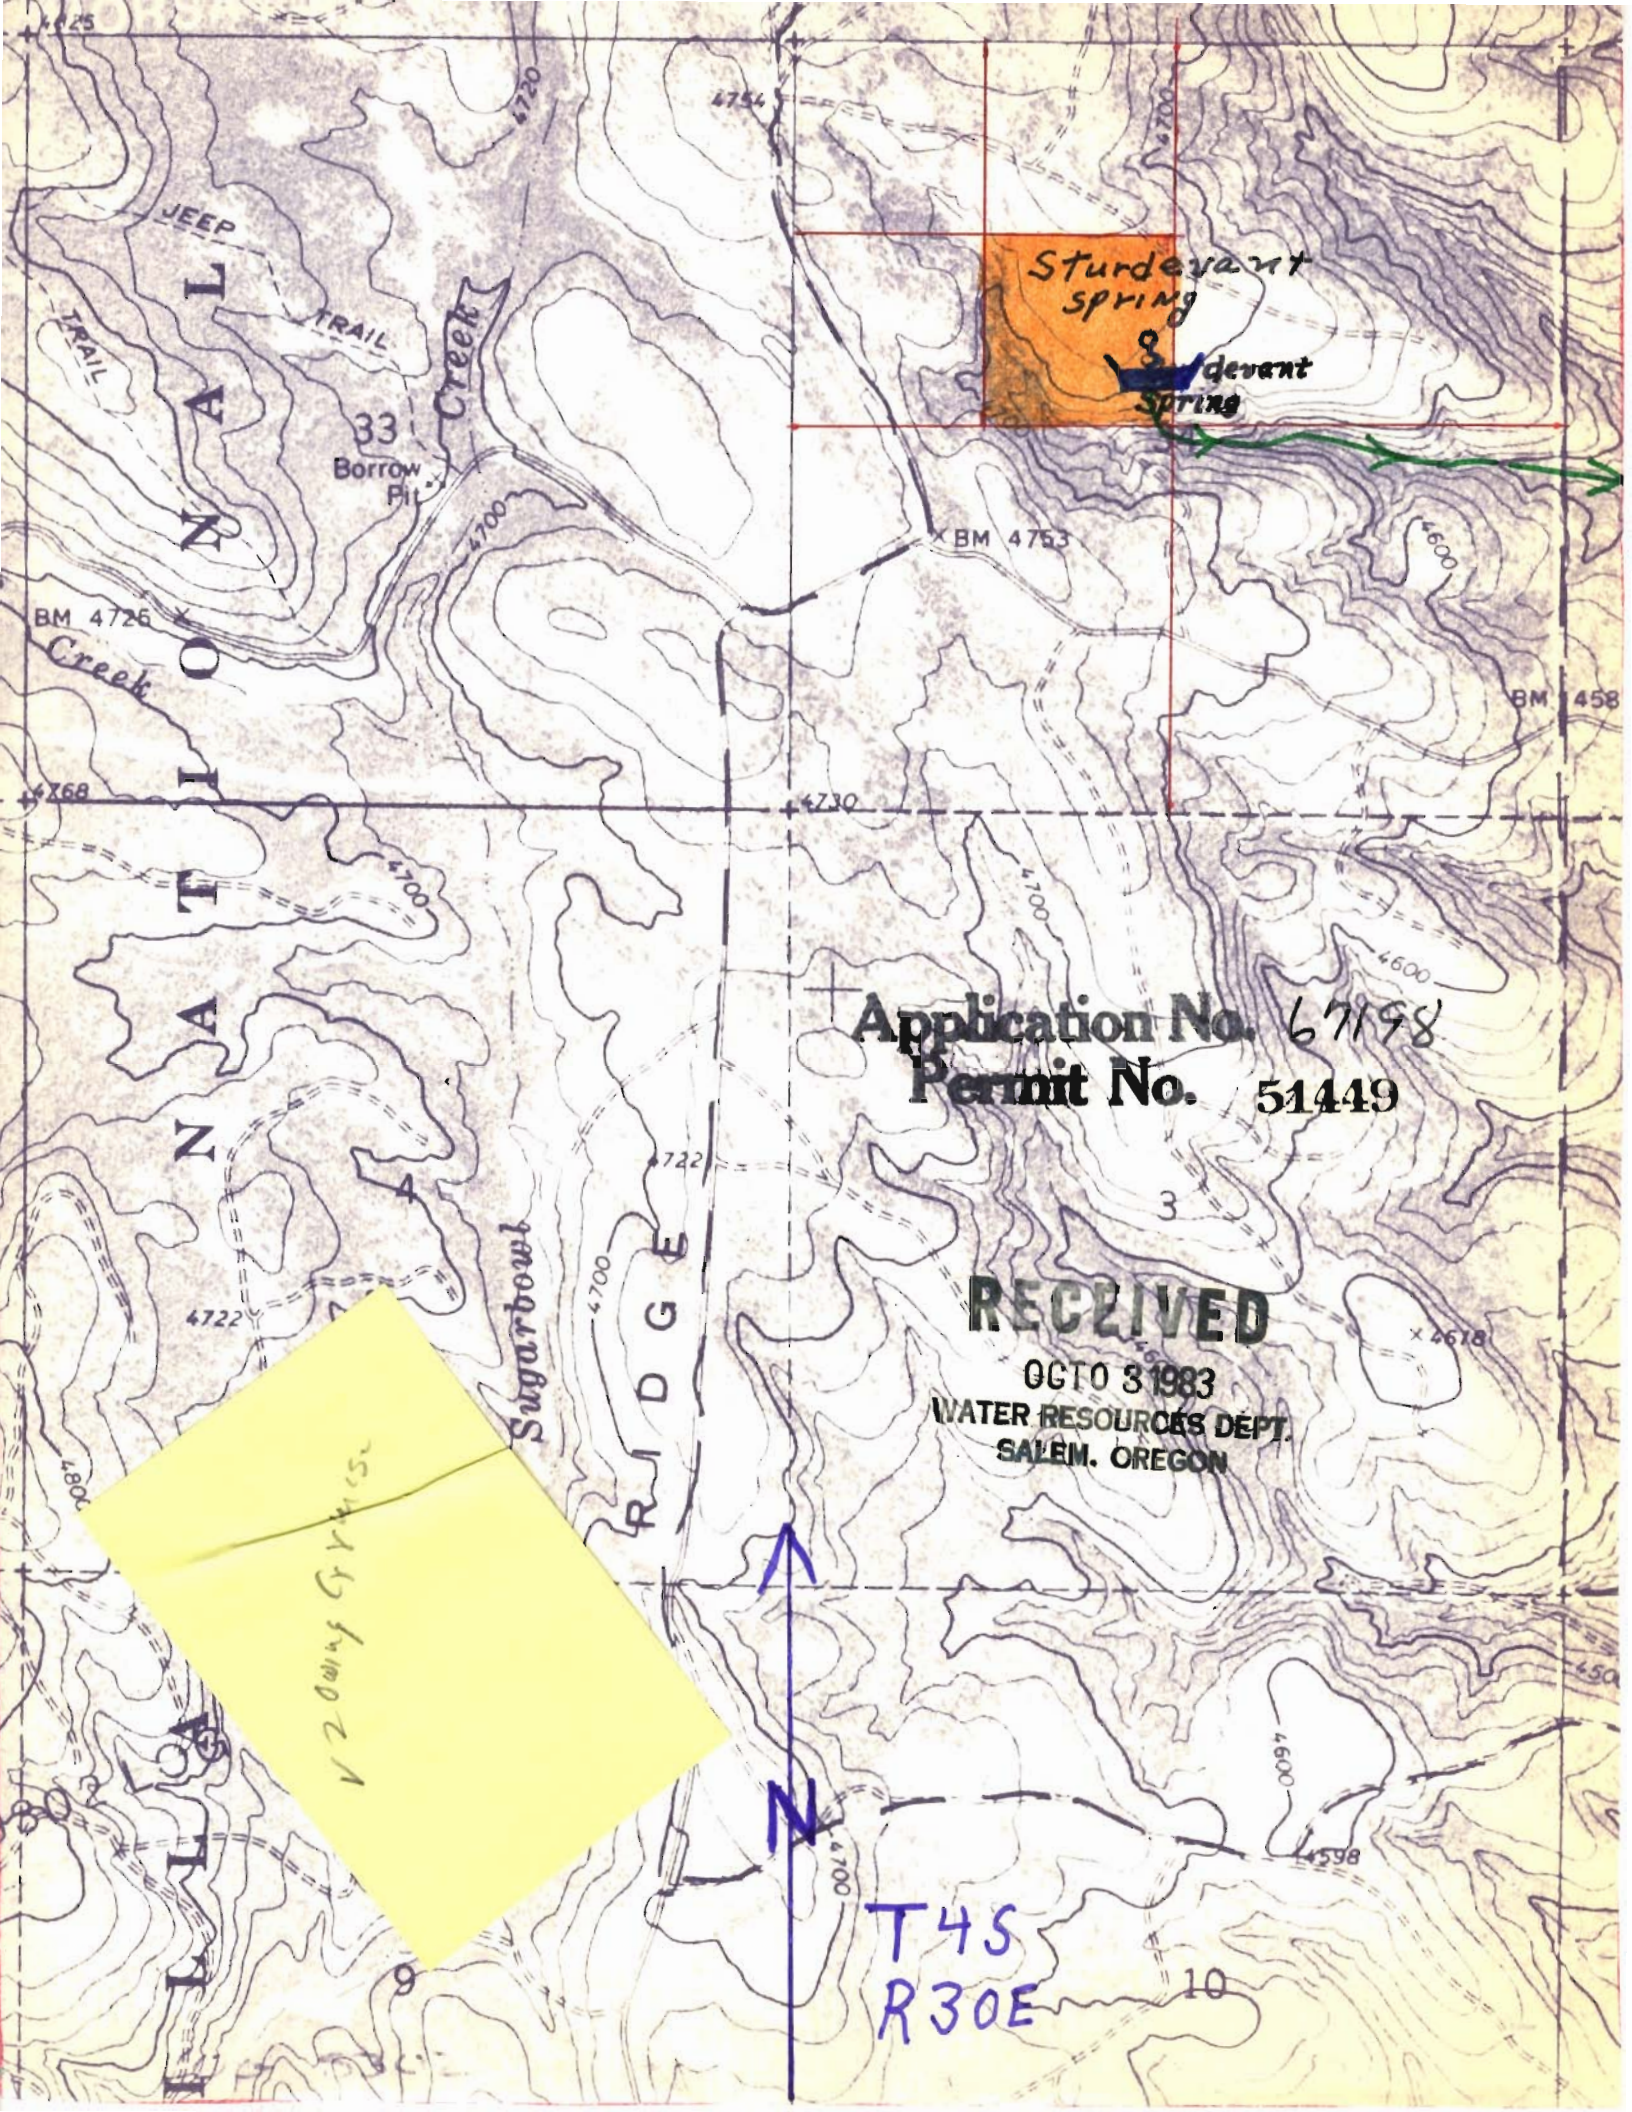

Sturdevant
spring

Sturdevant
Spring

Application No. 67198
Permit No. 51449


RECEIVED

OCT 03 1983
WATER RESOURCES DEPT.
SALEM, OREGON

V200mg Cr. 1983

T45
R30E

TOWNSHIP 4S, RANGE 30E, SECTION 34, W.M.

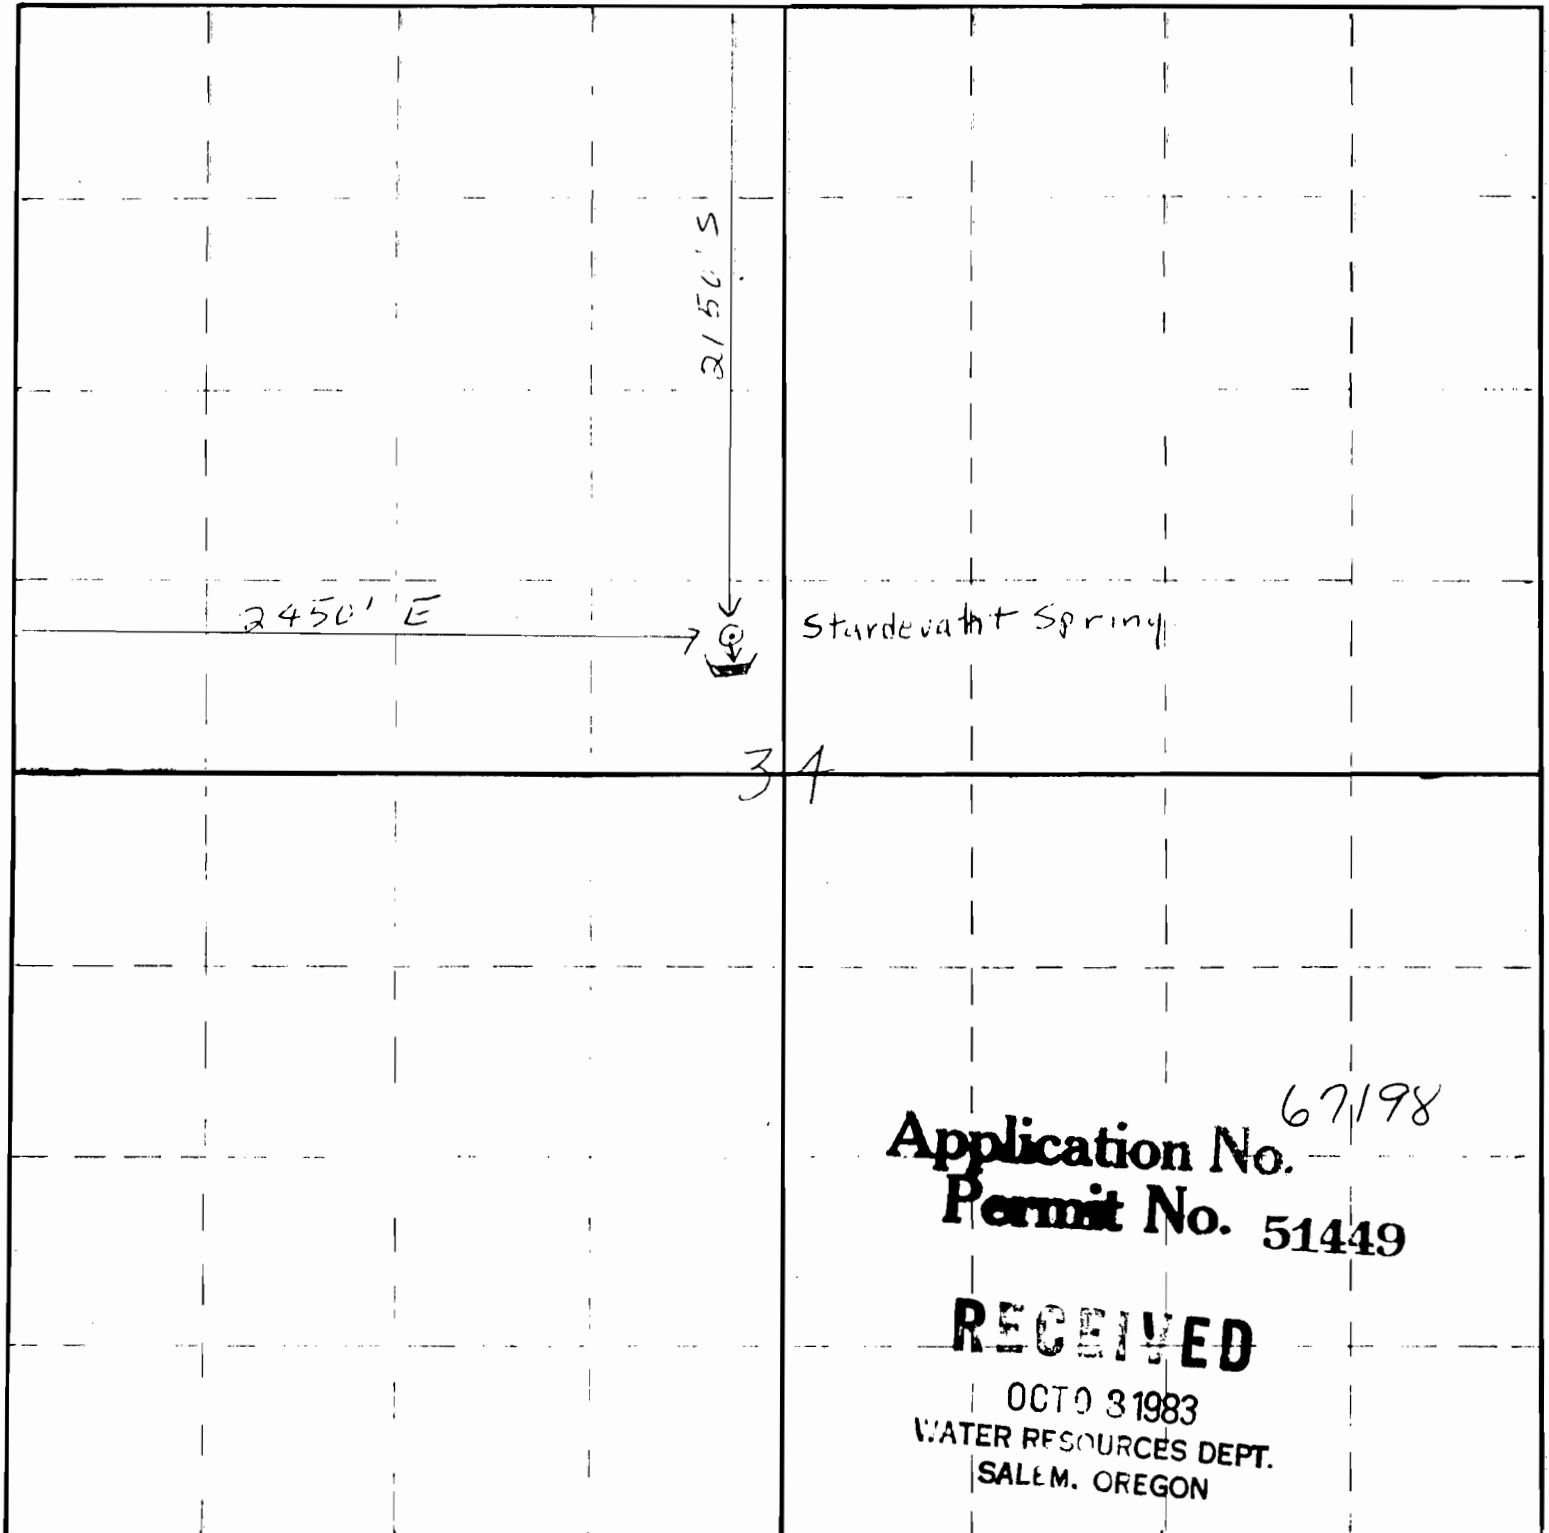

NAME Sturdevant Spring COUNTY Umatilla

DISTRICT Ukiah

ALLOTMENT F.C. Whitney

Scale 8 Inches = 1 Mile

