

BURNT

Coff
Spr

6

5

4410

4000

4400

Creek

REVISED

007931983

WATER RESOURCES DEPT.
SALEM, OREGON

70

Application No. 1267298

Permit No. 51450

Tamarack

Spr

4397

4326

Mud Spr

4522

Tamarack

4979 Mtn

18

Lookout

N

T85

R26E

District Clippner

Name Tamarack Spring Allotment Tamarack Monument

RECEIVED


OCTO 31 1983
WATER RESOURCES DEPT.
SALEM, OREGON



8

Application No. R-67298
Permit No. 51450

TAMARACK
SPRING

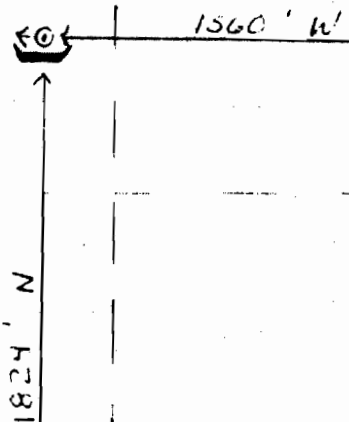

Township 8S Range 26E Section 8
Scale 1" = 660 FT