

Application No. 67313
Permit No. 52243


RECEIVED
JUL 19 1983
WATER RESOURCES DEPT
SALEM, OREGON

000007

40.08 40.13 40.18

4	3	2	1	4	3
40.13	39.98	39.82	39.67	39.51	39.32

TOWNSHIP 6N, RANGE 42E, SECTION 31, W.M.

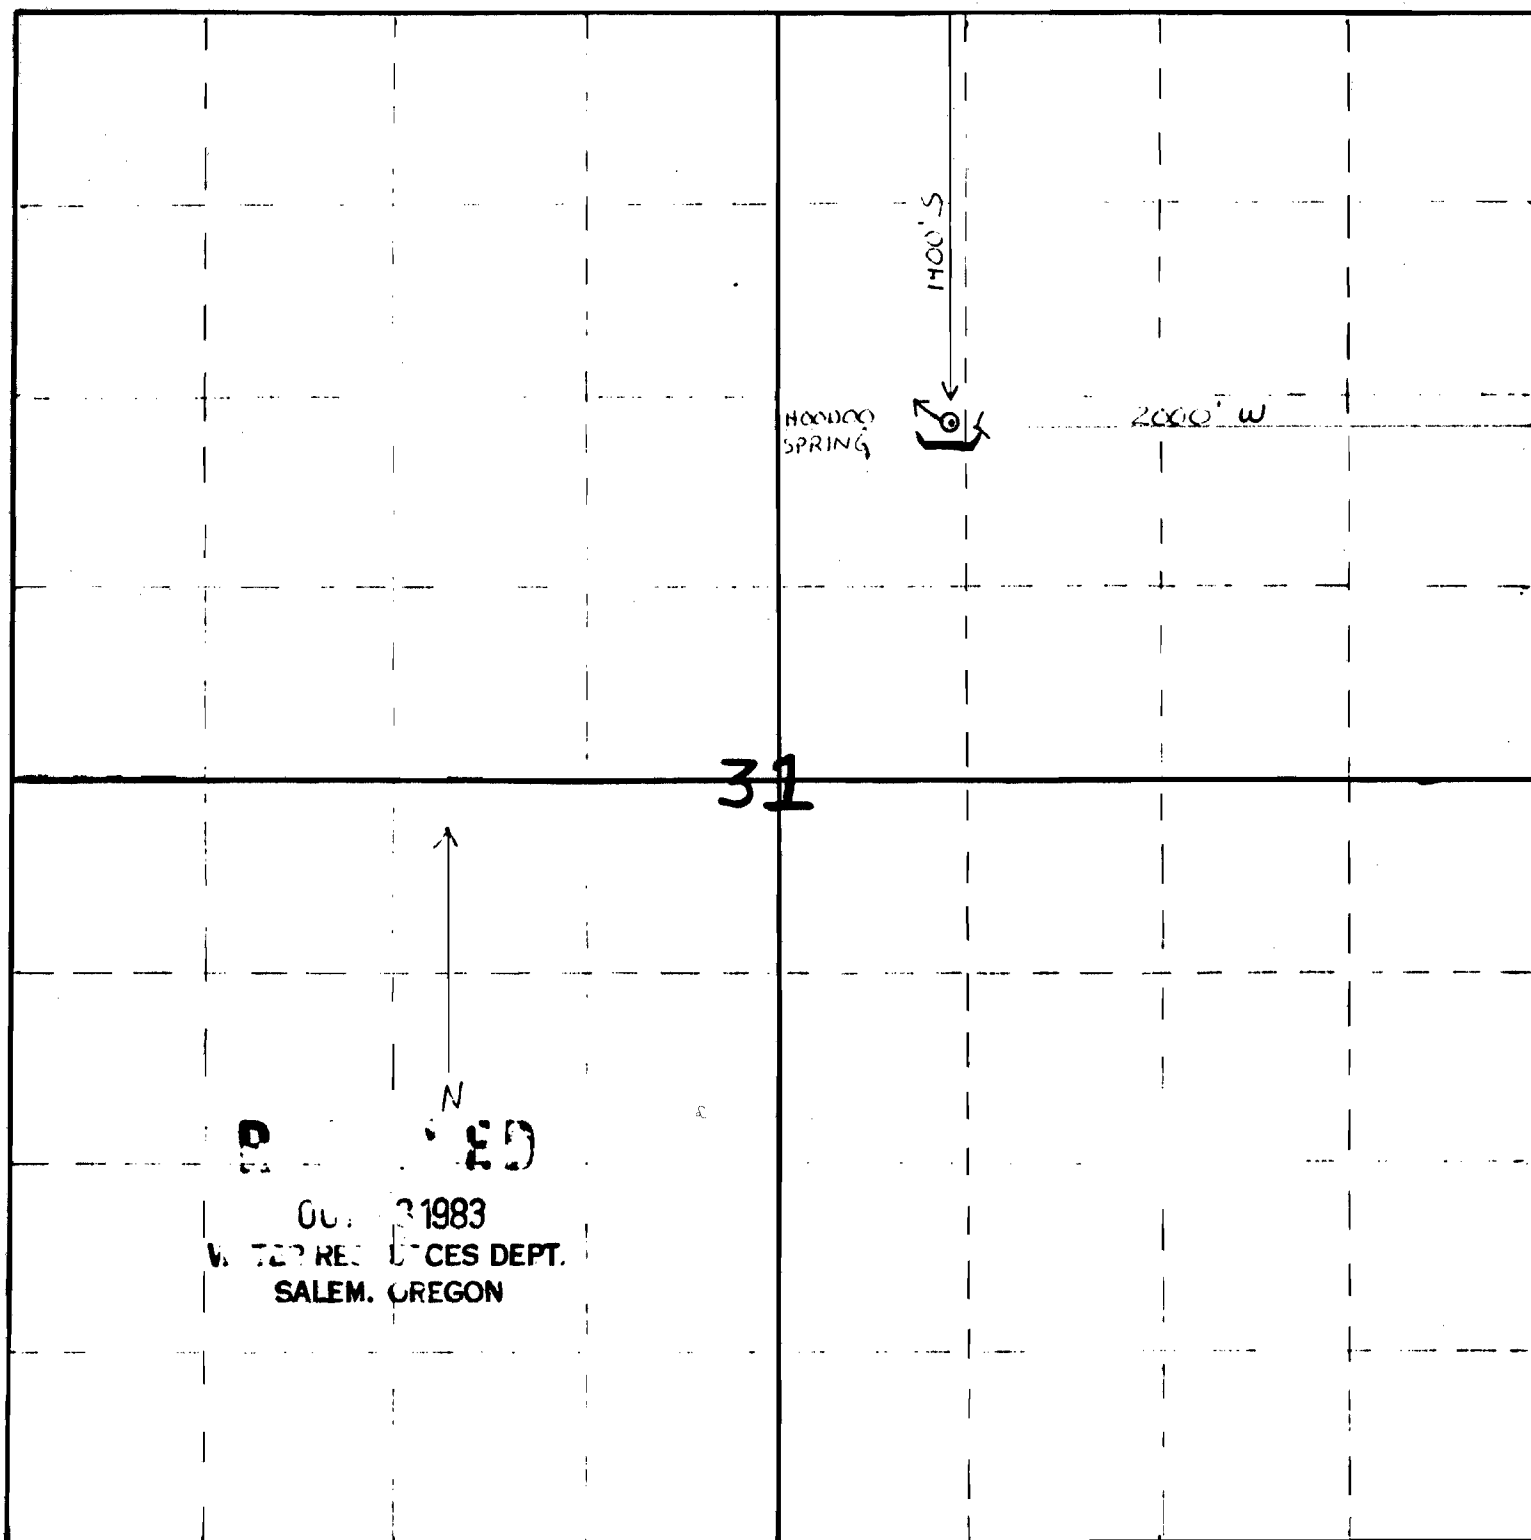

NAME Hoodoo Spring

COUNTY Walla Walla

DISTRICT Walla Walla

ALLOTMENT Eden

Application No. 67313

Scale 8 Inches = 1 Mile
Amended N.E.

Permit No.

