


TOWNSHIP 5N , RANGE 42E , SECTION 12 , W.M.

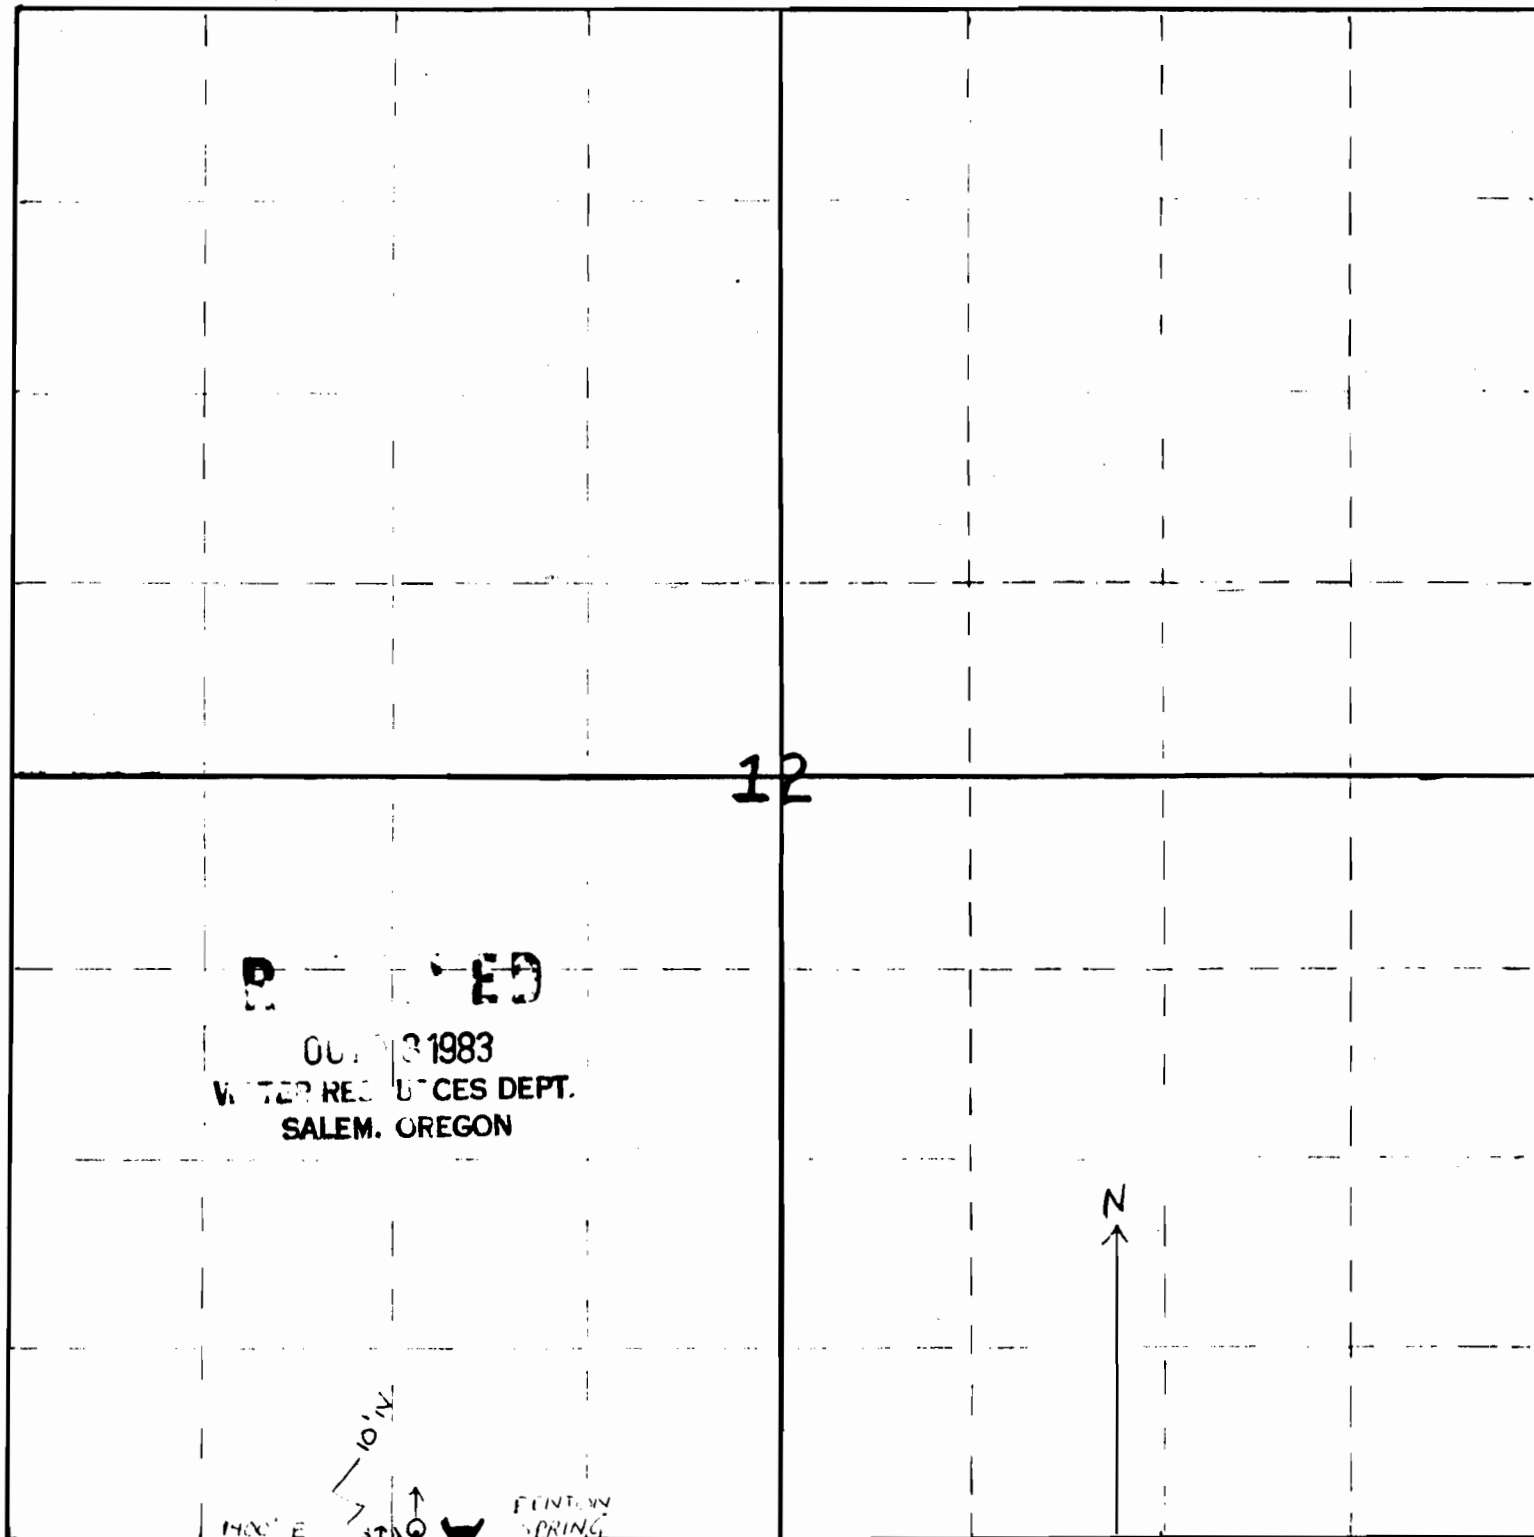

NAME *Fenton Spring*

COUNTY *Walla Walla*

DISTRICT *Walla Walla*

ALLOTMENT *Water*


Application No. *67311*

Scale 8 Inches = 1 Mile

Permit No.

Comments: *N 1*



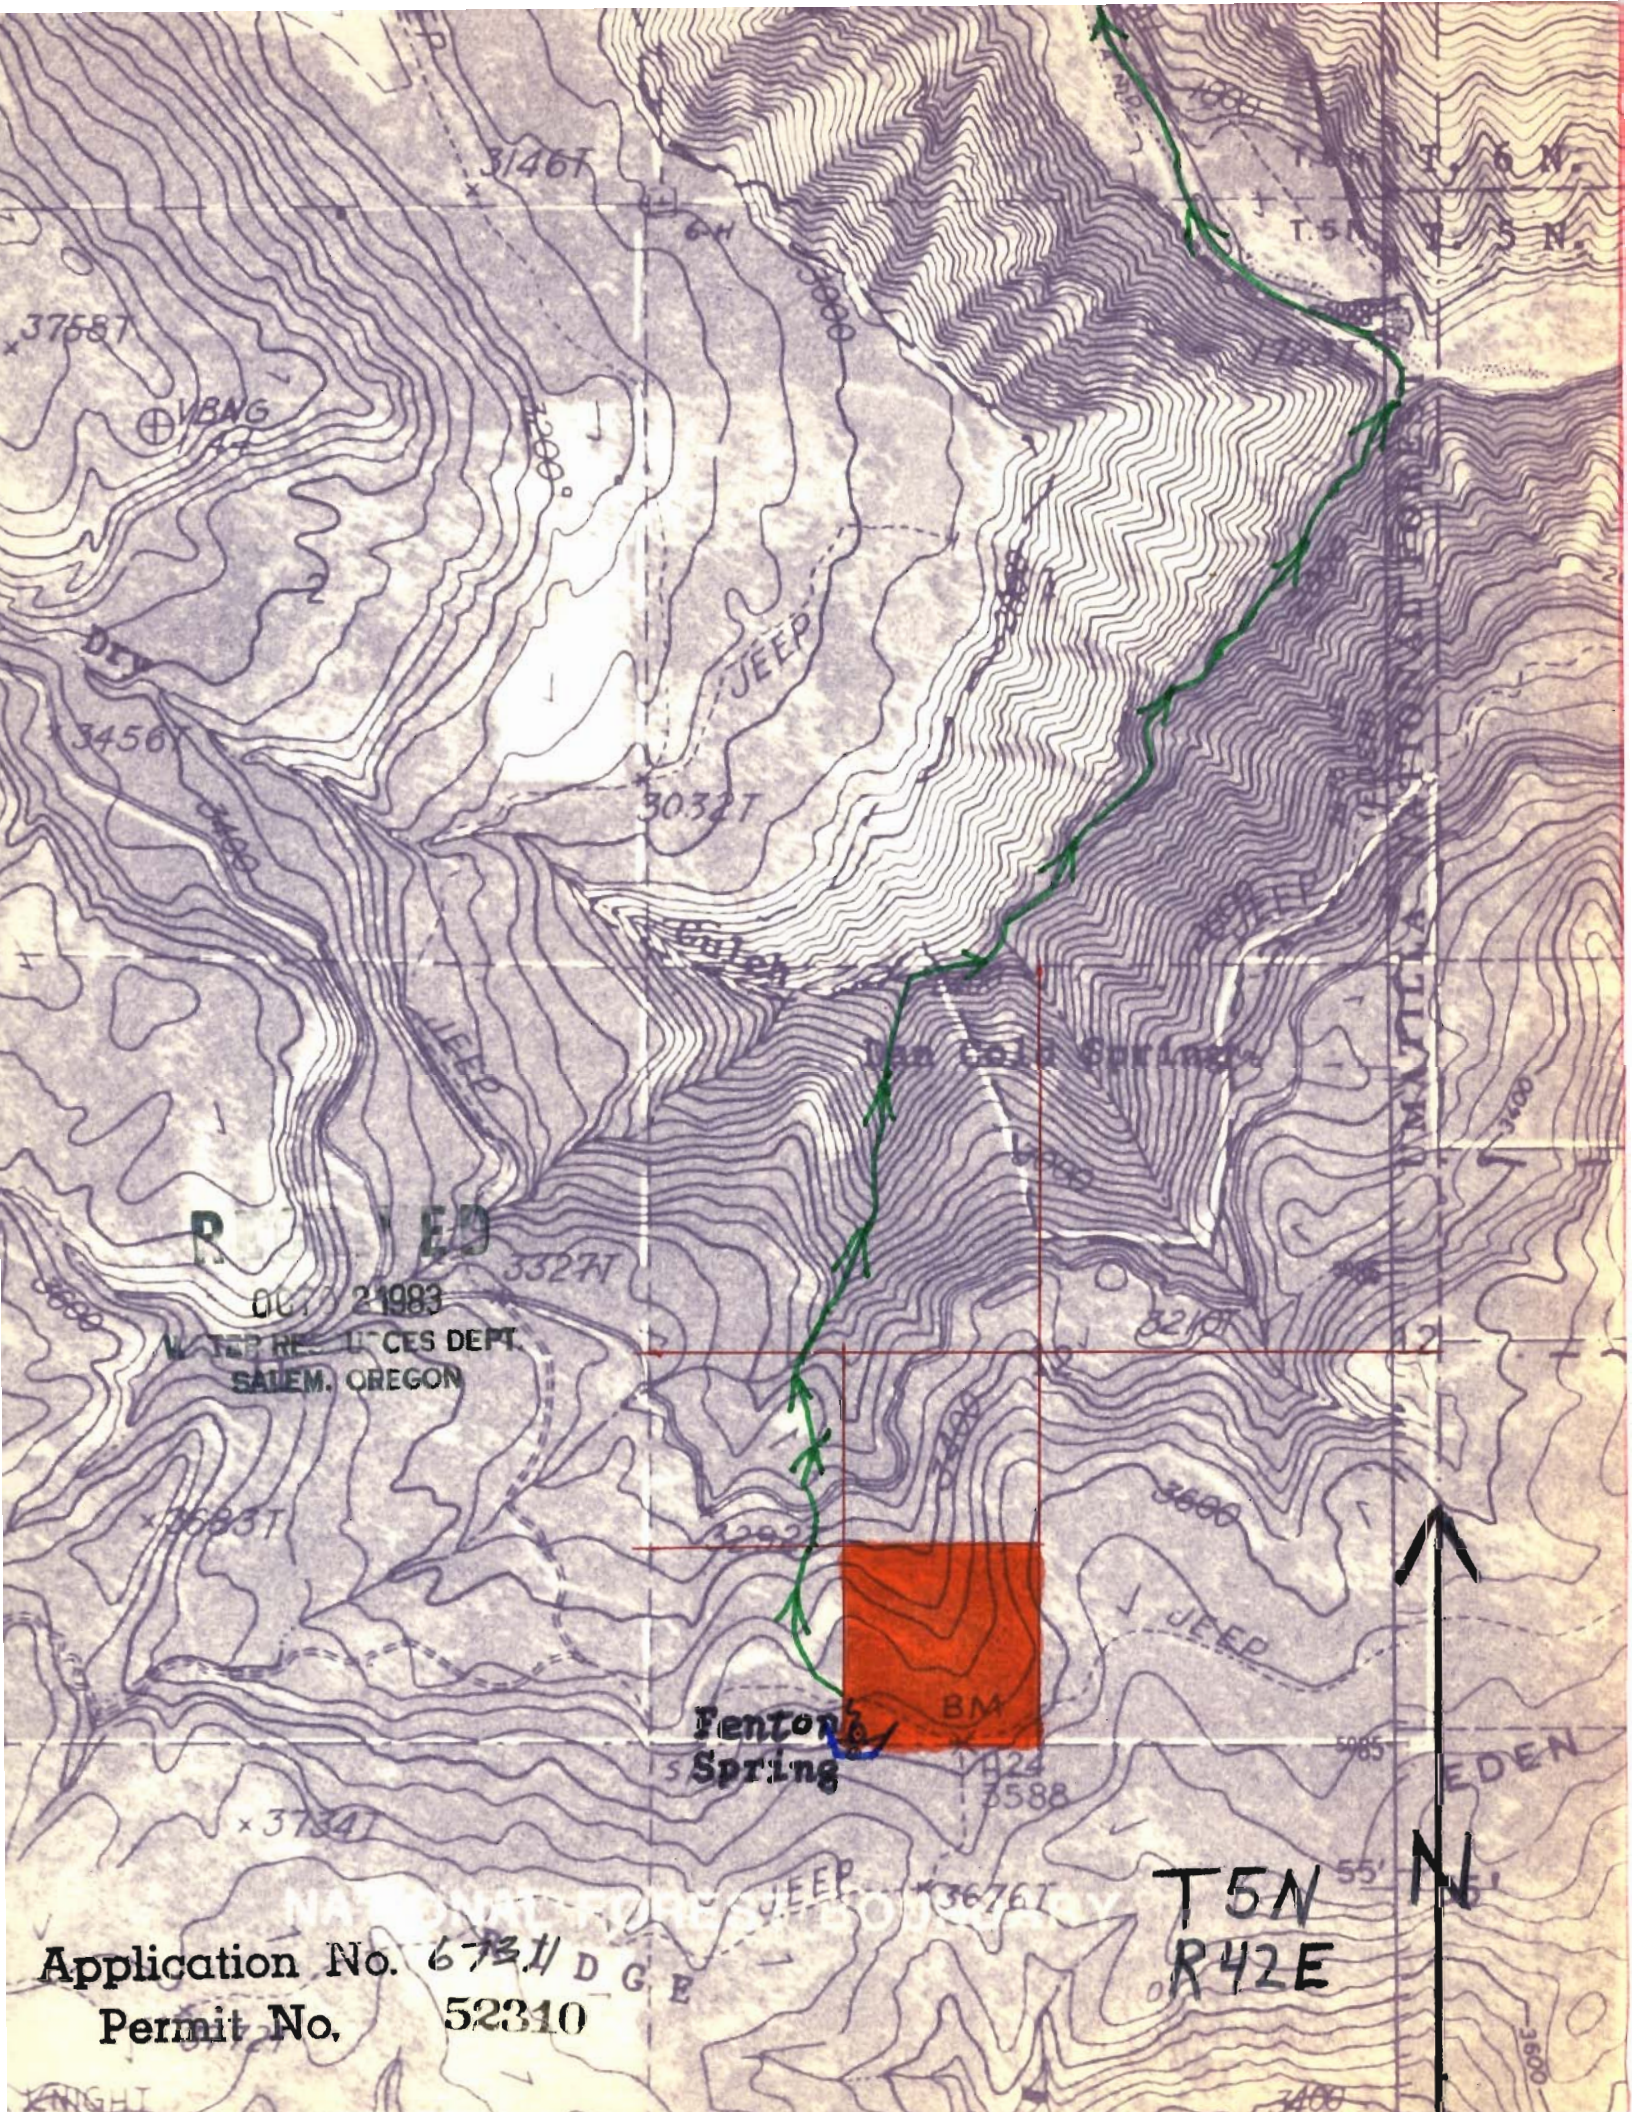

RECEIVED

06/17/21/83

WATER RESOURCES DEPT.  
SALEM, OREGON

Fenton  
Spring

BM

424  
3588

Application No. 6731/DGE  
Permit No. 52310

T 5 N  
R 42 E