


RECEIVED

SEP 11 1981

WATER RESOURCES DEPT
SALEM, OREGON

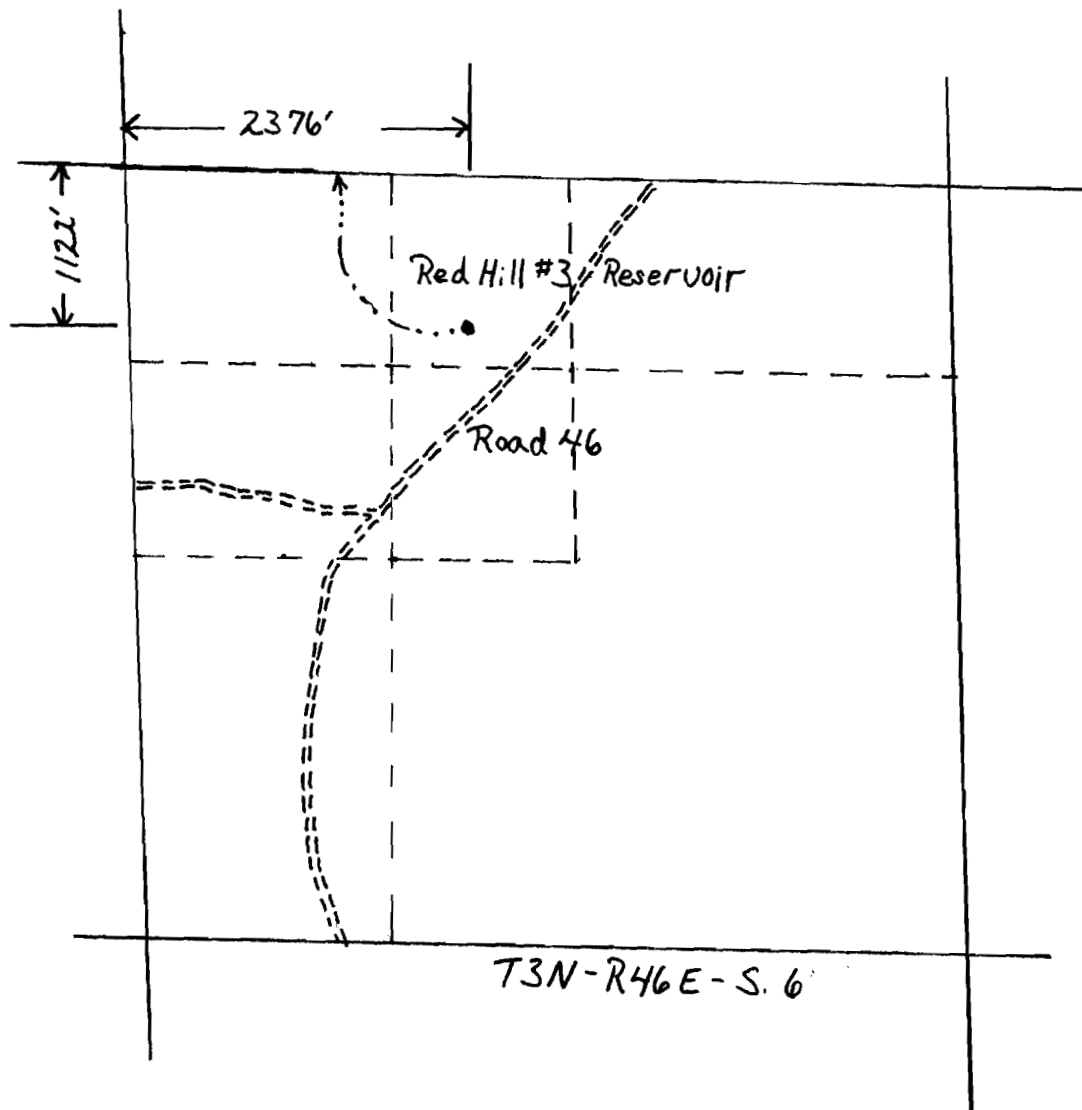

4 inches = 1 mile

Application No. R-62652
Permit No. R 8413