


RECEIVED

SEP 11 1981

WATER RESOURCES DEPT
SALEM, OREGON

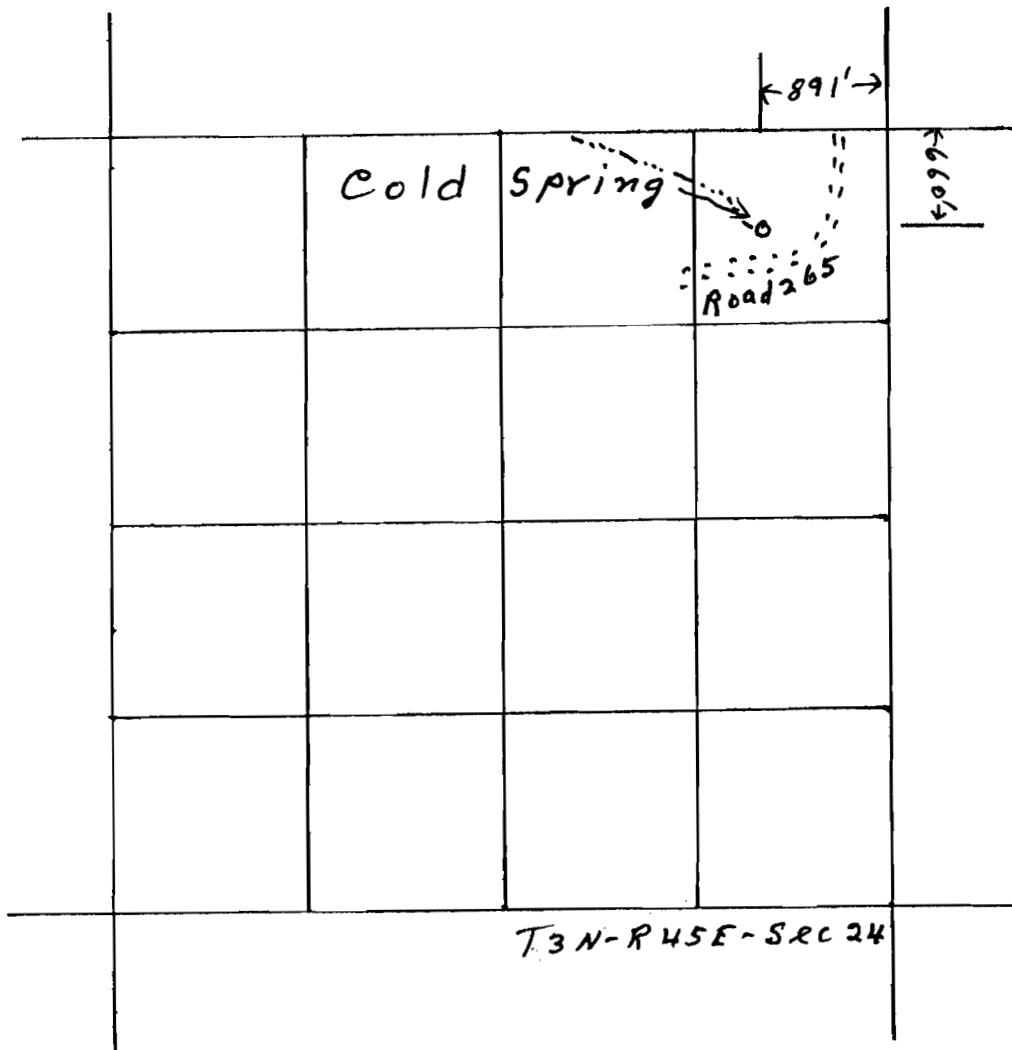

Application No. 12-62654

R 8415

Permit No.

2 1/4 inches = 1 mile