


RECEIVED

SEP 11 1981

WATER RESOURCES DEPT
SALEM, OREGON

↑
N

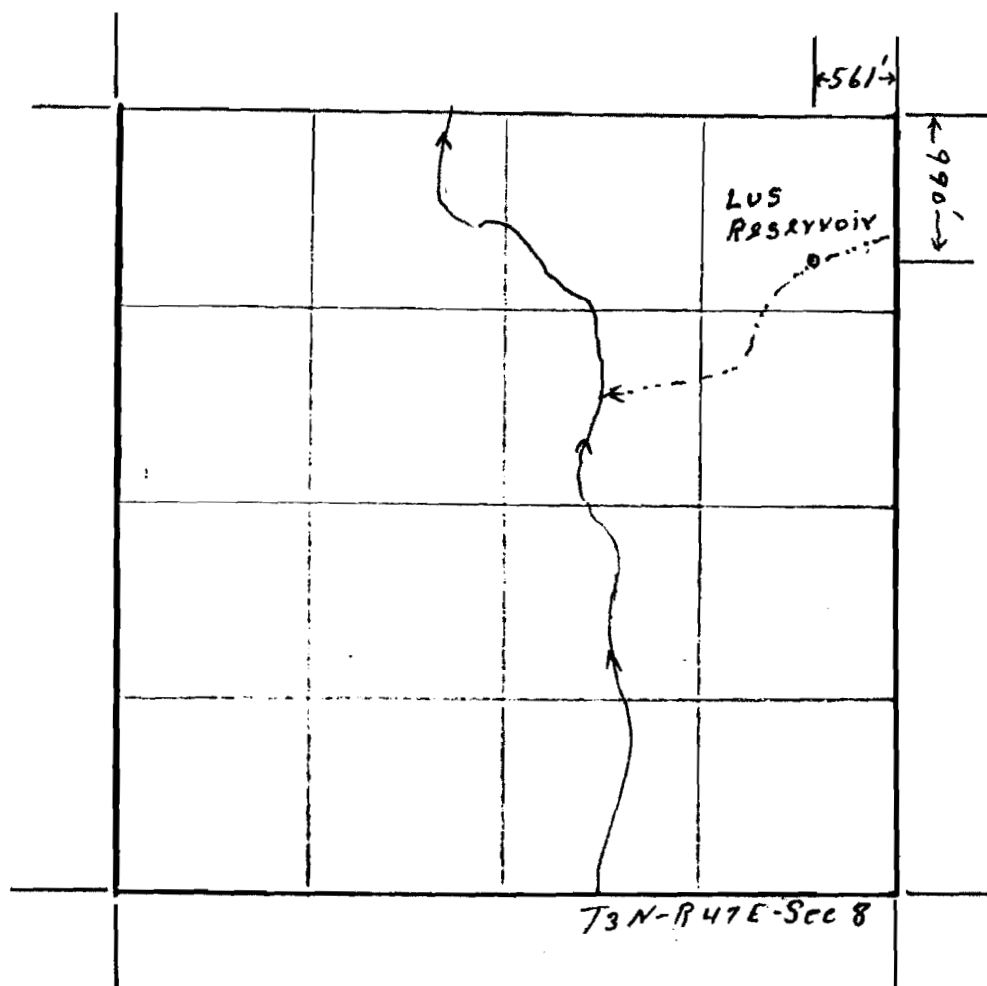

4 Inches = 1 Mile

Application No. 62662
Permit No. R 8423