


COLD SPRING and STOCK POND

RECEIVED

AUG 12 1981

WATER RESOURCES DEPT
SALEM, OREGON

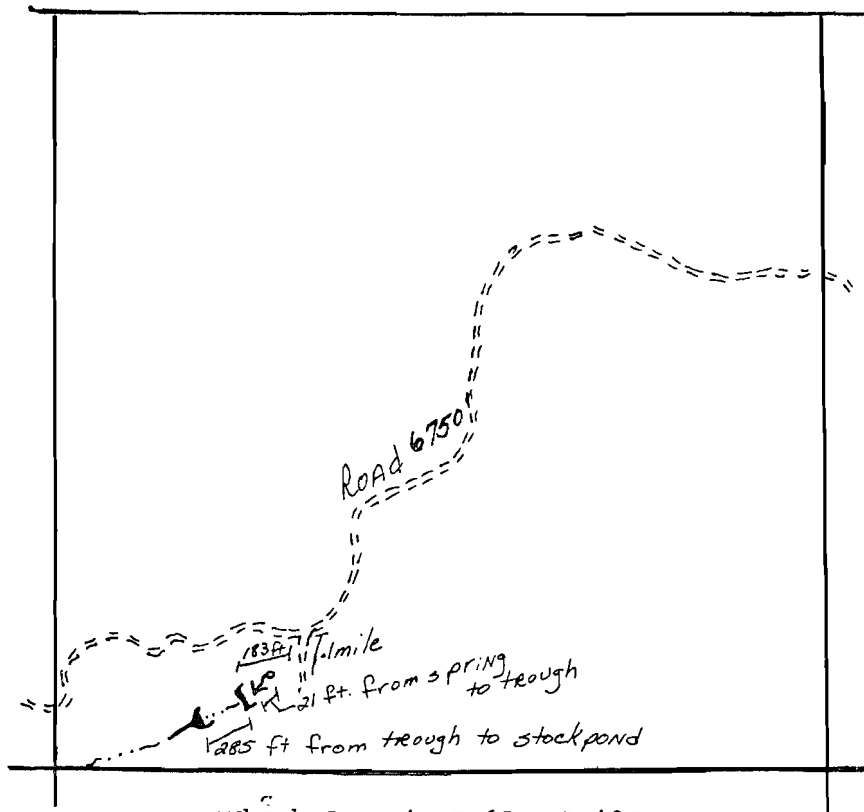

SW $\frac{1}{4}$ SW $\frac{1}{4}$ Sec. 4, T.6S., R.42E.

Water Trough



Spring Head




Reservoir



Drainage



Road

 

Application No. 62227
Permit No.

R 9008

Four Inches = One Mile

