


AUG 12 1981

MUD SPRING

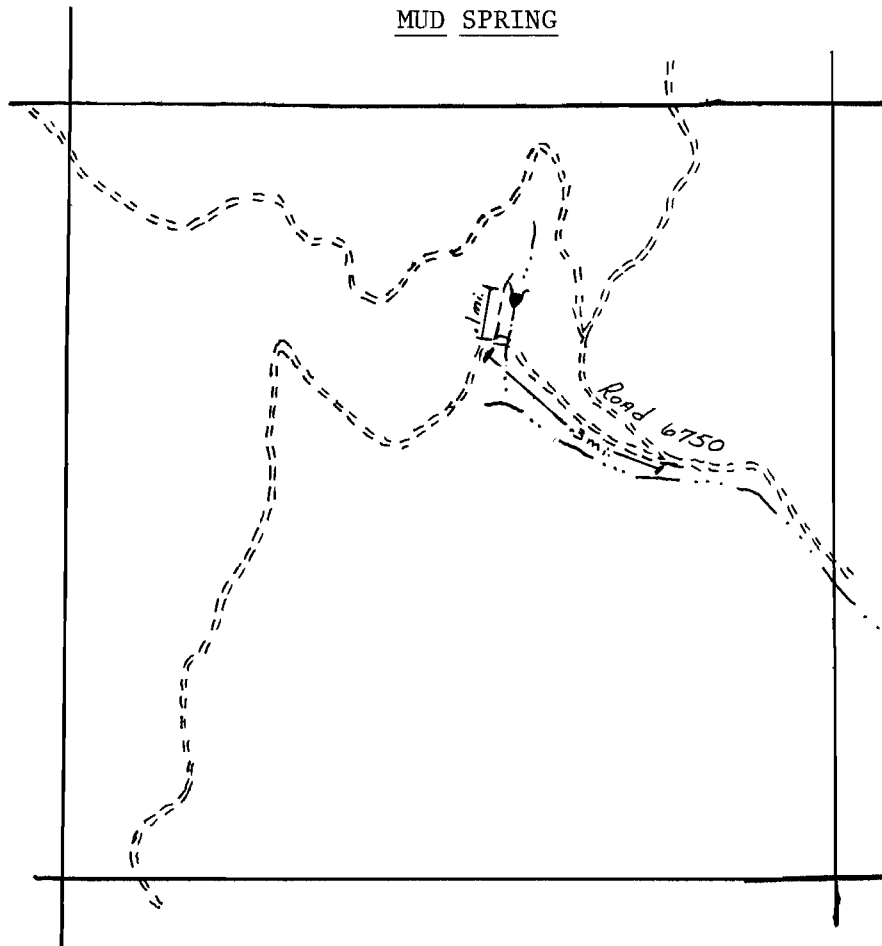

NW $\frac{1}{4}$ NE $\frac{1}{4}$ Sec. 8, T.6S., R.42E.

LEDGEND


Stock Pond




Drainage



Road

 

Four Inches = One Mile

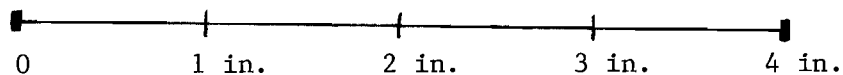

Application No. R-62228
Permit No. R 9009