


RECEIVED

AUG 12 1981

WATER RESOURCES DEPT
SALEM, OREGON

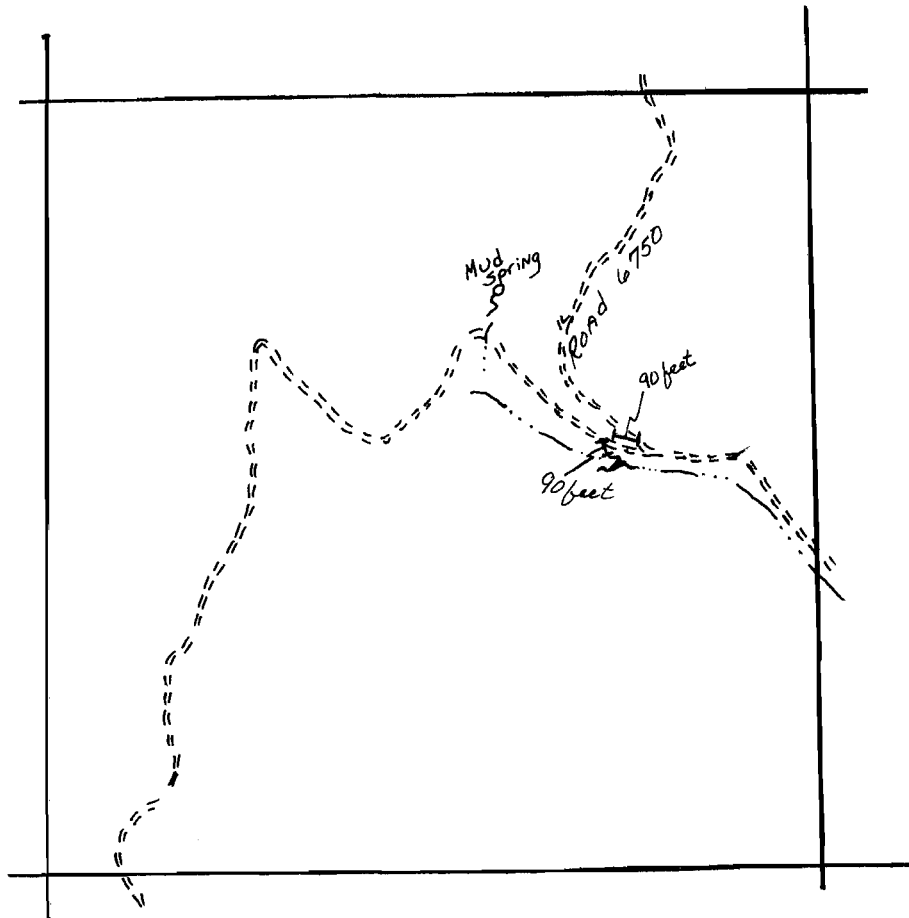

SW $\frac{1}{4}$ NE $\frac{1}{4}$ Sec. 8, T.6S., R.42E.

LEDGEND


Stock Pond




Drainage



Road

 

Four Inches = One Mile

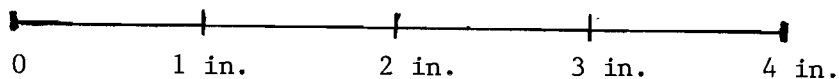

Application No. ~~R-62239~~ R-62231
Permit No. R 9010