




Agreement No. **R66307**
Project No. **R 9897**

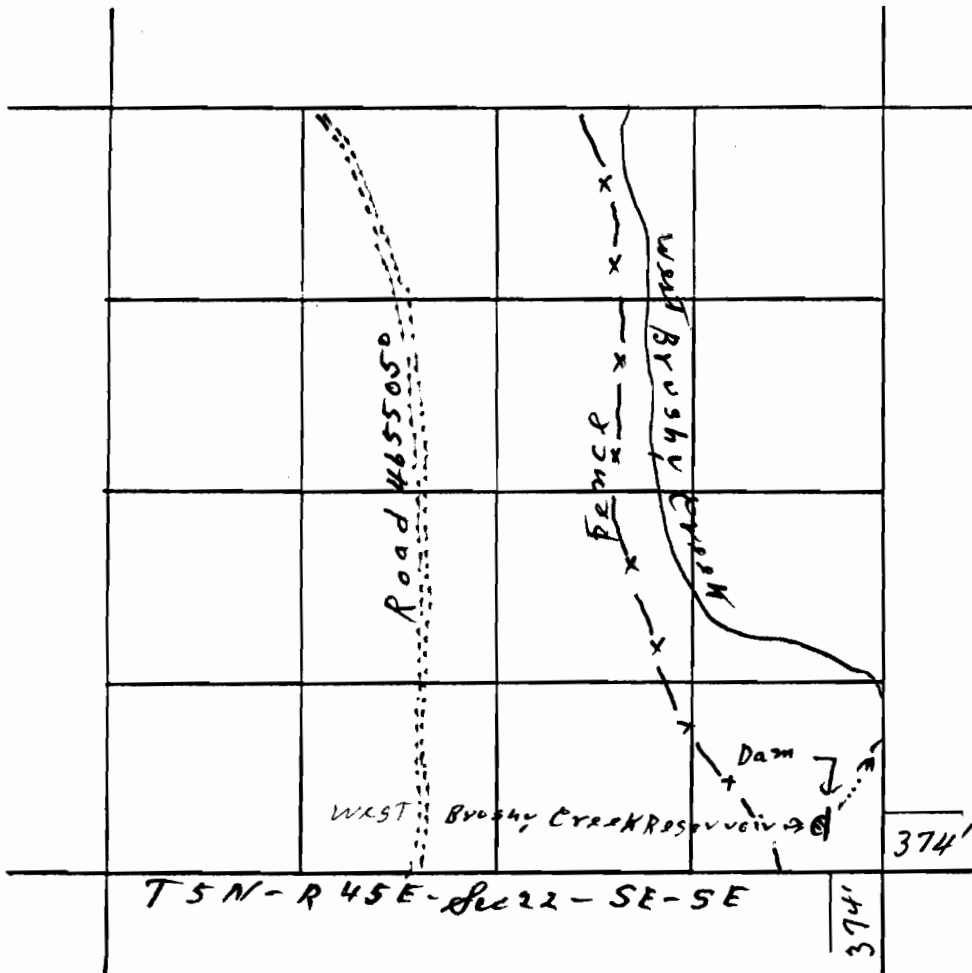

4 inches = 1 mile

RECEIVED
SEP 9 1983
LAND RECORDS DEPT.
SALEM, OREGON