


Broady Spring Reservoir



Application No. R-66308
Permit No. R 9898

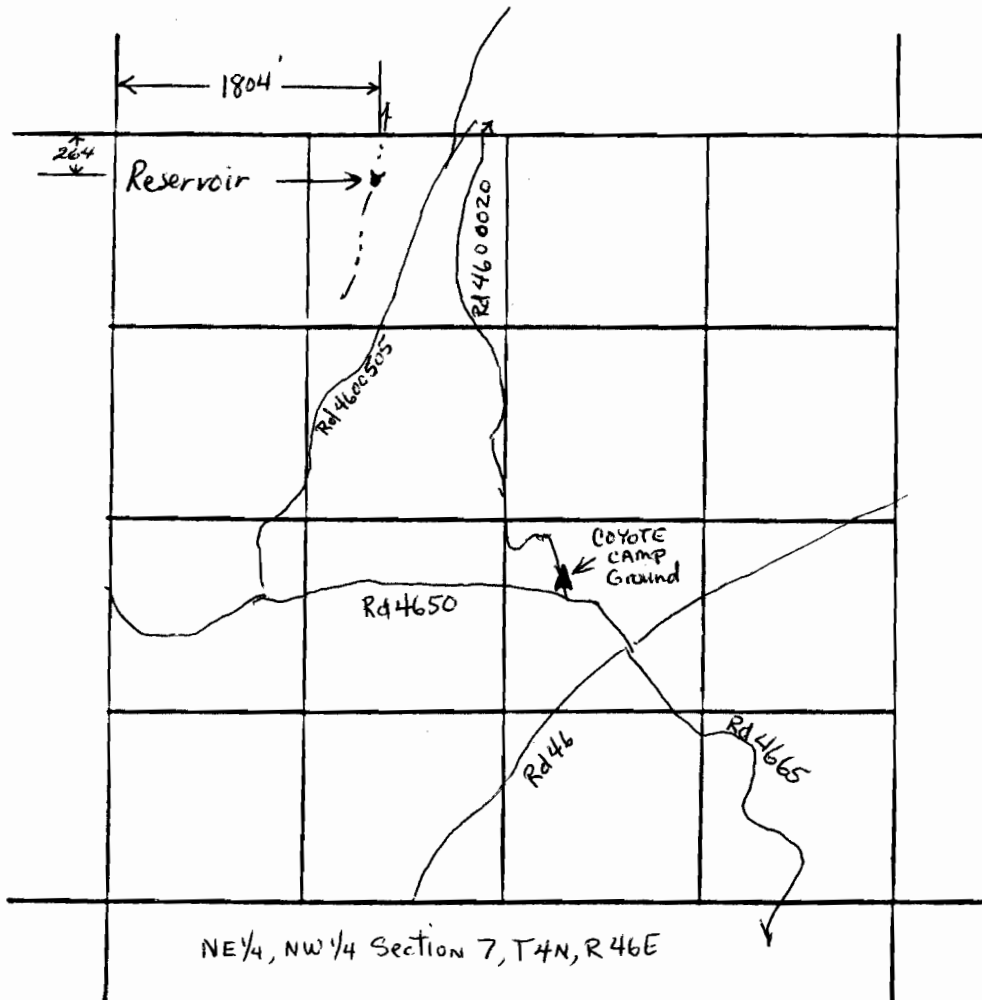

4 inches = 1 mile

RECEIVED
SEP 9 1993
WATER RESOURCES DEPT.
SALEM, OREGON