


N

Application No. R-66309
Permit No. R 9899

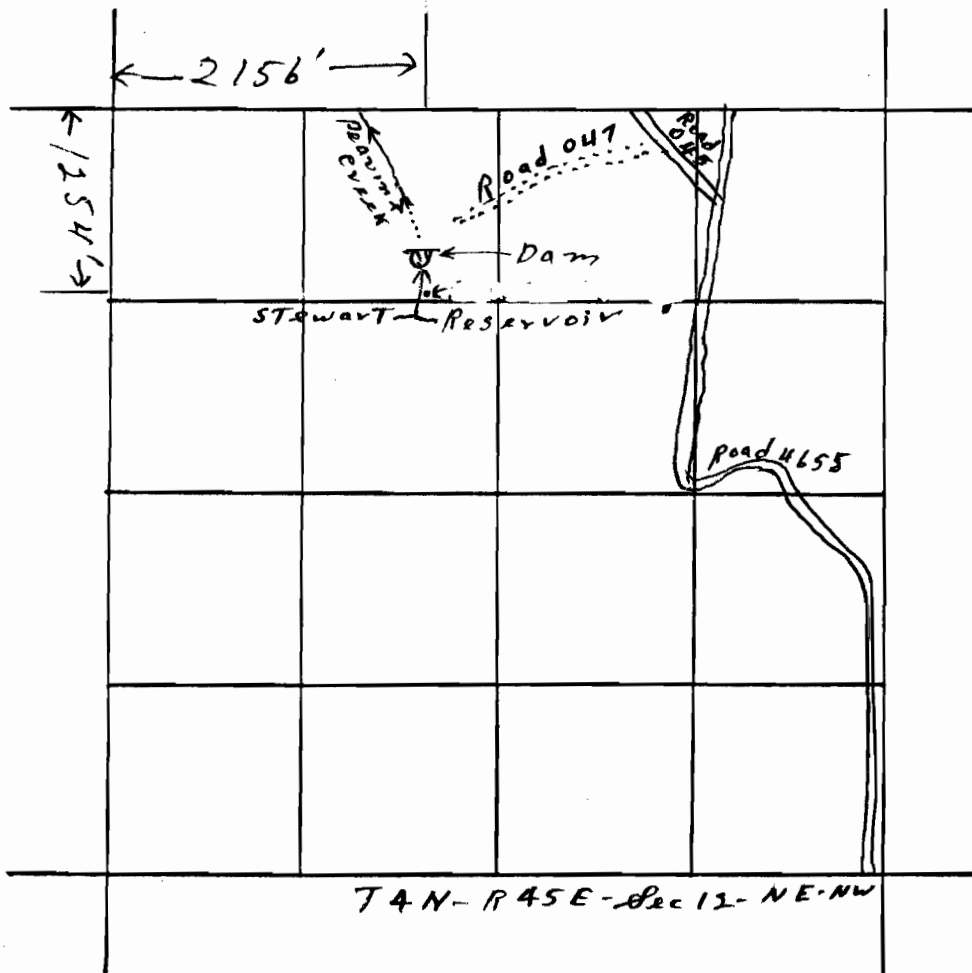

4 inches = 1 mile

RECEIVED
SEP 19 1983
SALEM, OREGON