


Application No. R63898  
Permit No. R 9940

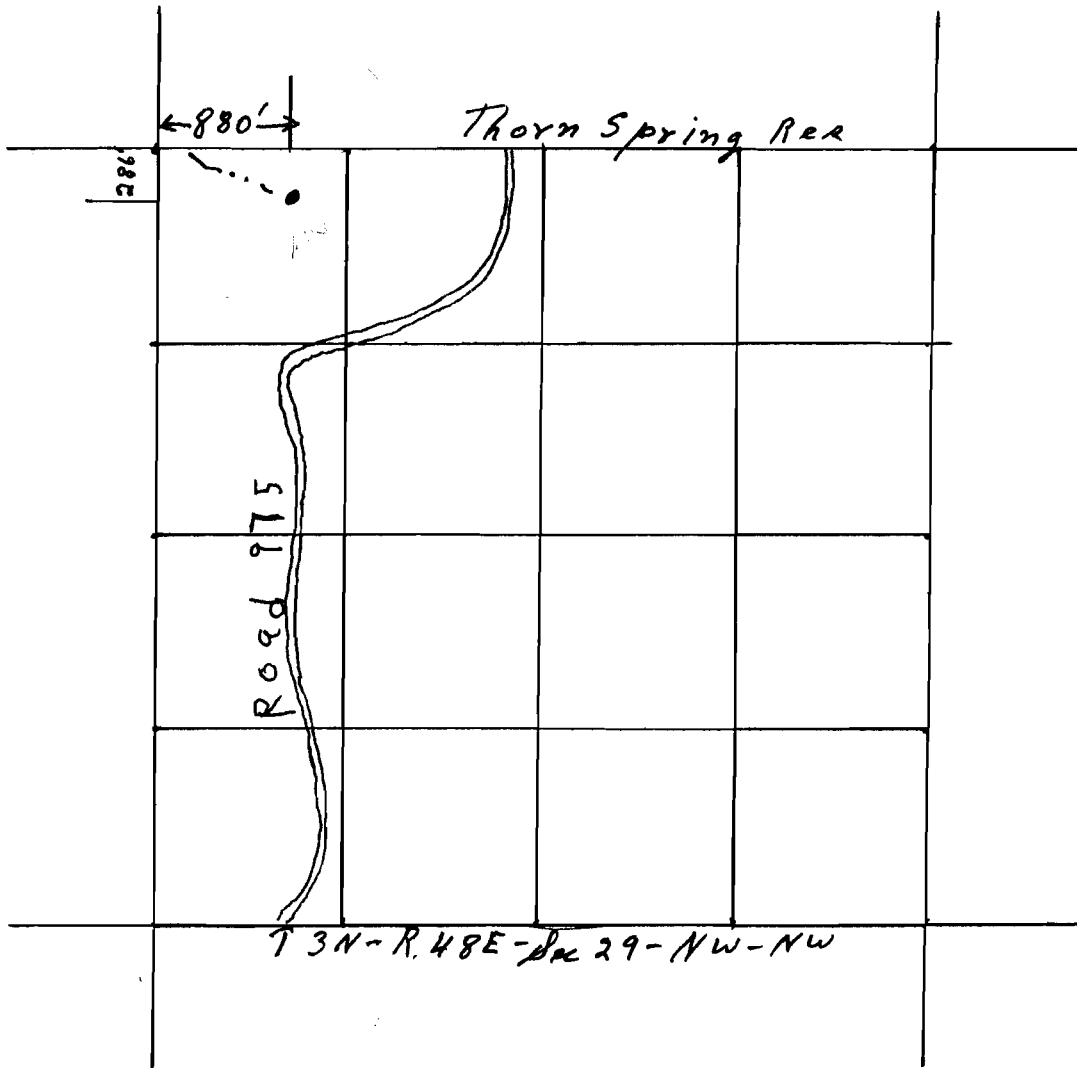

RECEIVED

AUG 19 1982

WATER RESOURCES  
SALEM, OREGON

4 inches = 1 mile