
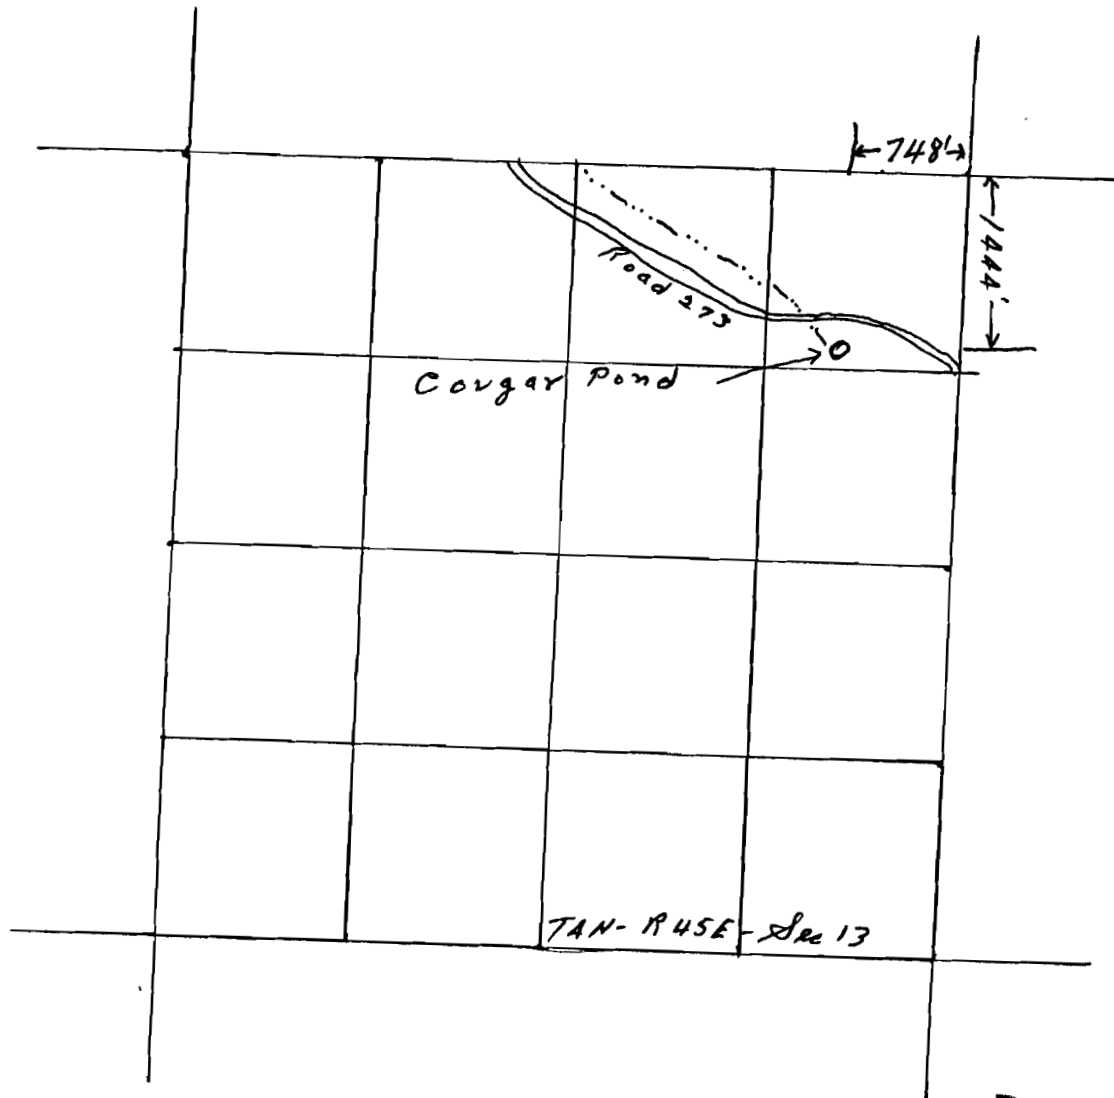


Application No. R63879
Permit No. R 9941

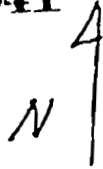

RECEIVED

AUG 19 1982

WATER RESOURCES DIV.
SALEM, OREGON

4 inches = 1 mile