


Application No. 063900
Permit No. R 9942

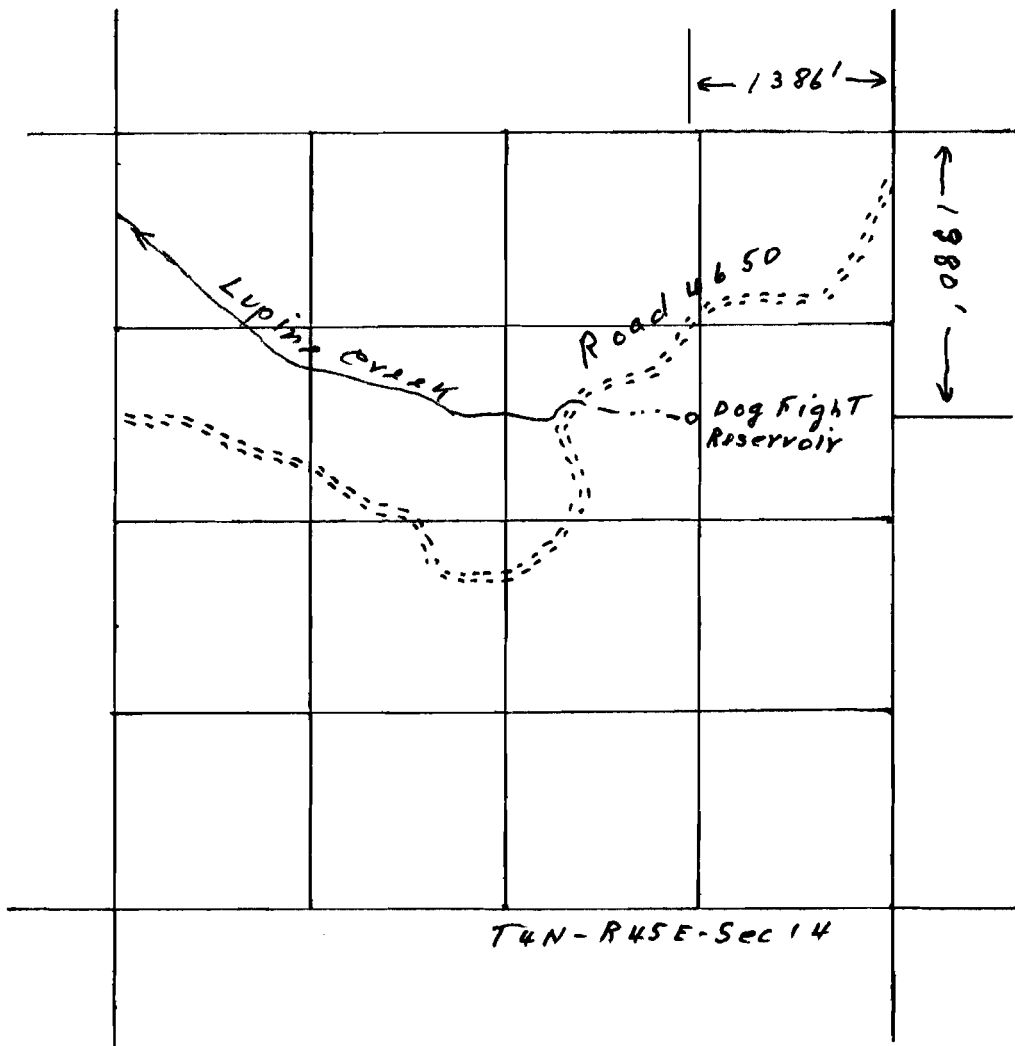

4 inches = 1 mile

RECEIVED

AUG 19 1982

WATER RESOURCES DEPT.
SALEM, OREGON