


R 9944

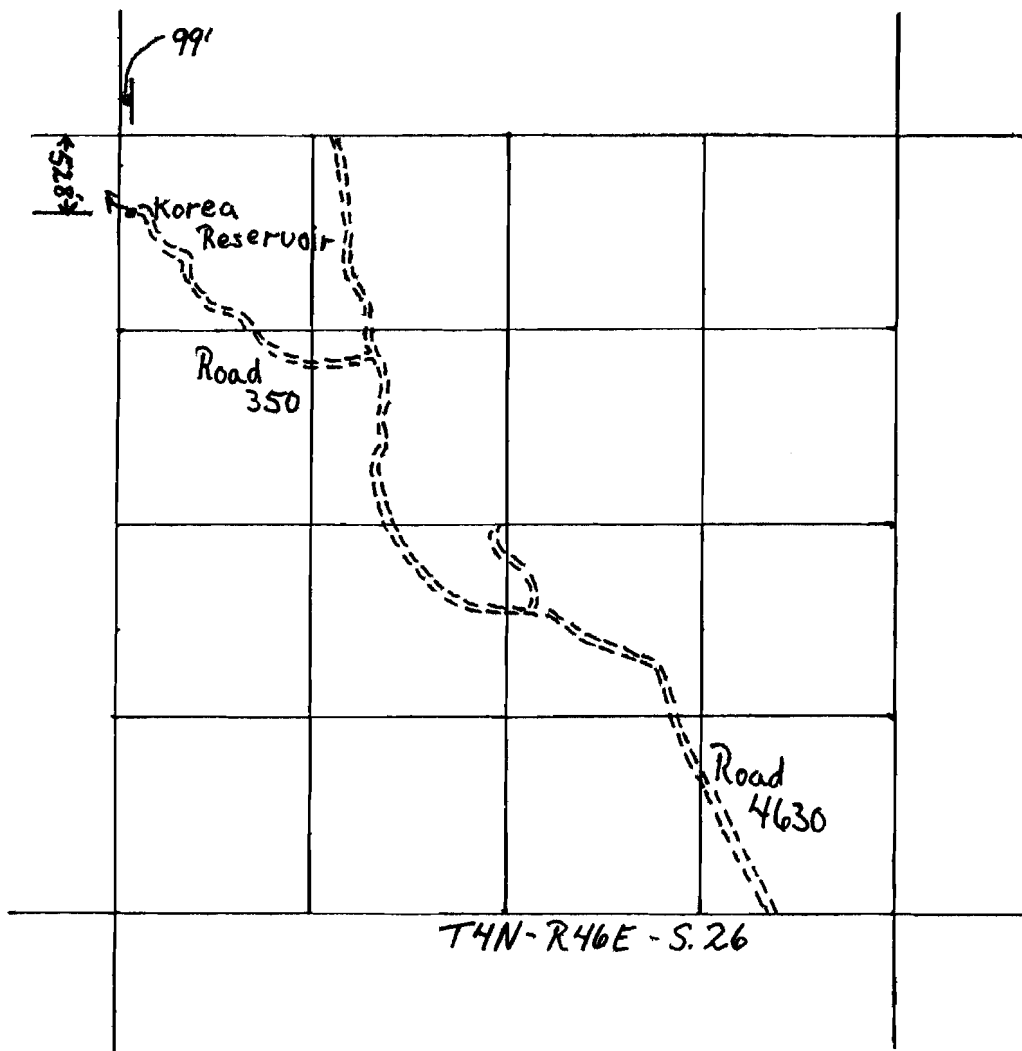

RECEIVED

AUG 19 1982

**WATER RESOURCES DEPT.
SALEM, OREGON**

4 inches = 1 mile