


Application No. R63903
Permit No. R 9945

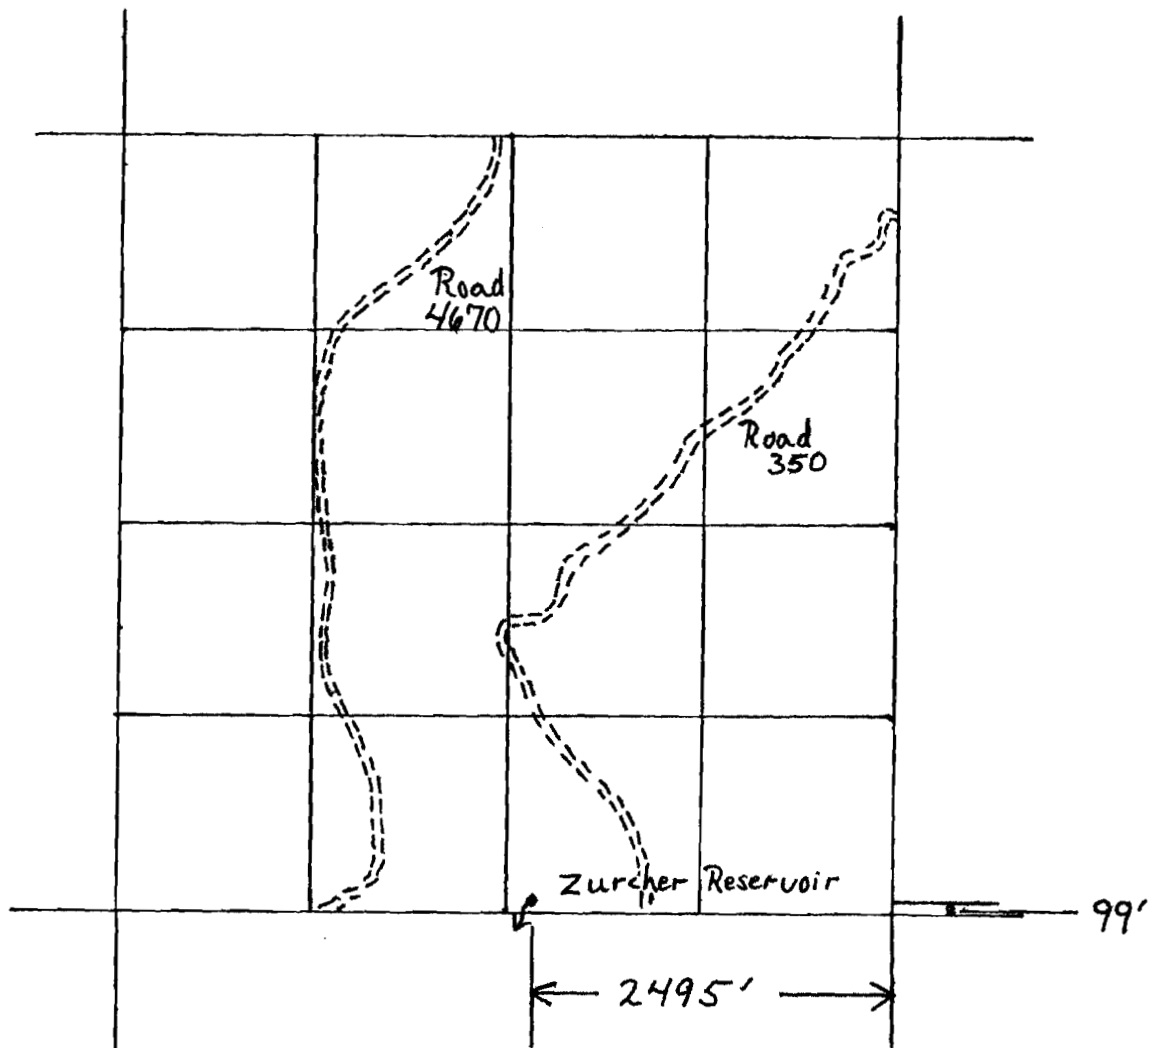

RECEIVED

AUG 19 1982

WATER RESOURCES DEPT.
SALEM, OREGON

4 inches = 1 mile

T 4N, R 46E, S 10N, E 7